


0374_891

MICROFILMED

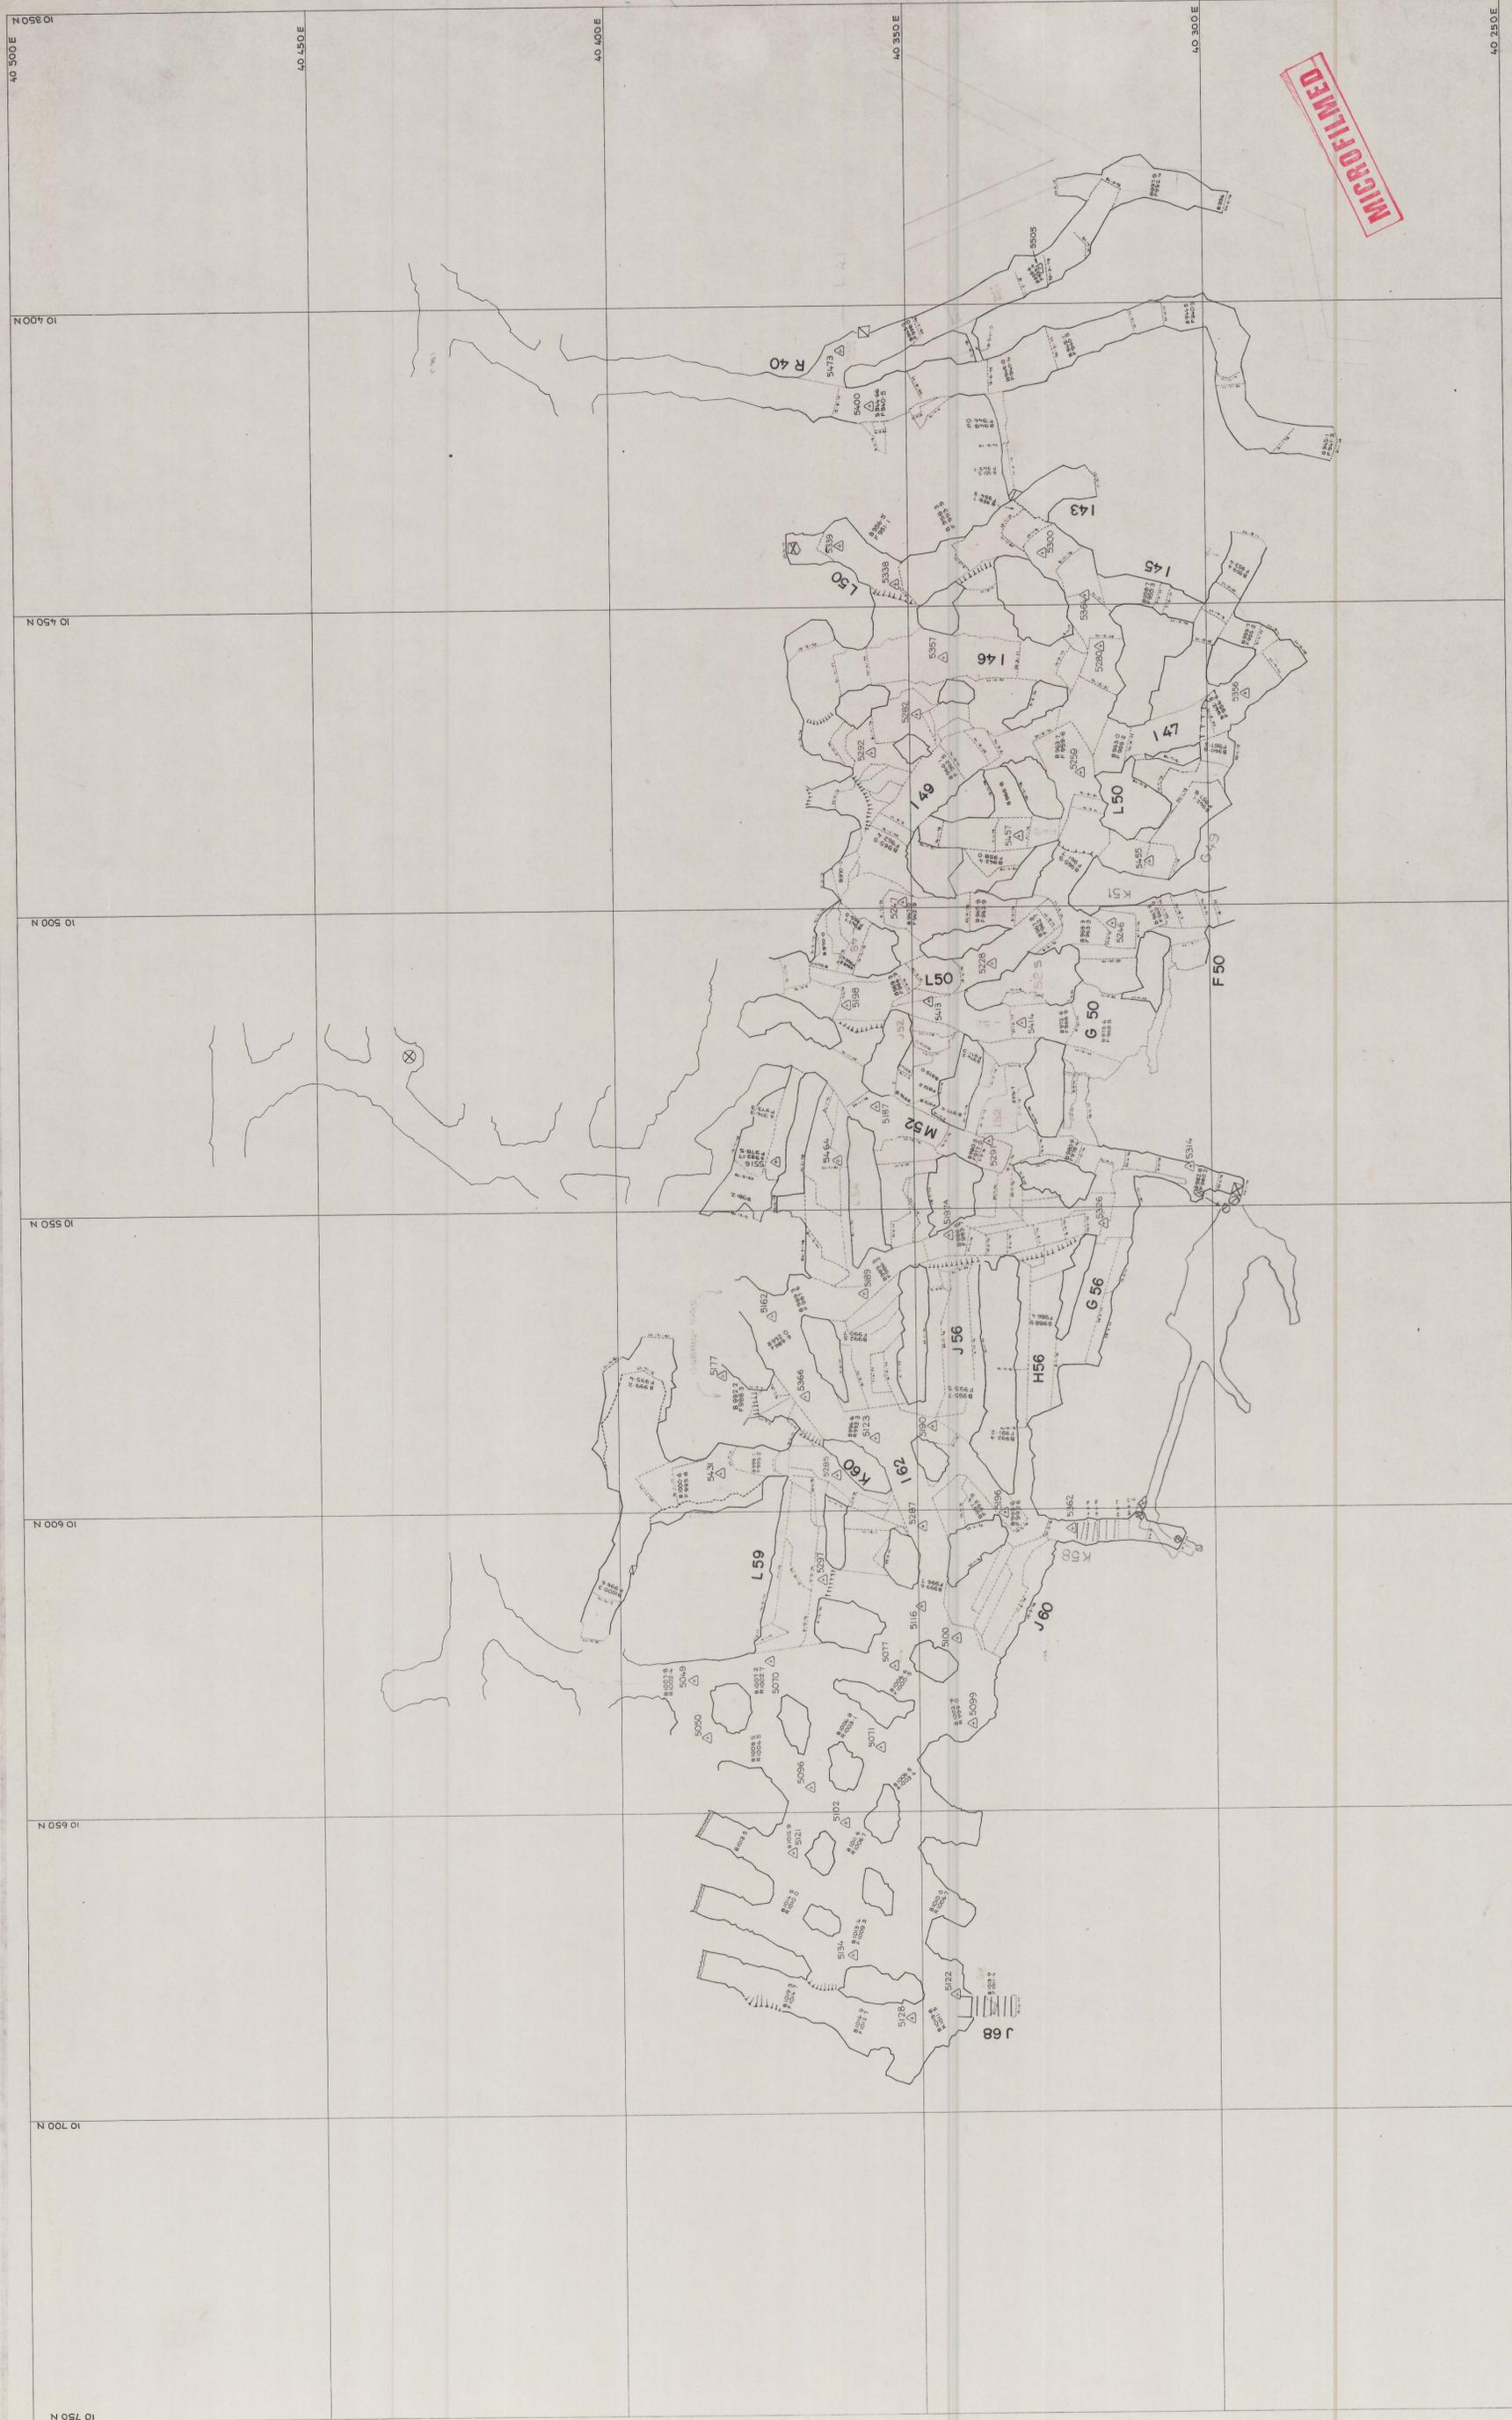

KIS KING ISLAND SCHEELITE
 A DIVISION OF WARRIOR INTERNATIONAL
 GRASSY KING ISLAND
 PLANT NUMBER 04BH15-1004
 78089

LOCATION BOLD HEAD MINE
 SUBJECT B LENS MAIN STOPES

SCALE 1:500
 north
 5 cm

0374_891

44 256/27