



0374\_964

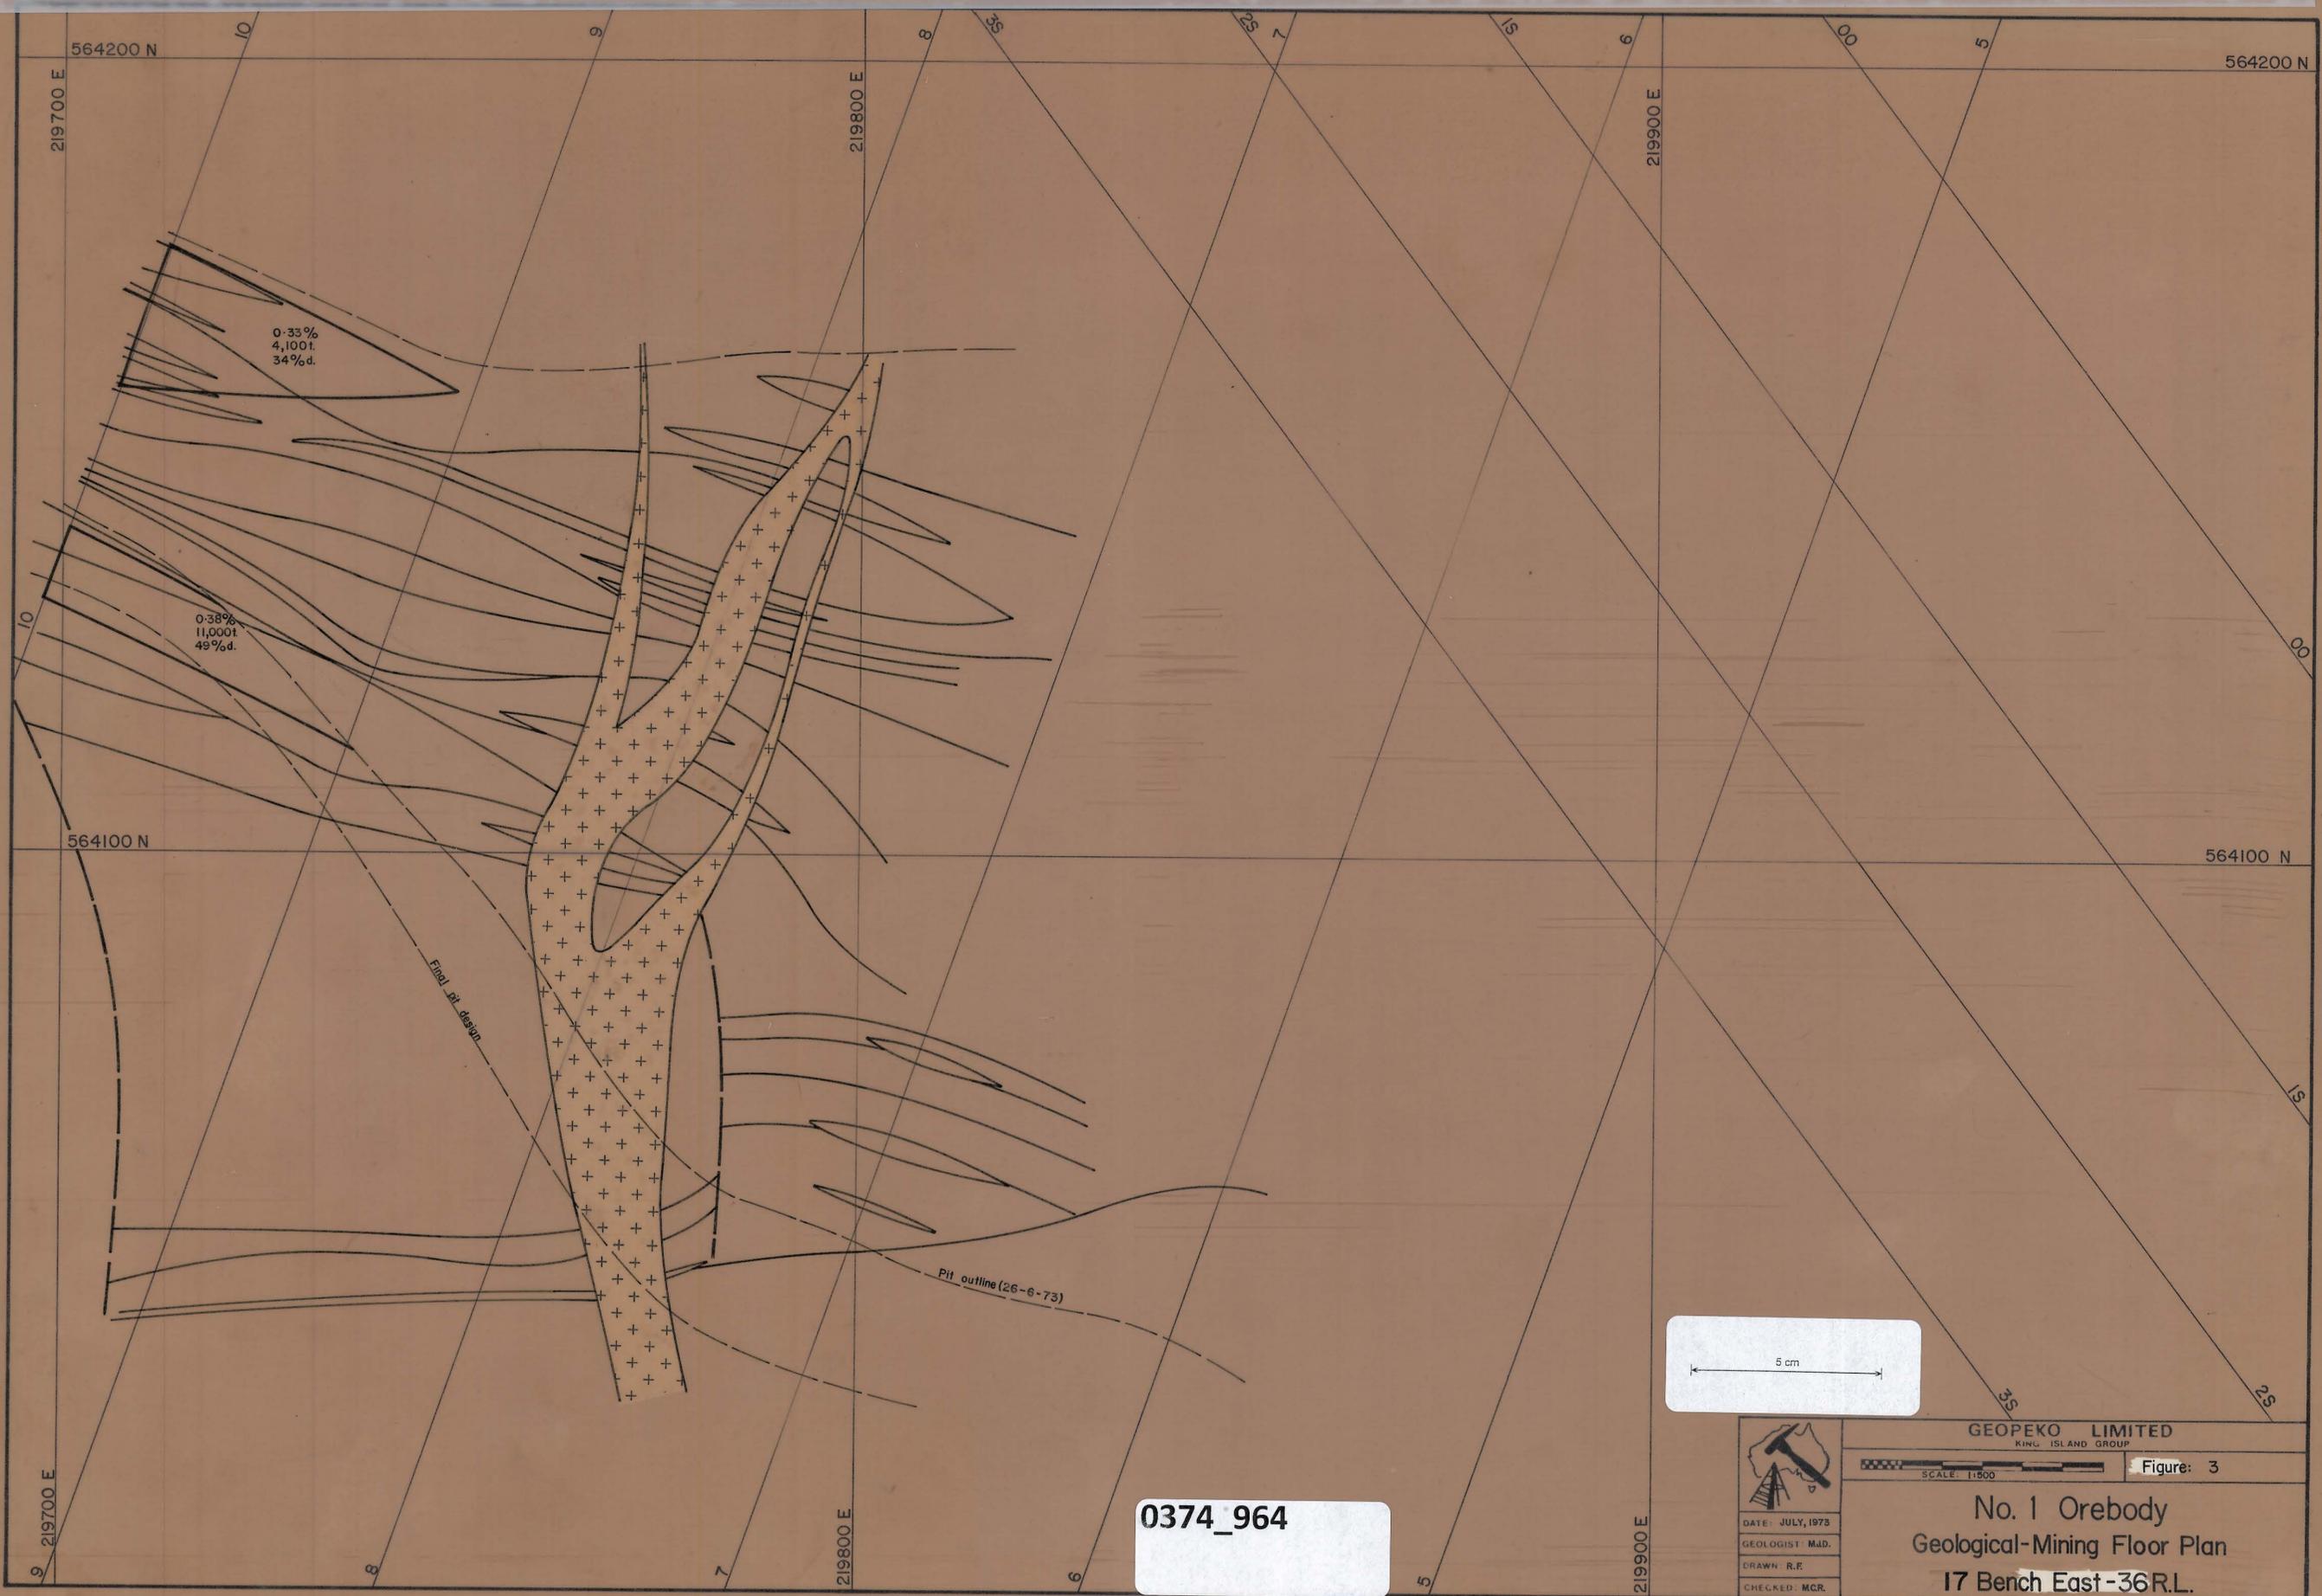

0374\_964

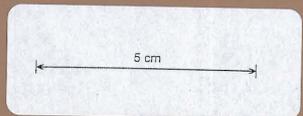

DATE: JULY, 1978  
GEOLOGIST: MLD.  
DRAWN: R.E.  
CHECKED: MCR.

GEOPEKO LIMITED  
KING ISLAND GROUP

SCALE: 1:500

Figure: 3

No. 1 Orebody  
Geological-Mining Floor Plan  
17 Bench East -36R.L.