


0374\_993

For Construction - See Drawings No. KG2-01-011

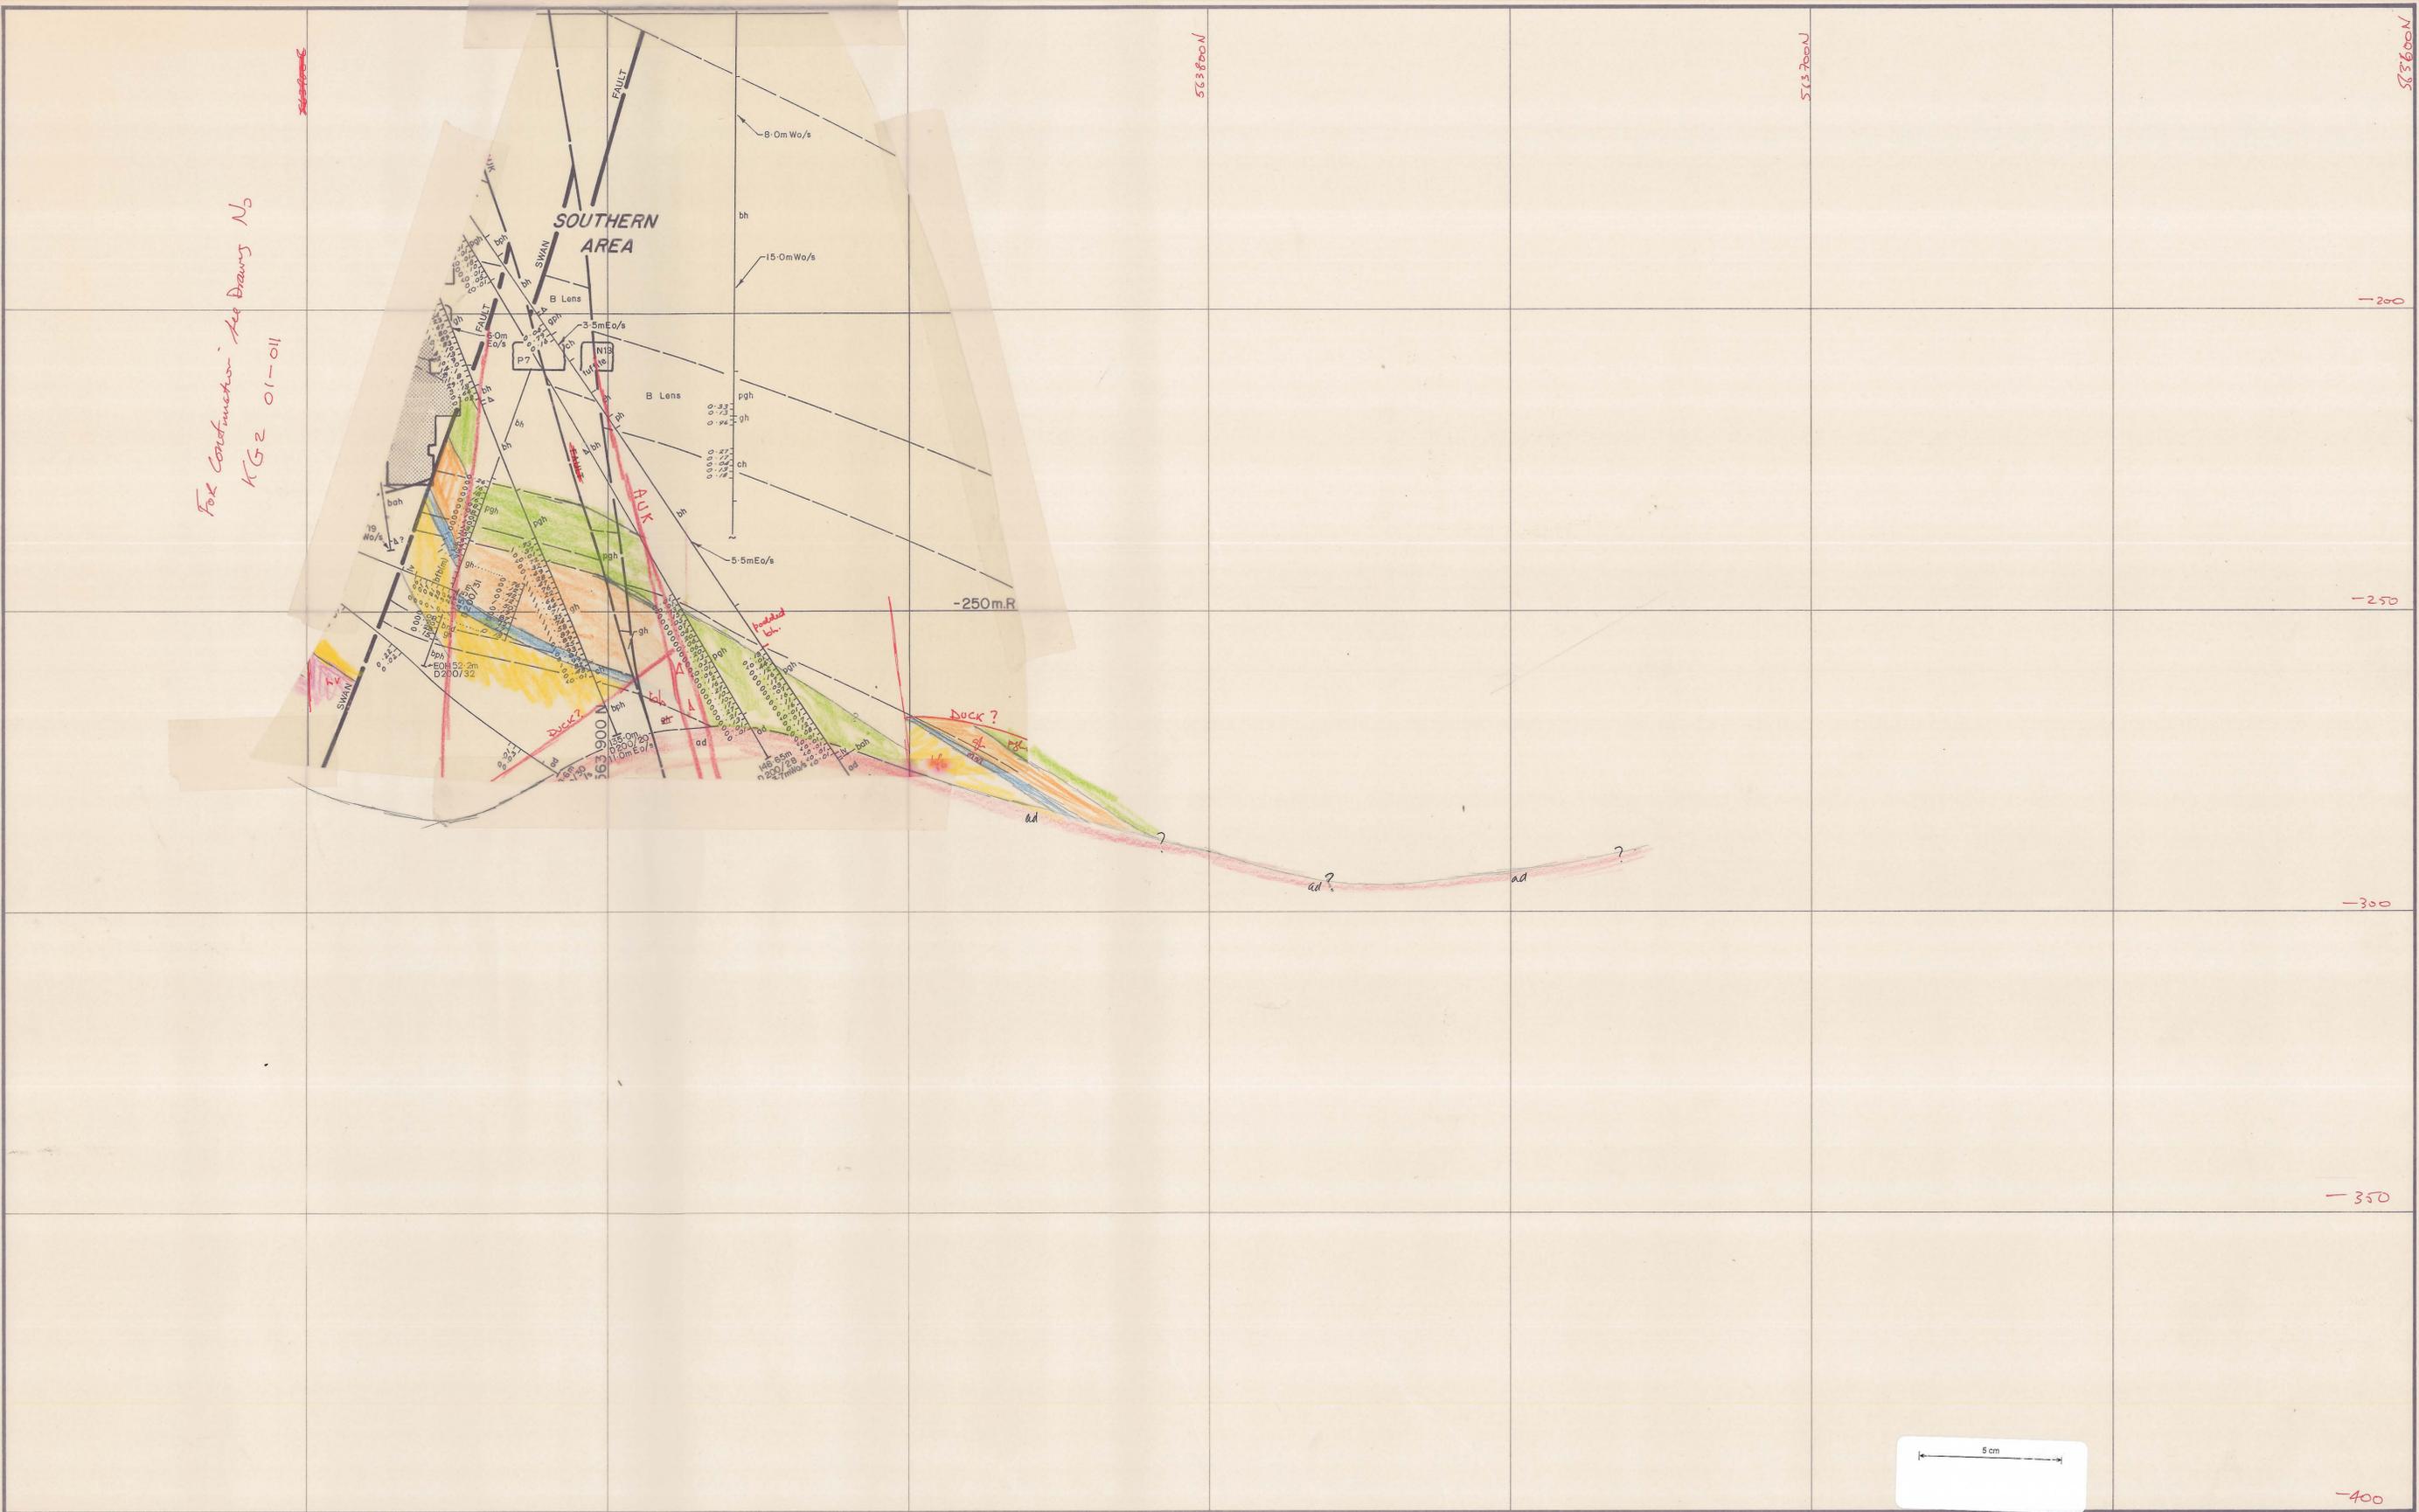

0374\_993

	<b>KING ISLAND SCHEELITE</b>	
	 SCALE 1:500	DWG. No. KG2-01-011S
	<b>DOLPHIN MINE</b> GEOLOGICAL CROSS-SECTION 220 200 E SOUTHERN EXTENSION	
	DATE:	
DRAWN:		
GEOLOGY:		
CHECKED:		