


DORSET LAGOON

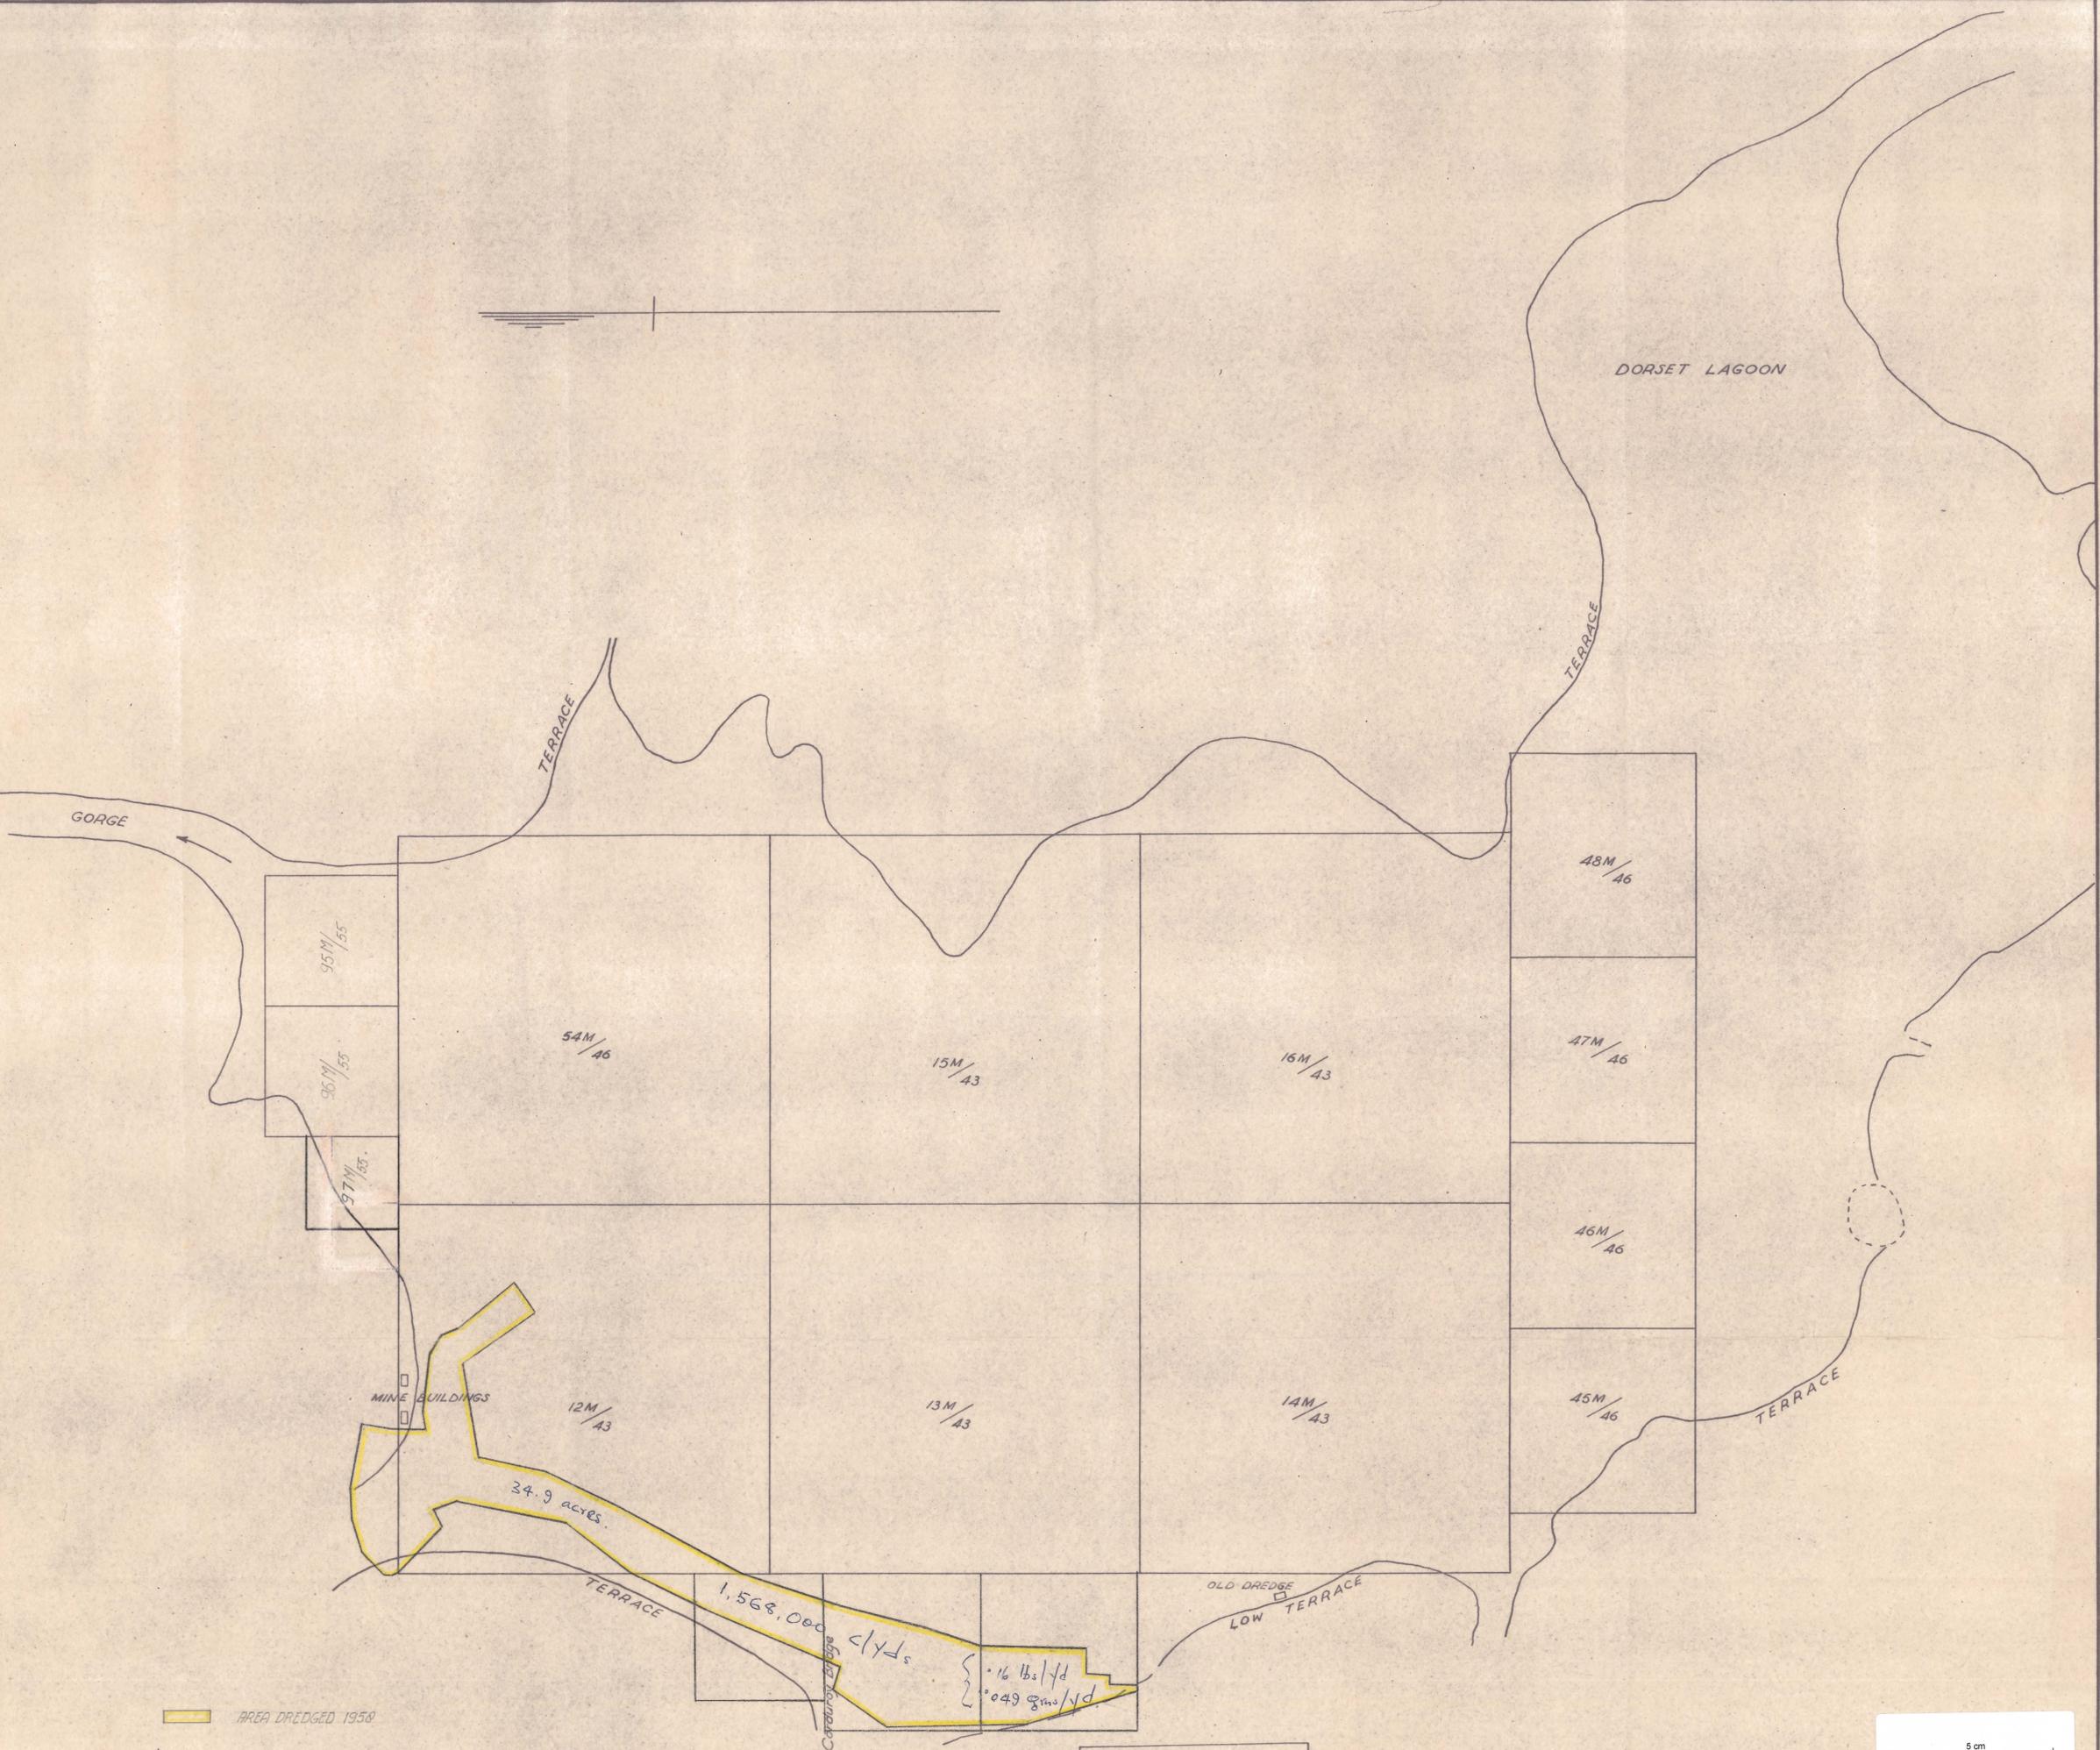

95M/55
96M/55
97M/55

TERRACE

TERRACE

GORGE

48M/46

54M/46

15M/43

16M/43

47M/46

46M/46

MINE BUILDINGS

12M/43

13M/43

14M/43

45M/46

TERRACE

34.9 acres

1,568,000 c/yds

.16 lbs/d
.049 gms/d

OLD DREDGE LOW TERRACE


AREA DREDGED 1950

Ref Letter # 7699
5. 3. 59

To Gladstone

EASEMENT

To Pioneer

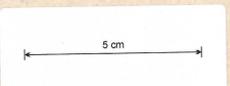

DORSET TIN DREDGING

PLAN OF LEASES

SCALE 1 Inch = 6 Chains

375-04

375-04