


316
-01

316
-01

N

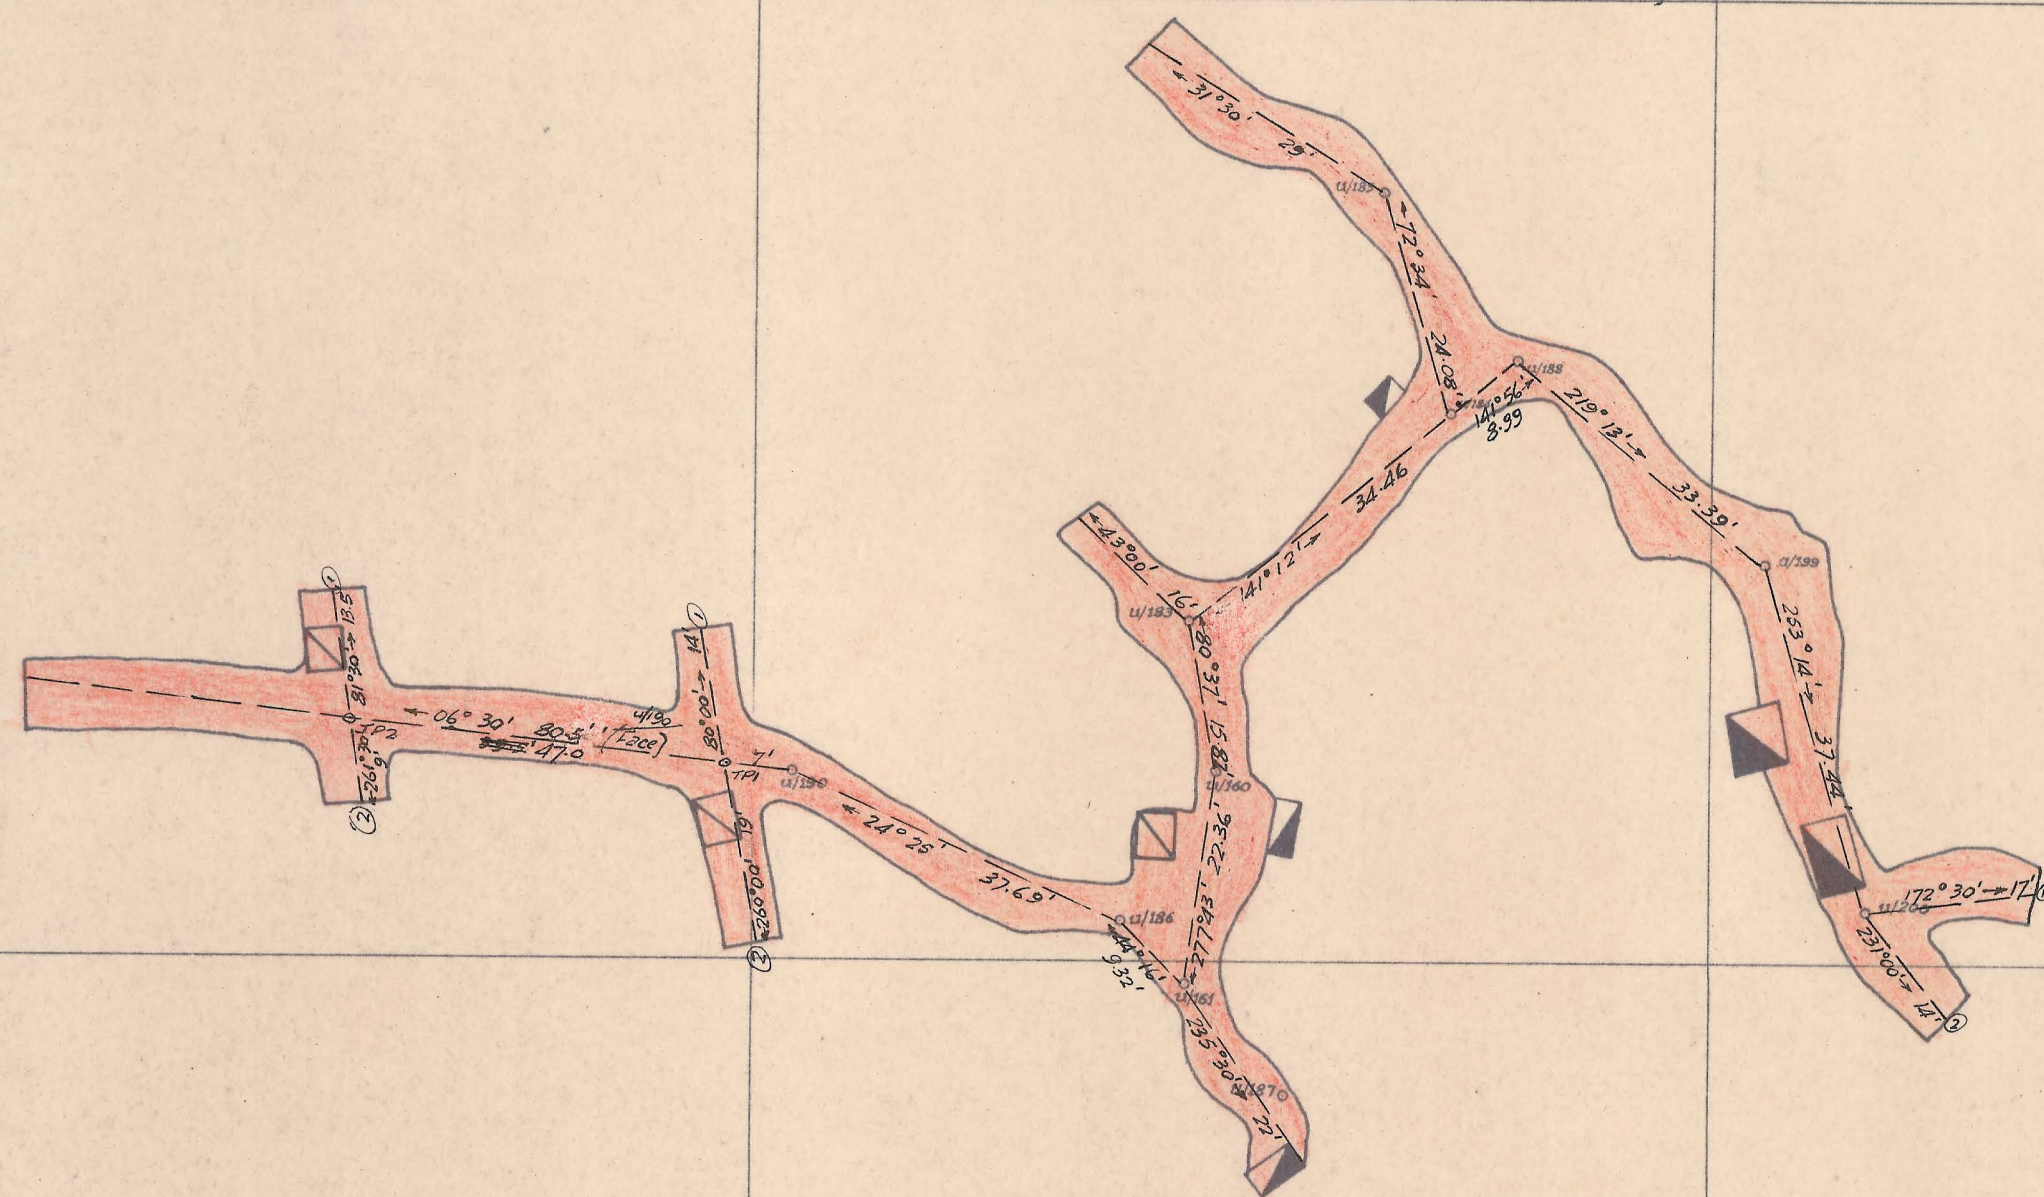

5 cm

R.A.T.M.

1952 Level - 3H/97 Sub Levels
Scale 1" = 20'

WORKINGS FOR Year Ended
31-12-60 Shown in Red

Mine Manager. *Al. Jhu*
Mine Surveyor. *P. J. Jhu*

PT. 2-2-61