



316
-02

376
-02

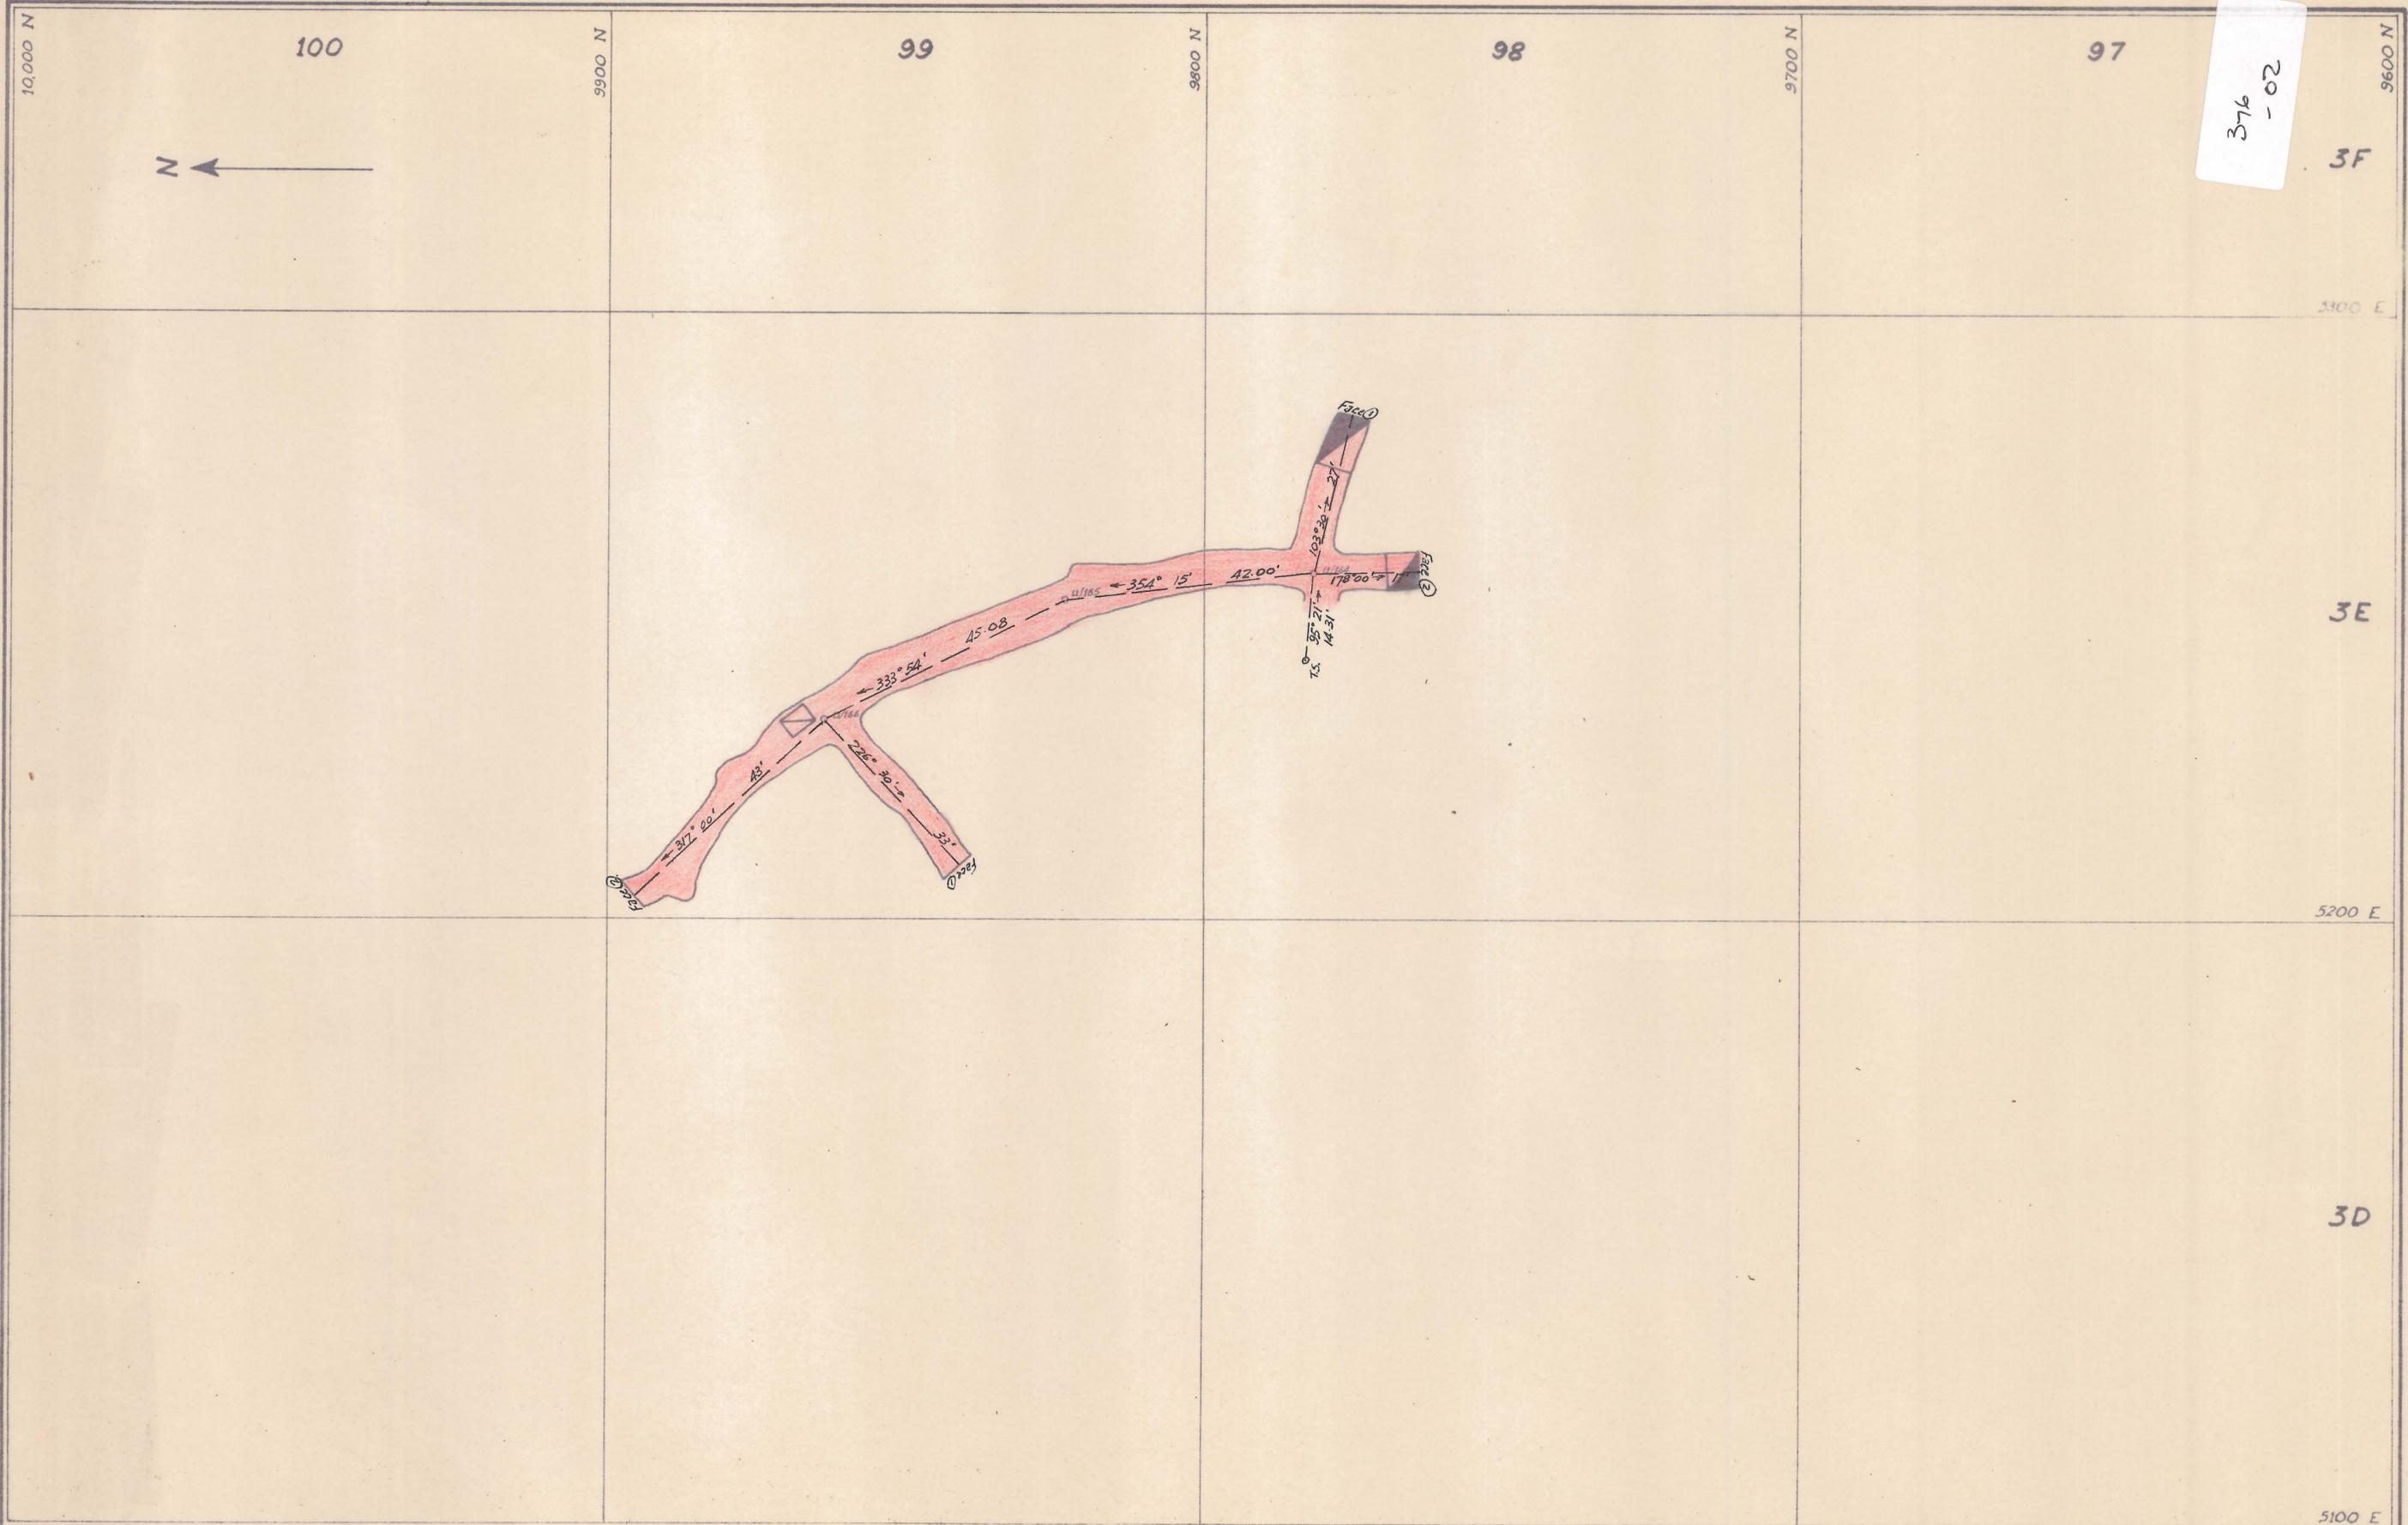

R.A.T.M.

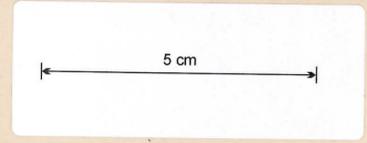

1962 Level 3E/98 Sub Level
Scale 1" = 20'

Workings For Year Ended
31/12/60 Shown in Red

Mine Manager. *[Signature]*
Mine Surveyor. *[Signature]*

PT 2-261