


316-03

316-03

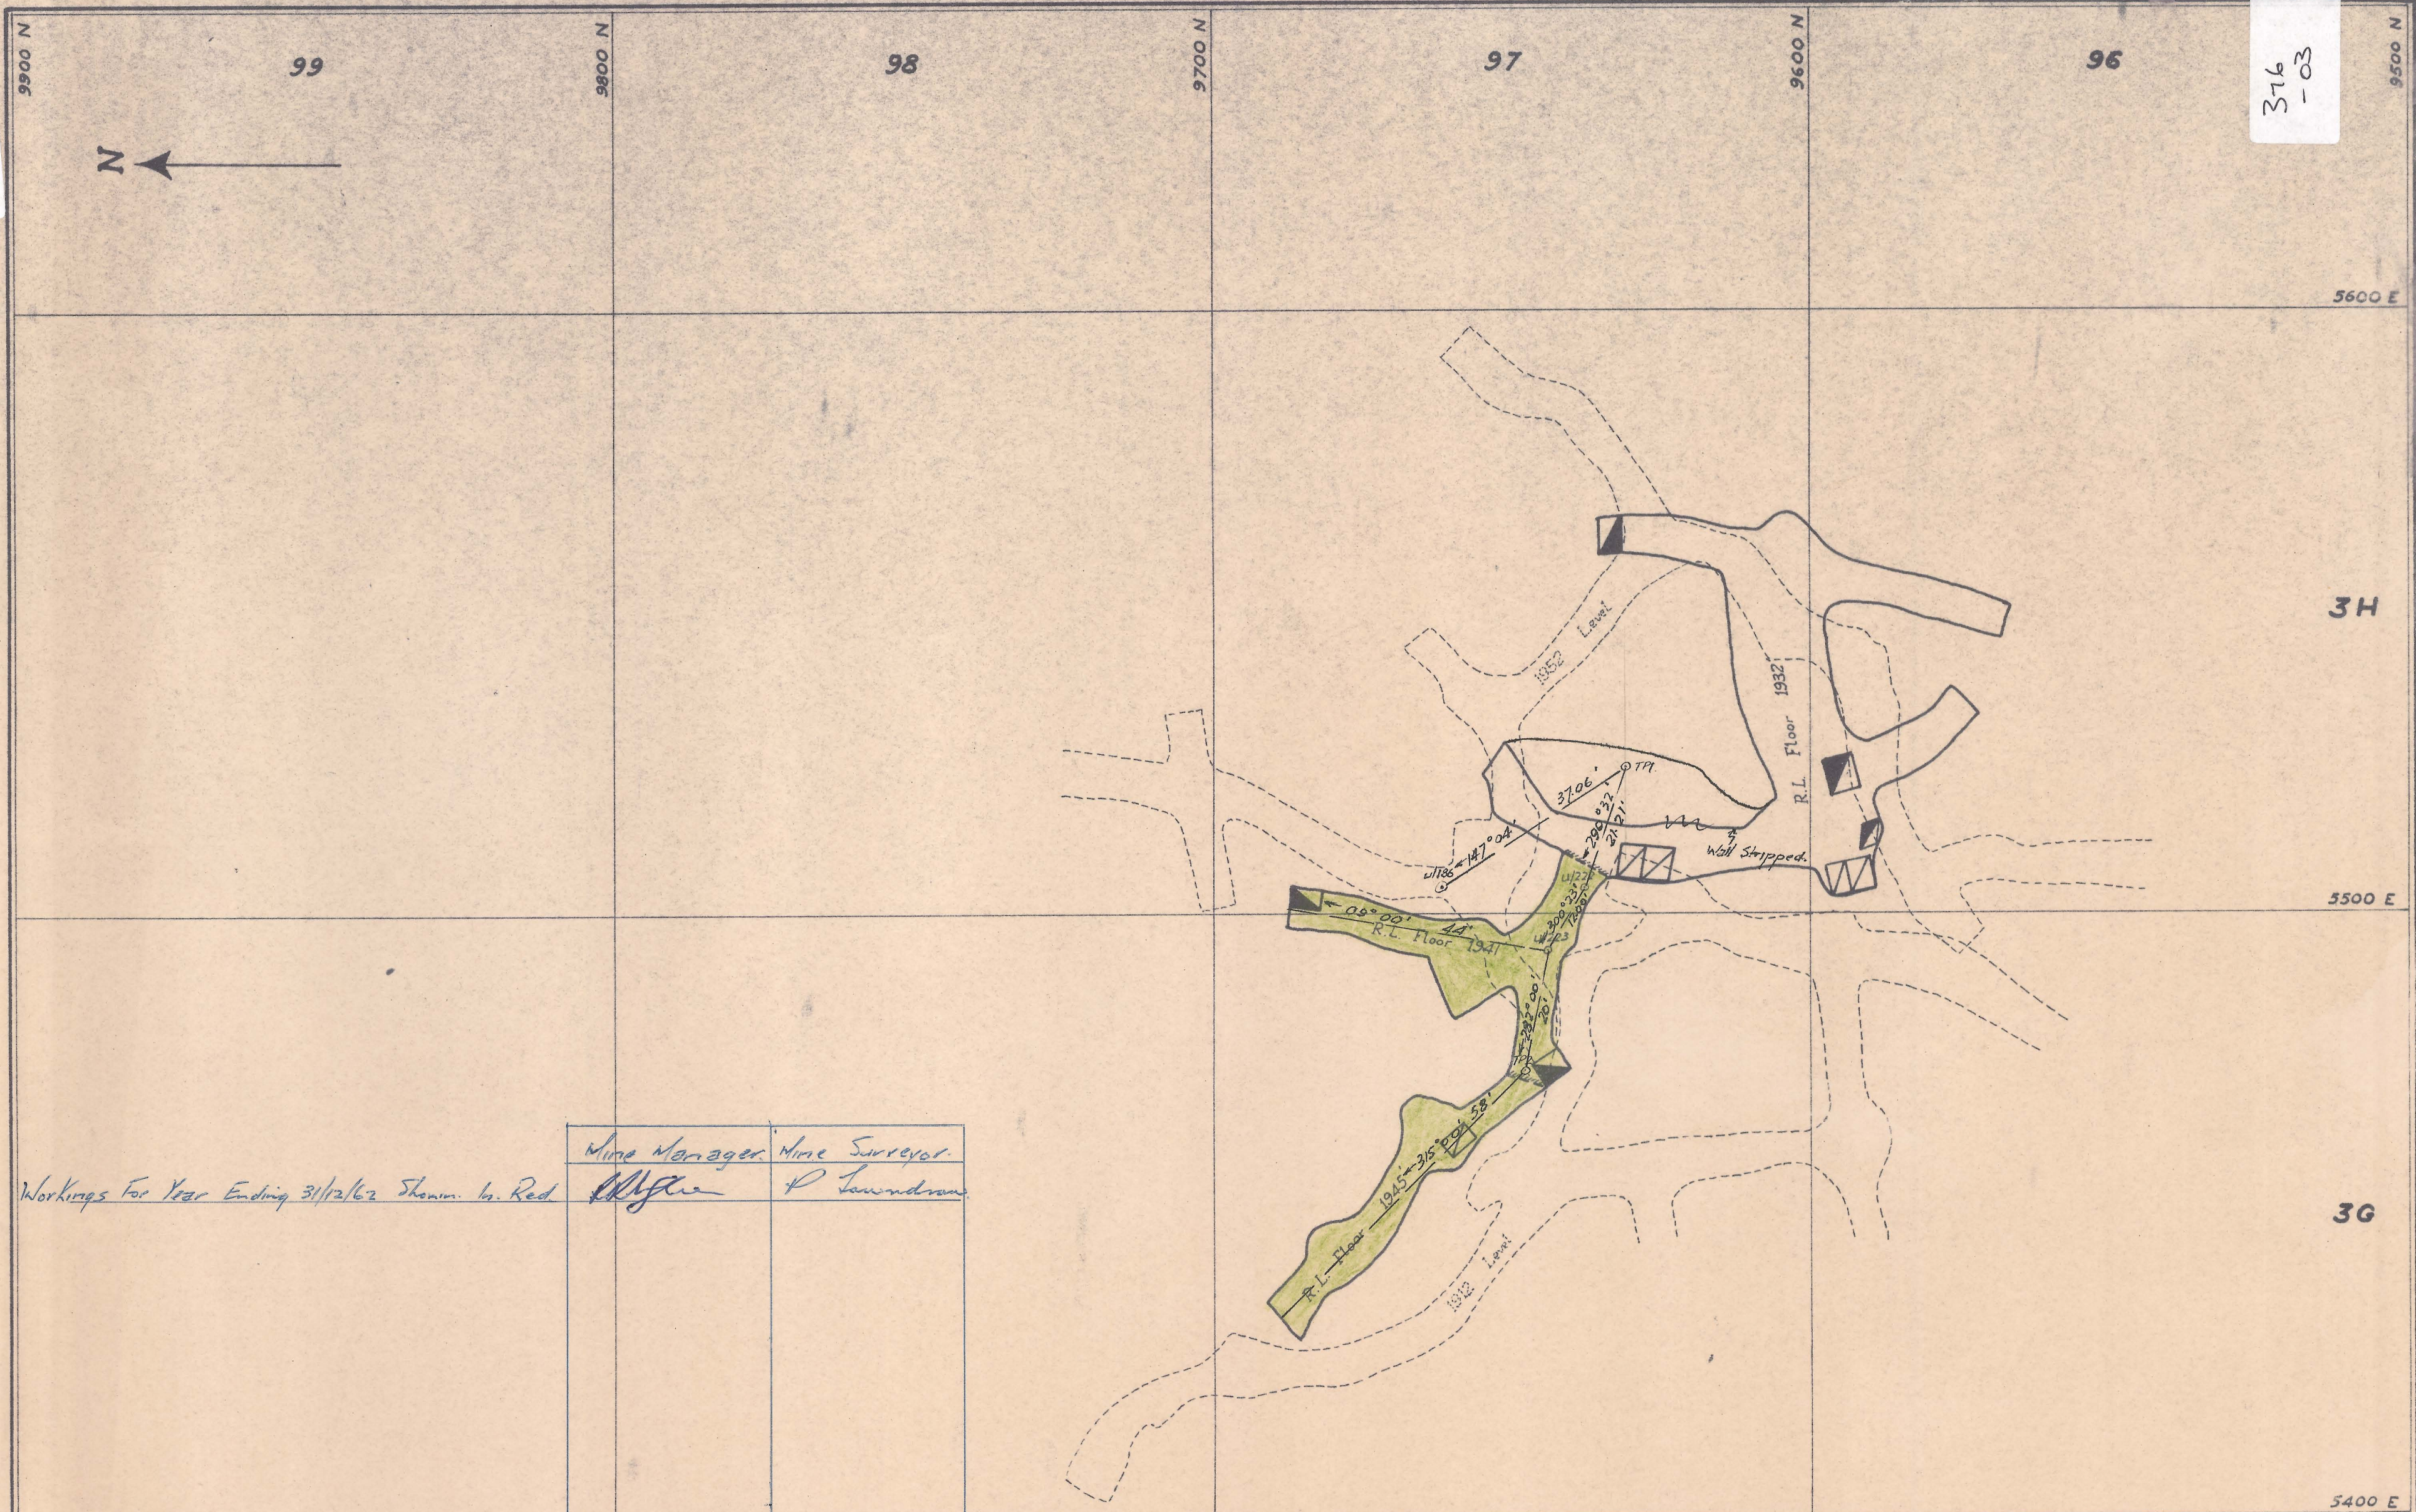

Workings For Year Ending 31/12/62 Shown In Red

Mine Manager	Mine Surveyor
<i>[Signature]</i>	P Lowndes

5 cm

1932 Level — 3H/97 Sub Levels.

Scale :- 1" = 20'

Workings. For Year Ending 31-12-61
Shown In Green.

Mine Man. :- *[Signature]*
Surveyor :- P Lowndes