


316-05

316-05

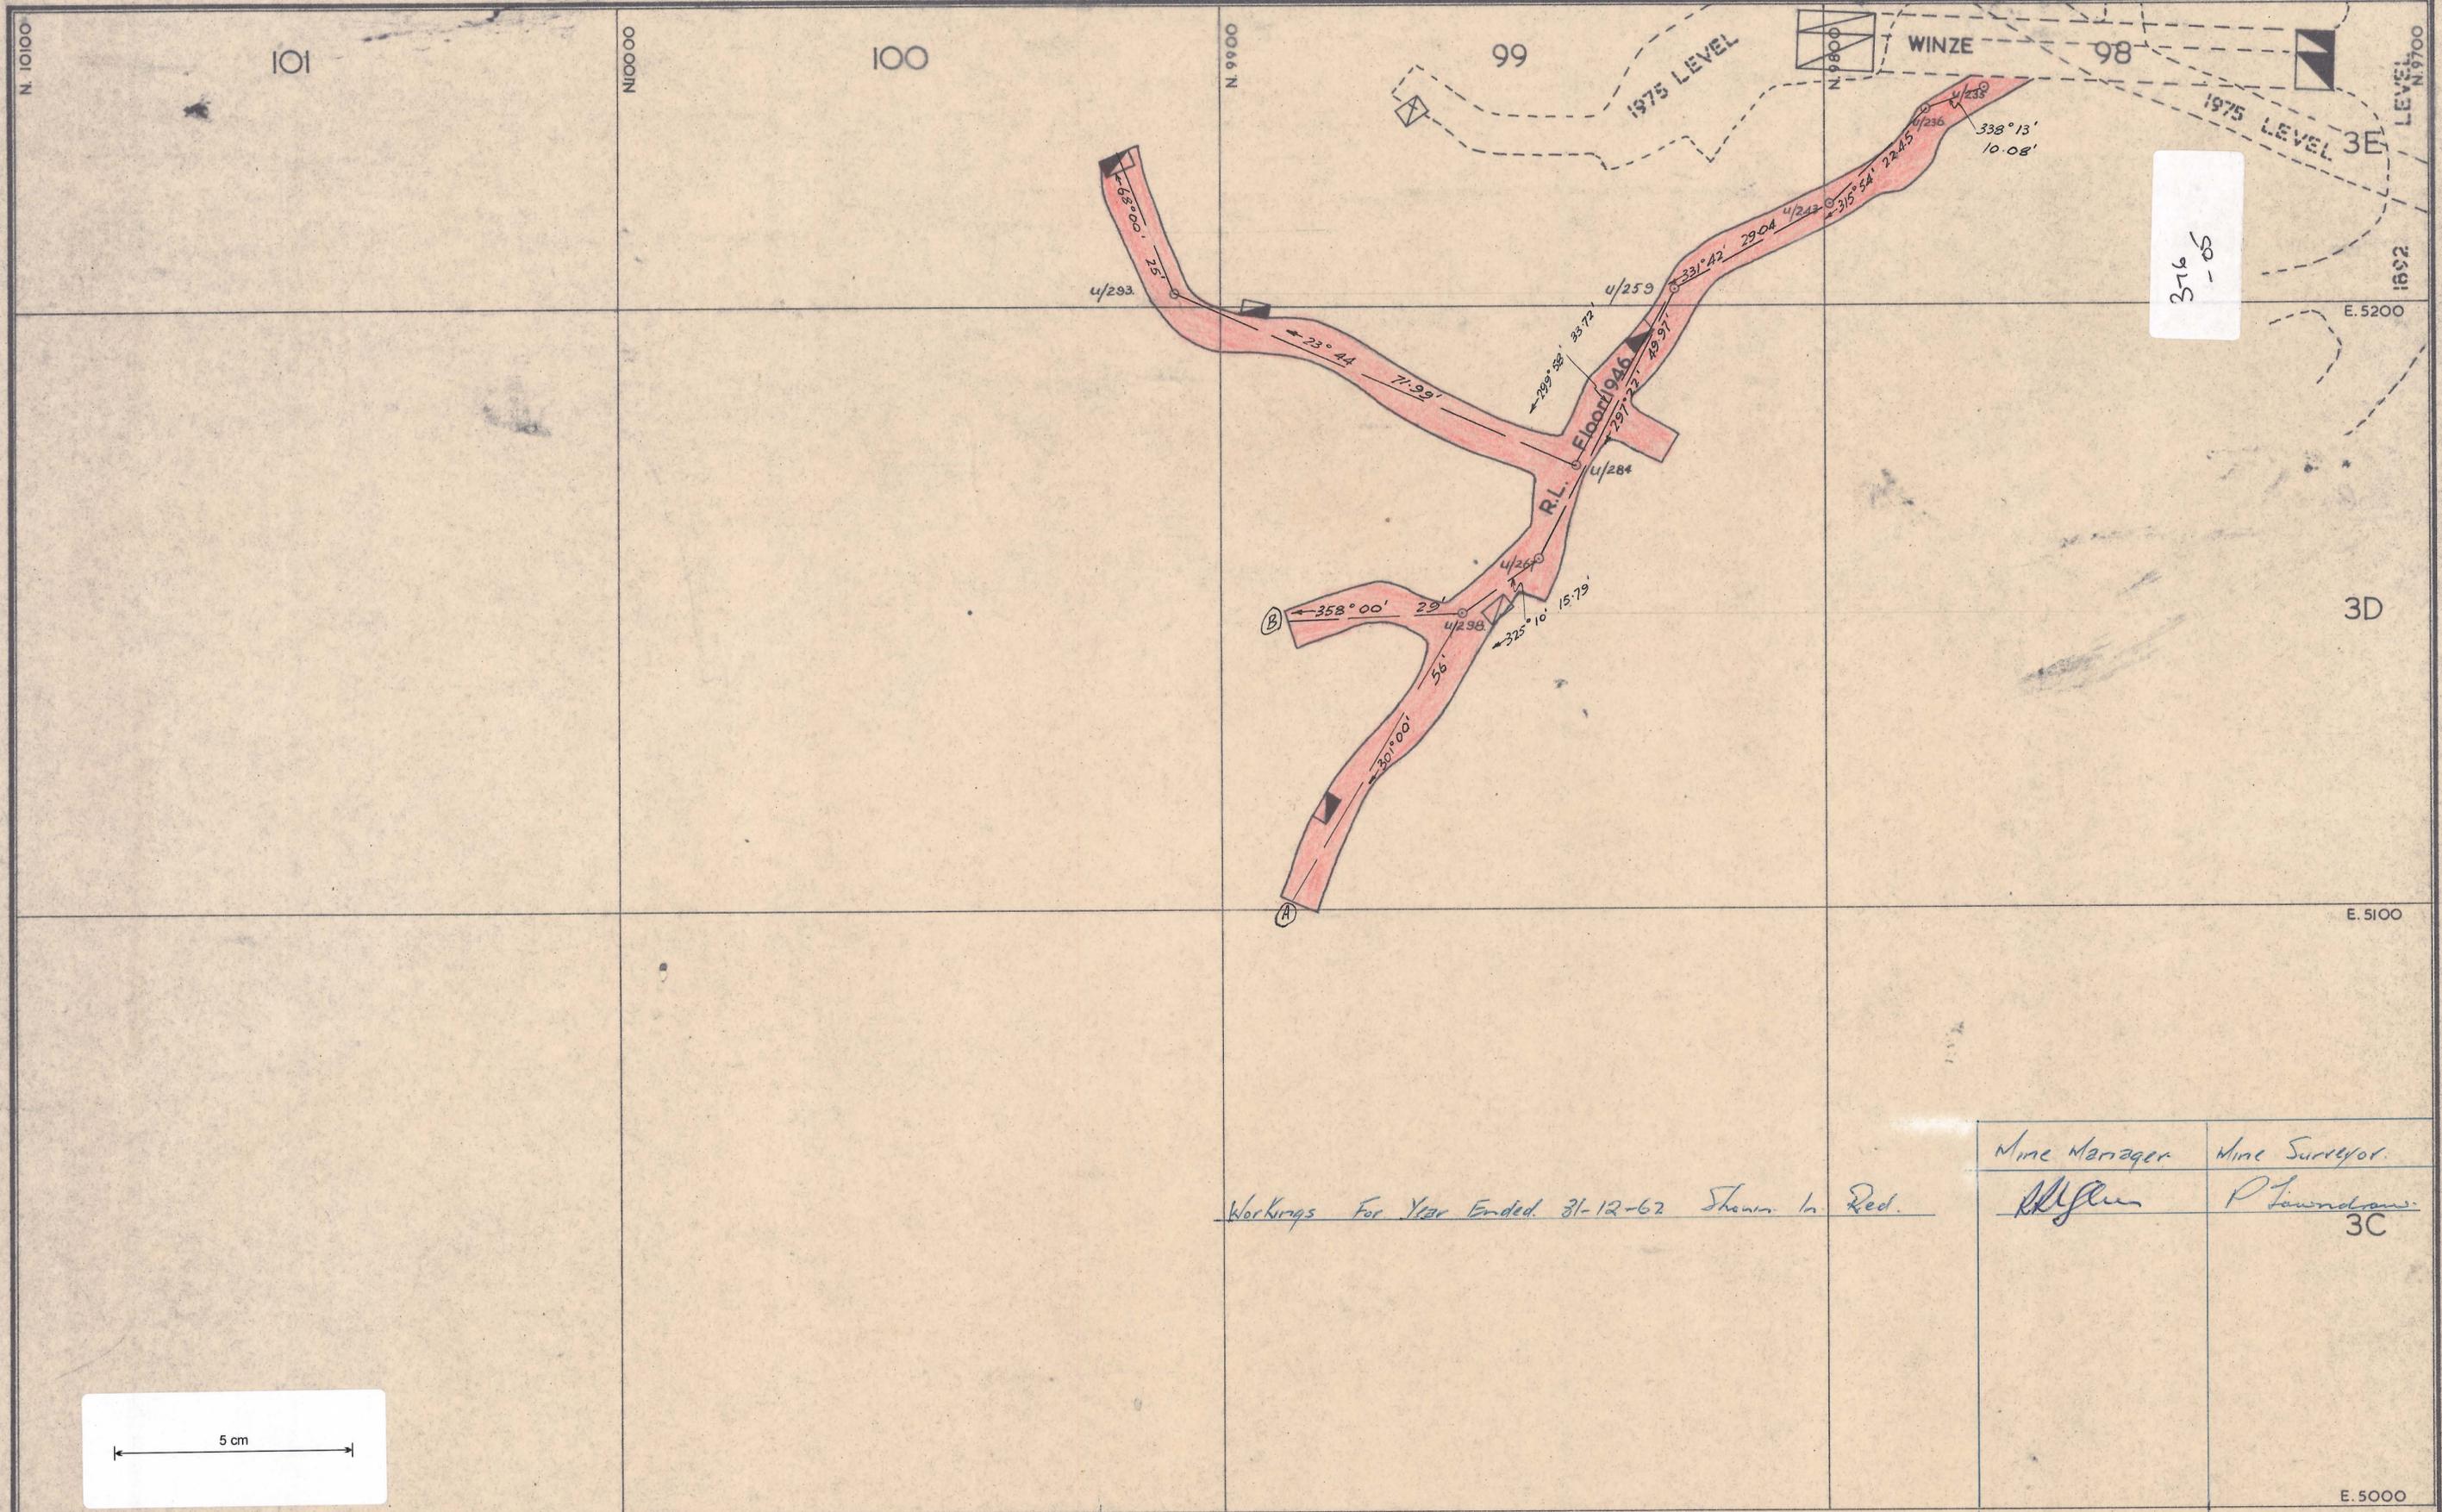

Workings For Year Ended 31-12-62 Shown In Red.

Mine Manager	Mine Surveyor
<i>M. J. ...</i>	<i>P. Lawndown</i>
	3C

**1946 Level — 3E/98 Sub Levels**