

376-06

376-06



9600 N

96

9500 N

95

9400 N


94

9300 N

3F


5300 E

3E

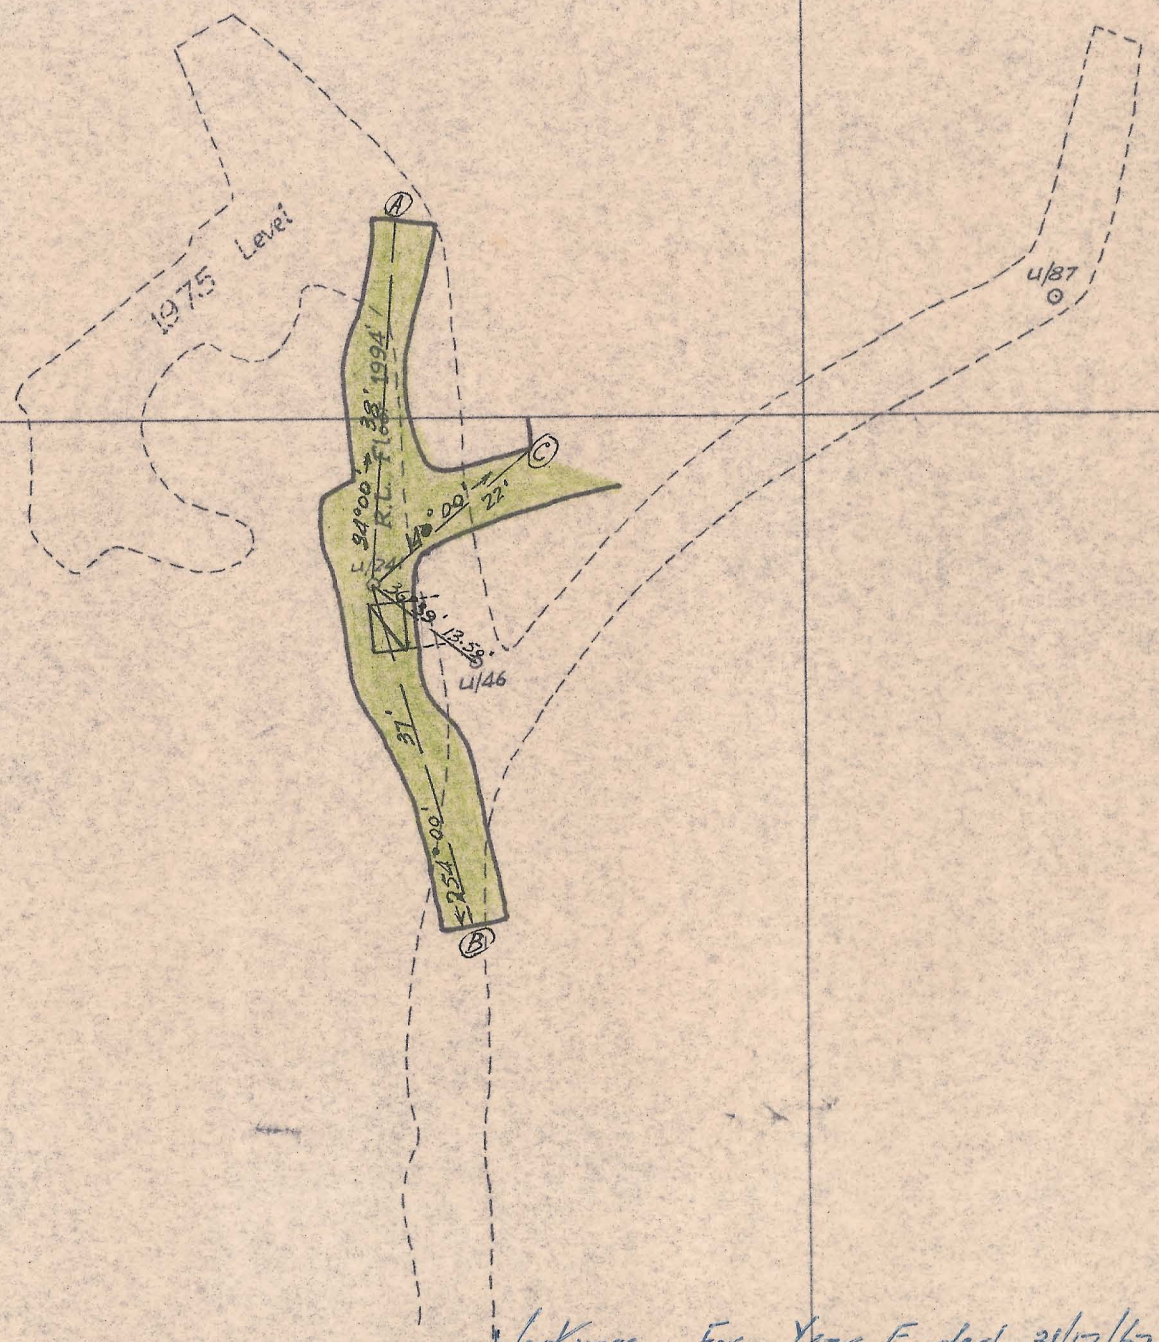

Workings For Year Ended 31/12/62 Shown in Red

|                    |                    |
|--------------------|--------------------|
| Mine Manager       | Mine Surveyor      |
| <i>[Signature]</i> | <i>[Signature]</i> |

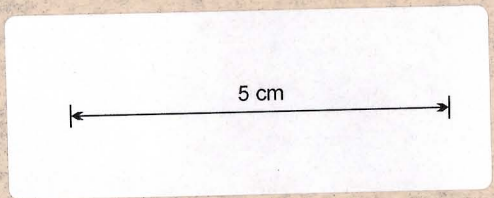

R.A.T.M.

1994 Level — 3E/95 Sub Level  
Scale :- 1" = 20'

Workings For Year Ended 31-12-61  
Shown in Green.

Mine Manager: *[Signature]*  
Surveyor: *[Signature]*