

9,600 N

96

9,500 N

95

9,400 N

94

9,300 N

93


9,200 N

5,600 E

3H

5,500 E

5,400 E

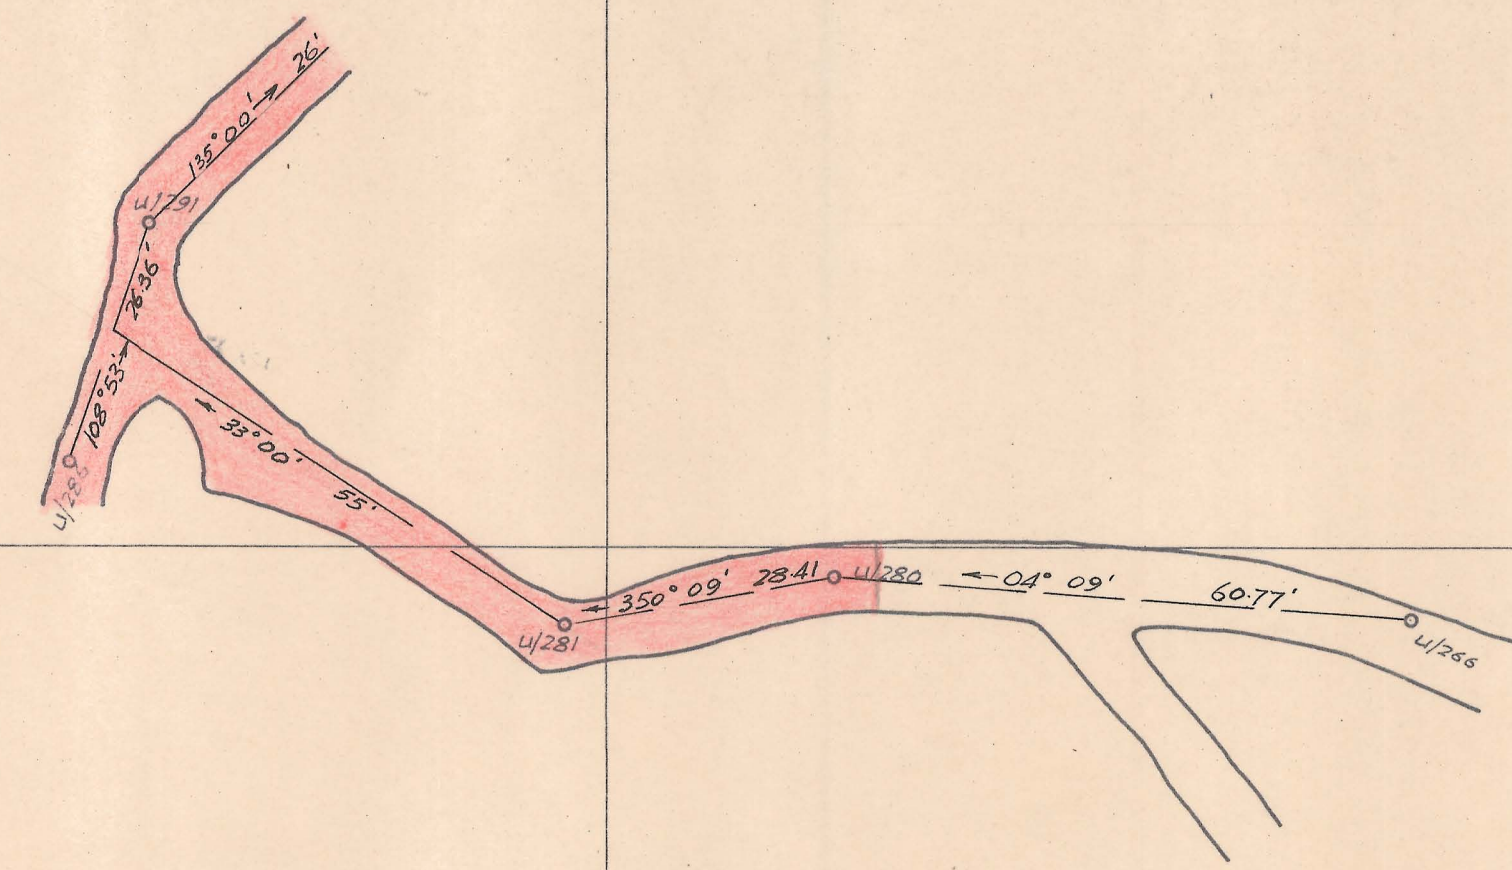


Workings for Year Ended 31-12-62 Shown in Red.

Mine Manager	Mine Surveyor
<i>[Signature]</i>	<i>P. Lawndown</i>

2000 LEVEL - 3G/95 DRIVE

Scale: - 1" = 20'

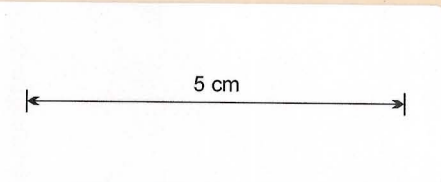

30-912

R.A.T.M.

30-912