


316-09

316-09

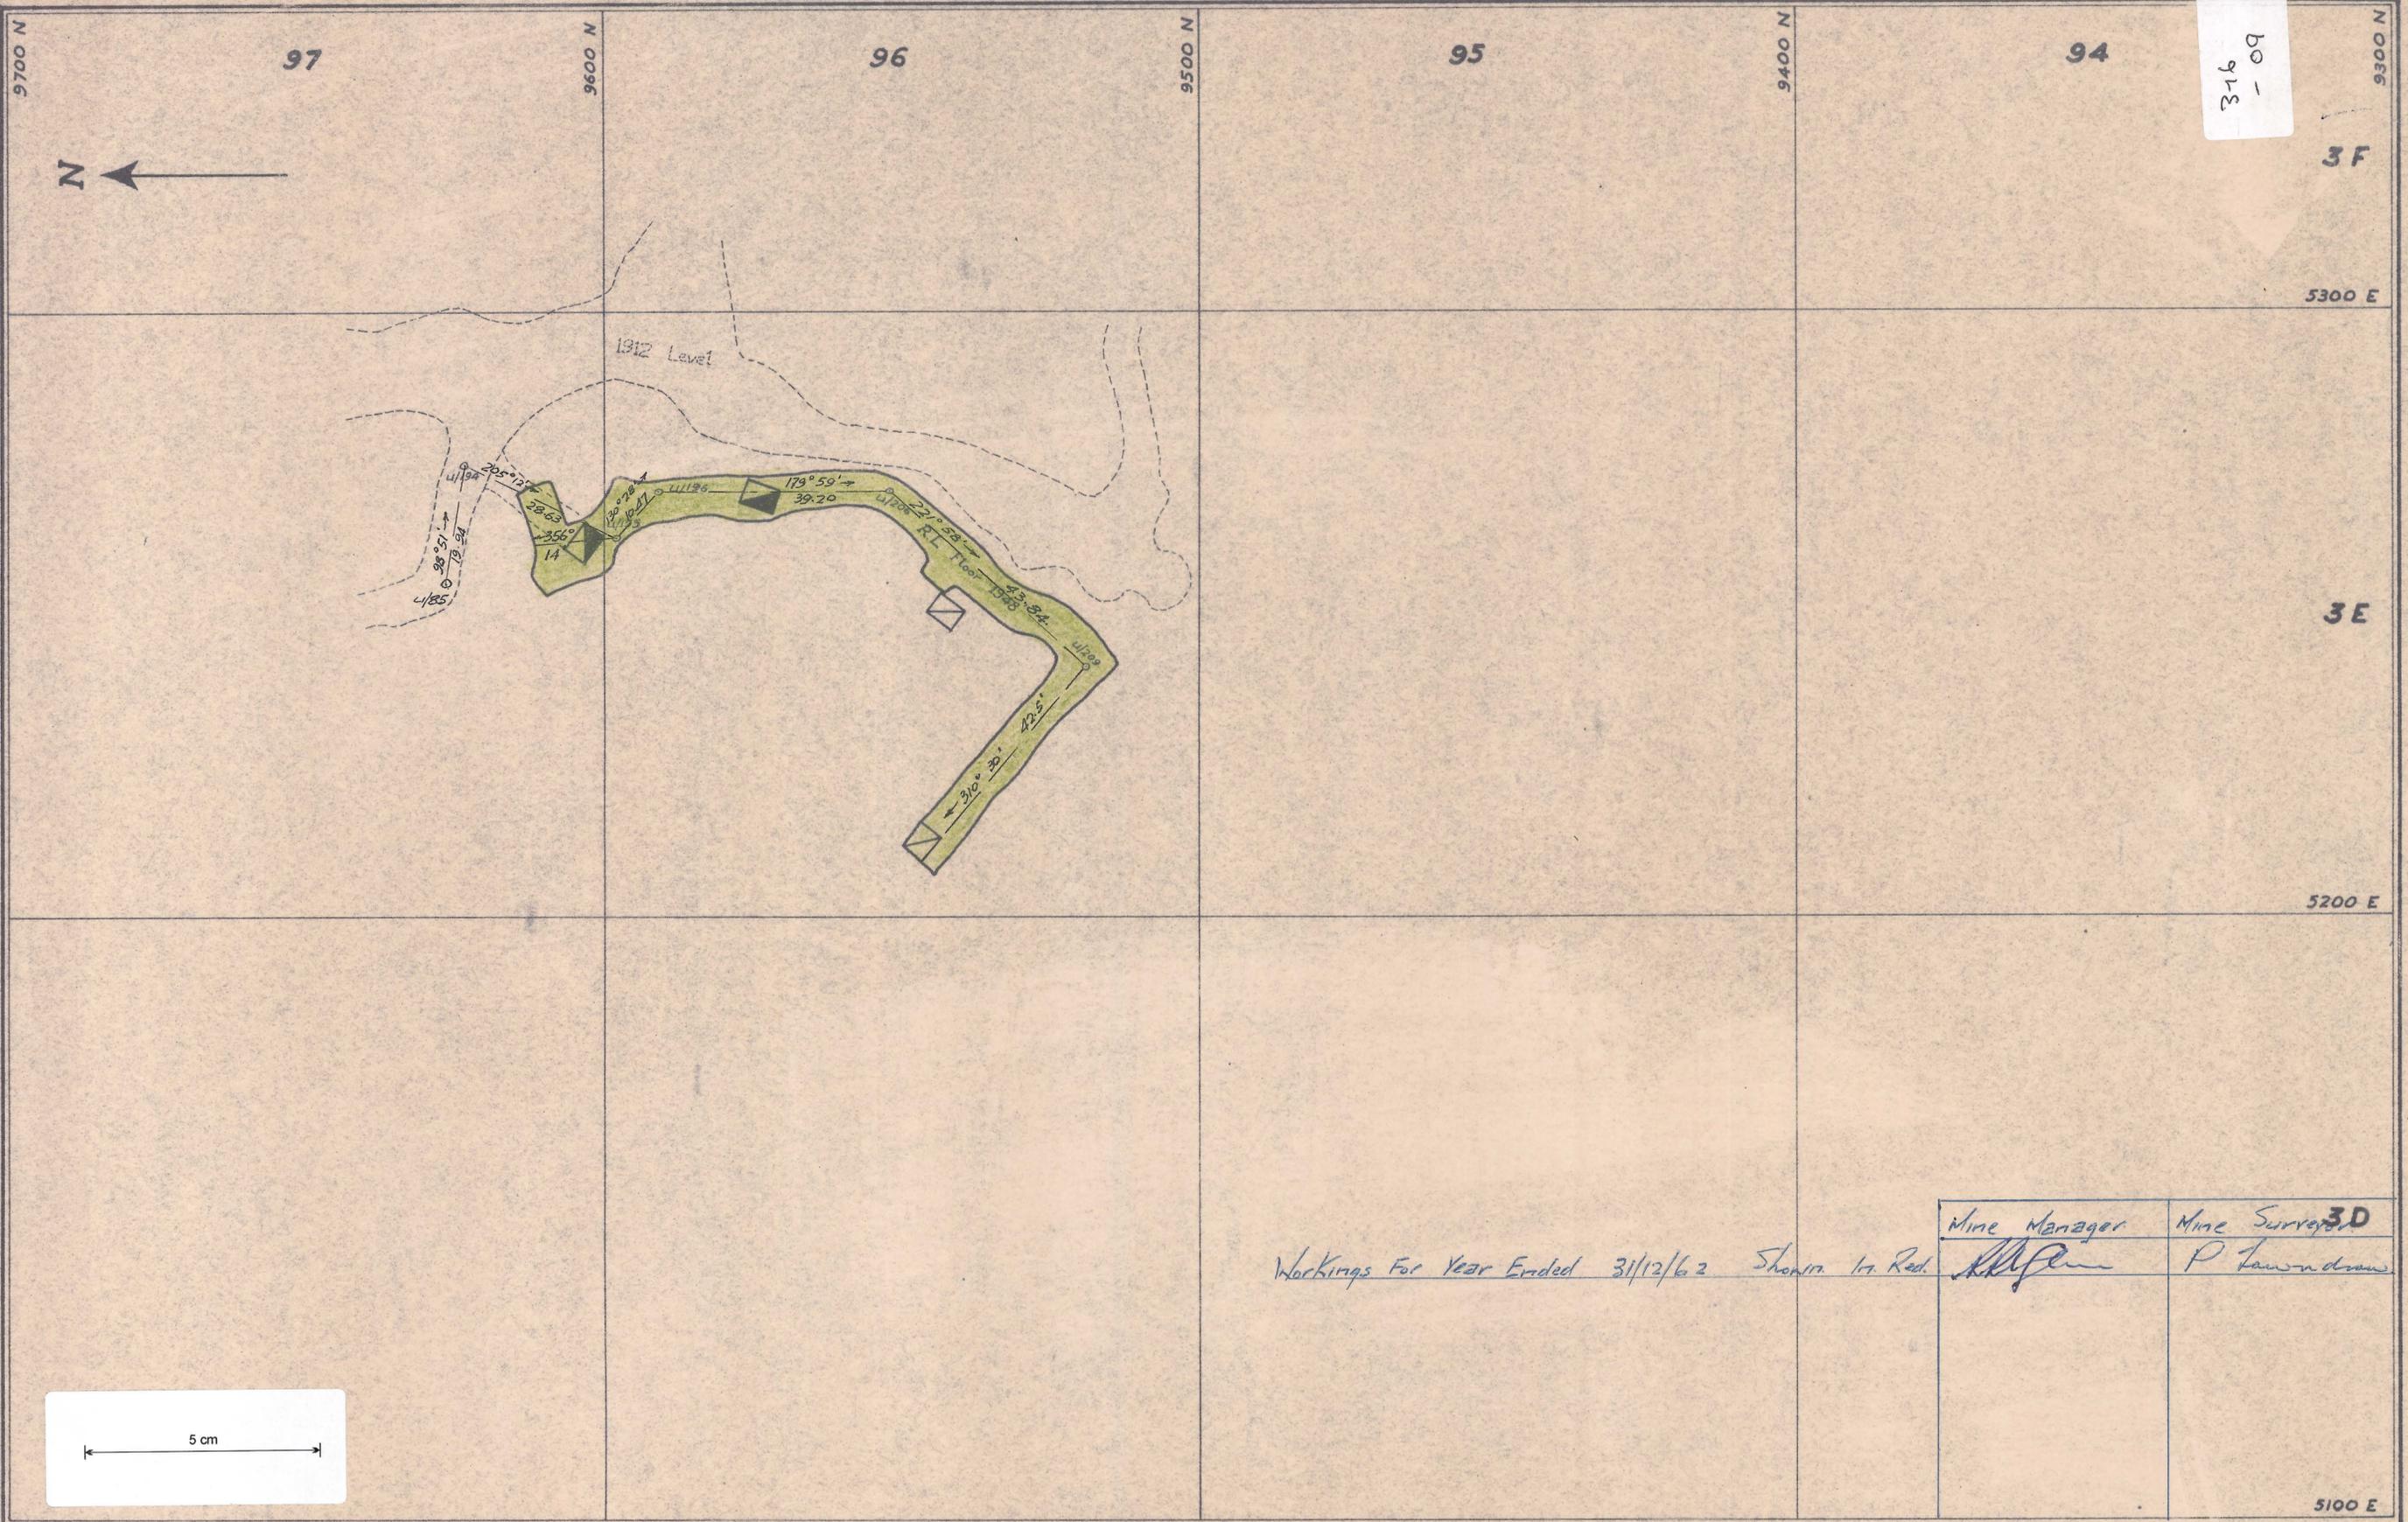

Workings For Year Ended 31/12/62 Shows In Red

Mine Manager	Mine Surveyor <b>3D</b>
<i>[Signature]</i>	P. Townsend

1948 Level - 3E/96 Sub Levels  
 Scale :- 1" = 20'

Workings For Year Ending 31-12-61 Mine Man. :- *[Signature]*  
 Shows In Green.  Surveyor :- *[Signature]*

R.A.T.M.

P. Townsend 15-2-61