




1892 LEVEL

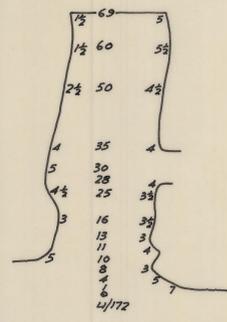


3D/97 Cross Cut Nth.

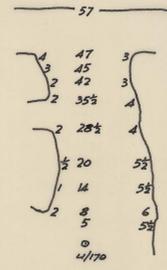


3D/97 Drive West

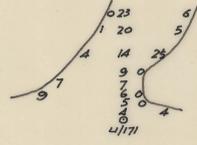


3D/97 Sump Cross Cut.

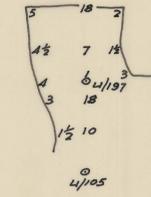


3D/97 Cross Cut Sth.

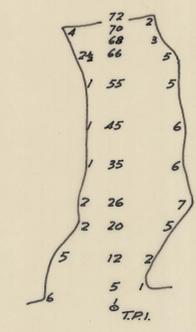


3C/97 Cross Cut Nth.

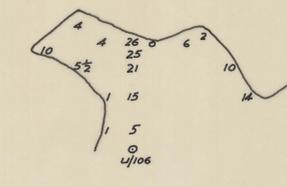


3D/98 Drive West

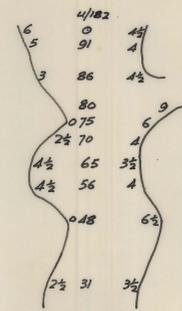


3D/97 Drive West

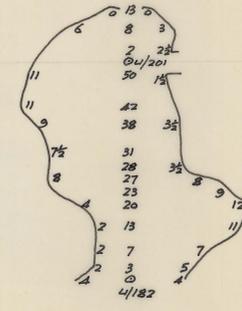


3D/97 Drive West Cont.

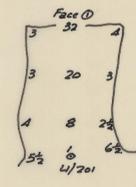


3B/98 Cross Cut.

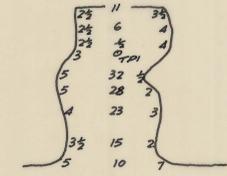

3E/98 Drive East.

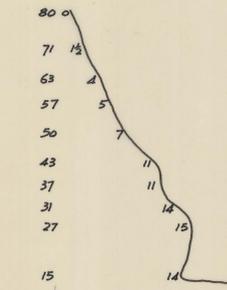


3F/96 Drive

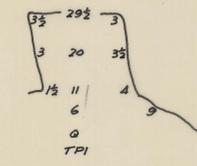


3F/96 Cross Cut


1912 LEVEL

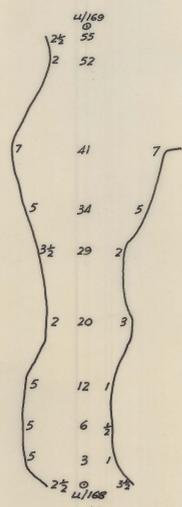

3E/96 Drive

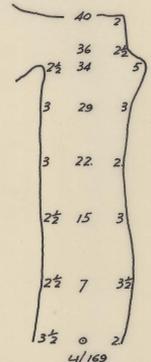


3E/96 Drive (Cont)

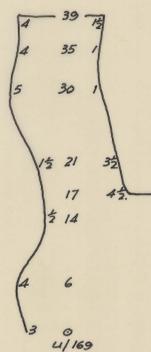


3E/96 Drive (Cont)

1932 LEVEL

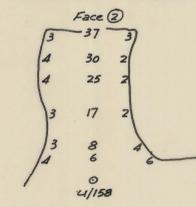

3H/96 Drive Sth.

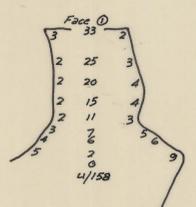


3H/97 Drive Nth.

BATTERY WORKINGS.

Offset Sheet For Year Ended 31-12-60

Mine Manager — AKL  
 Mine Surveyor — P. J. ...

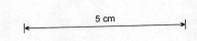

3-76  
-10

3-76  
-10