




1952 LEVEL

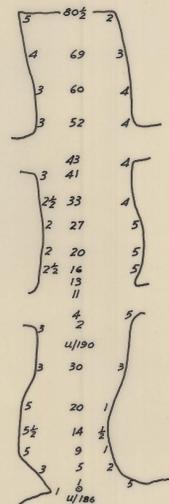


3H/97 Drive Nth.

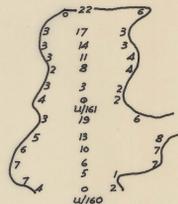


3H/97 Drive West

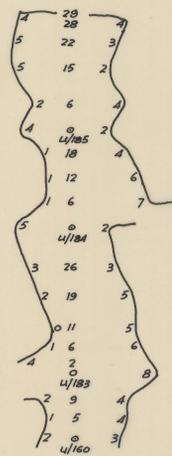


3H/97 Drive East

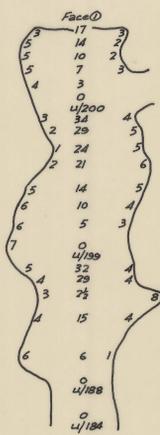

3H/97 Drive Sth.

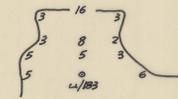


3H/97 Drive Nth.

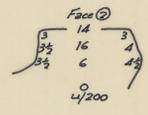


3H/97 Drive Sth.


1962 LEVEL

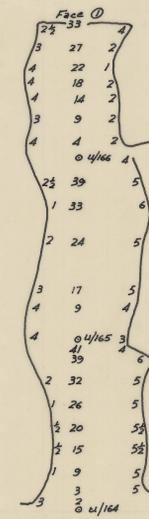


3E/98 Drive Nth.

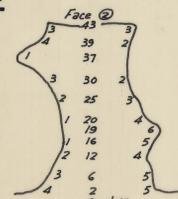

3E/98 Drive Nth.

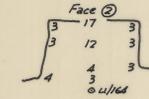


3E/98 Drive Sth.

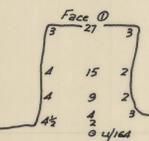


3E/98 Drive East


BLACK FACE — 1815 LEVEL

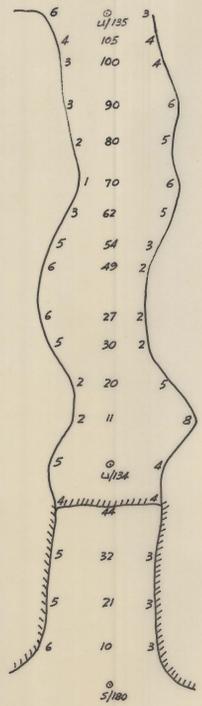


2K/129 Drive

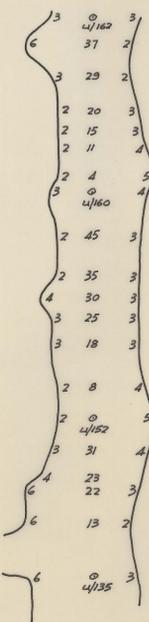

2K/129 Drive Cont.

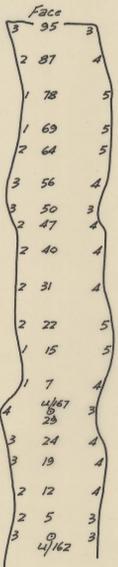


2K/129 Drive Cont.

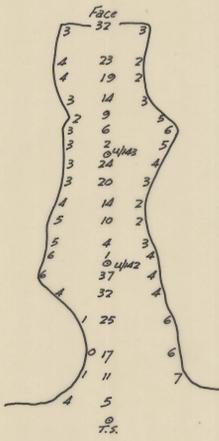


2K/128 Drive


BLACK FACE — 1902 LEVEL

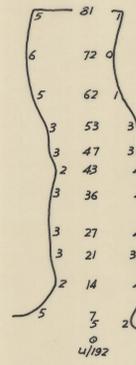

2K/126 Drive Nth.

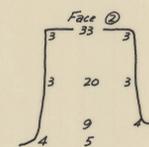

2K/126 Drive Sth.

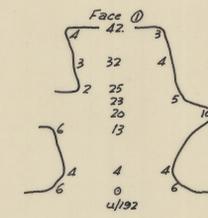

2K/126 Drive Sth.

BATTERY AND BLACK FACE WORKINGS

Offset Sheet For Year Ended 31-12-60

Mine Manager — *[Signature]*
 Mine Surveyor — *[Signature]*

