


2-18
-13

3-18
-13

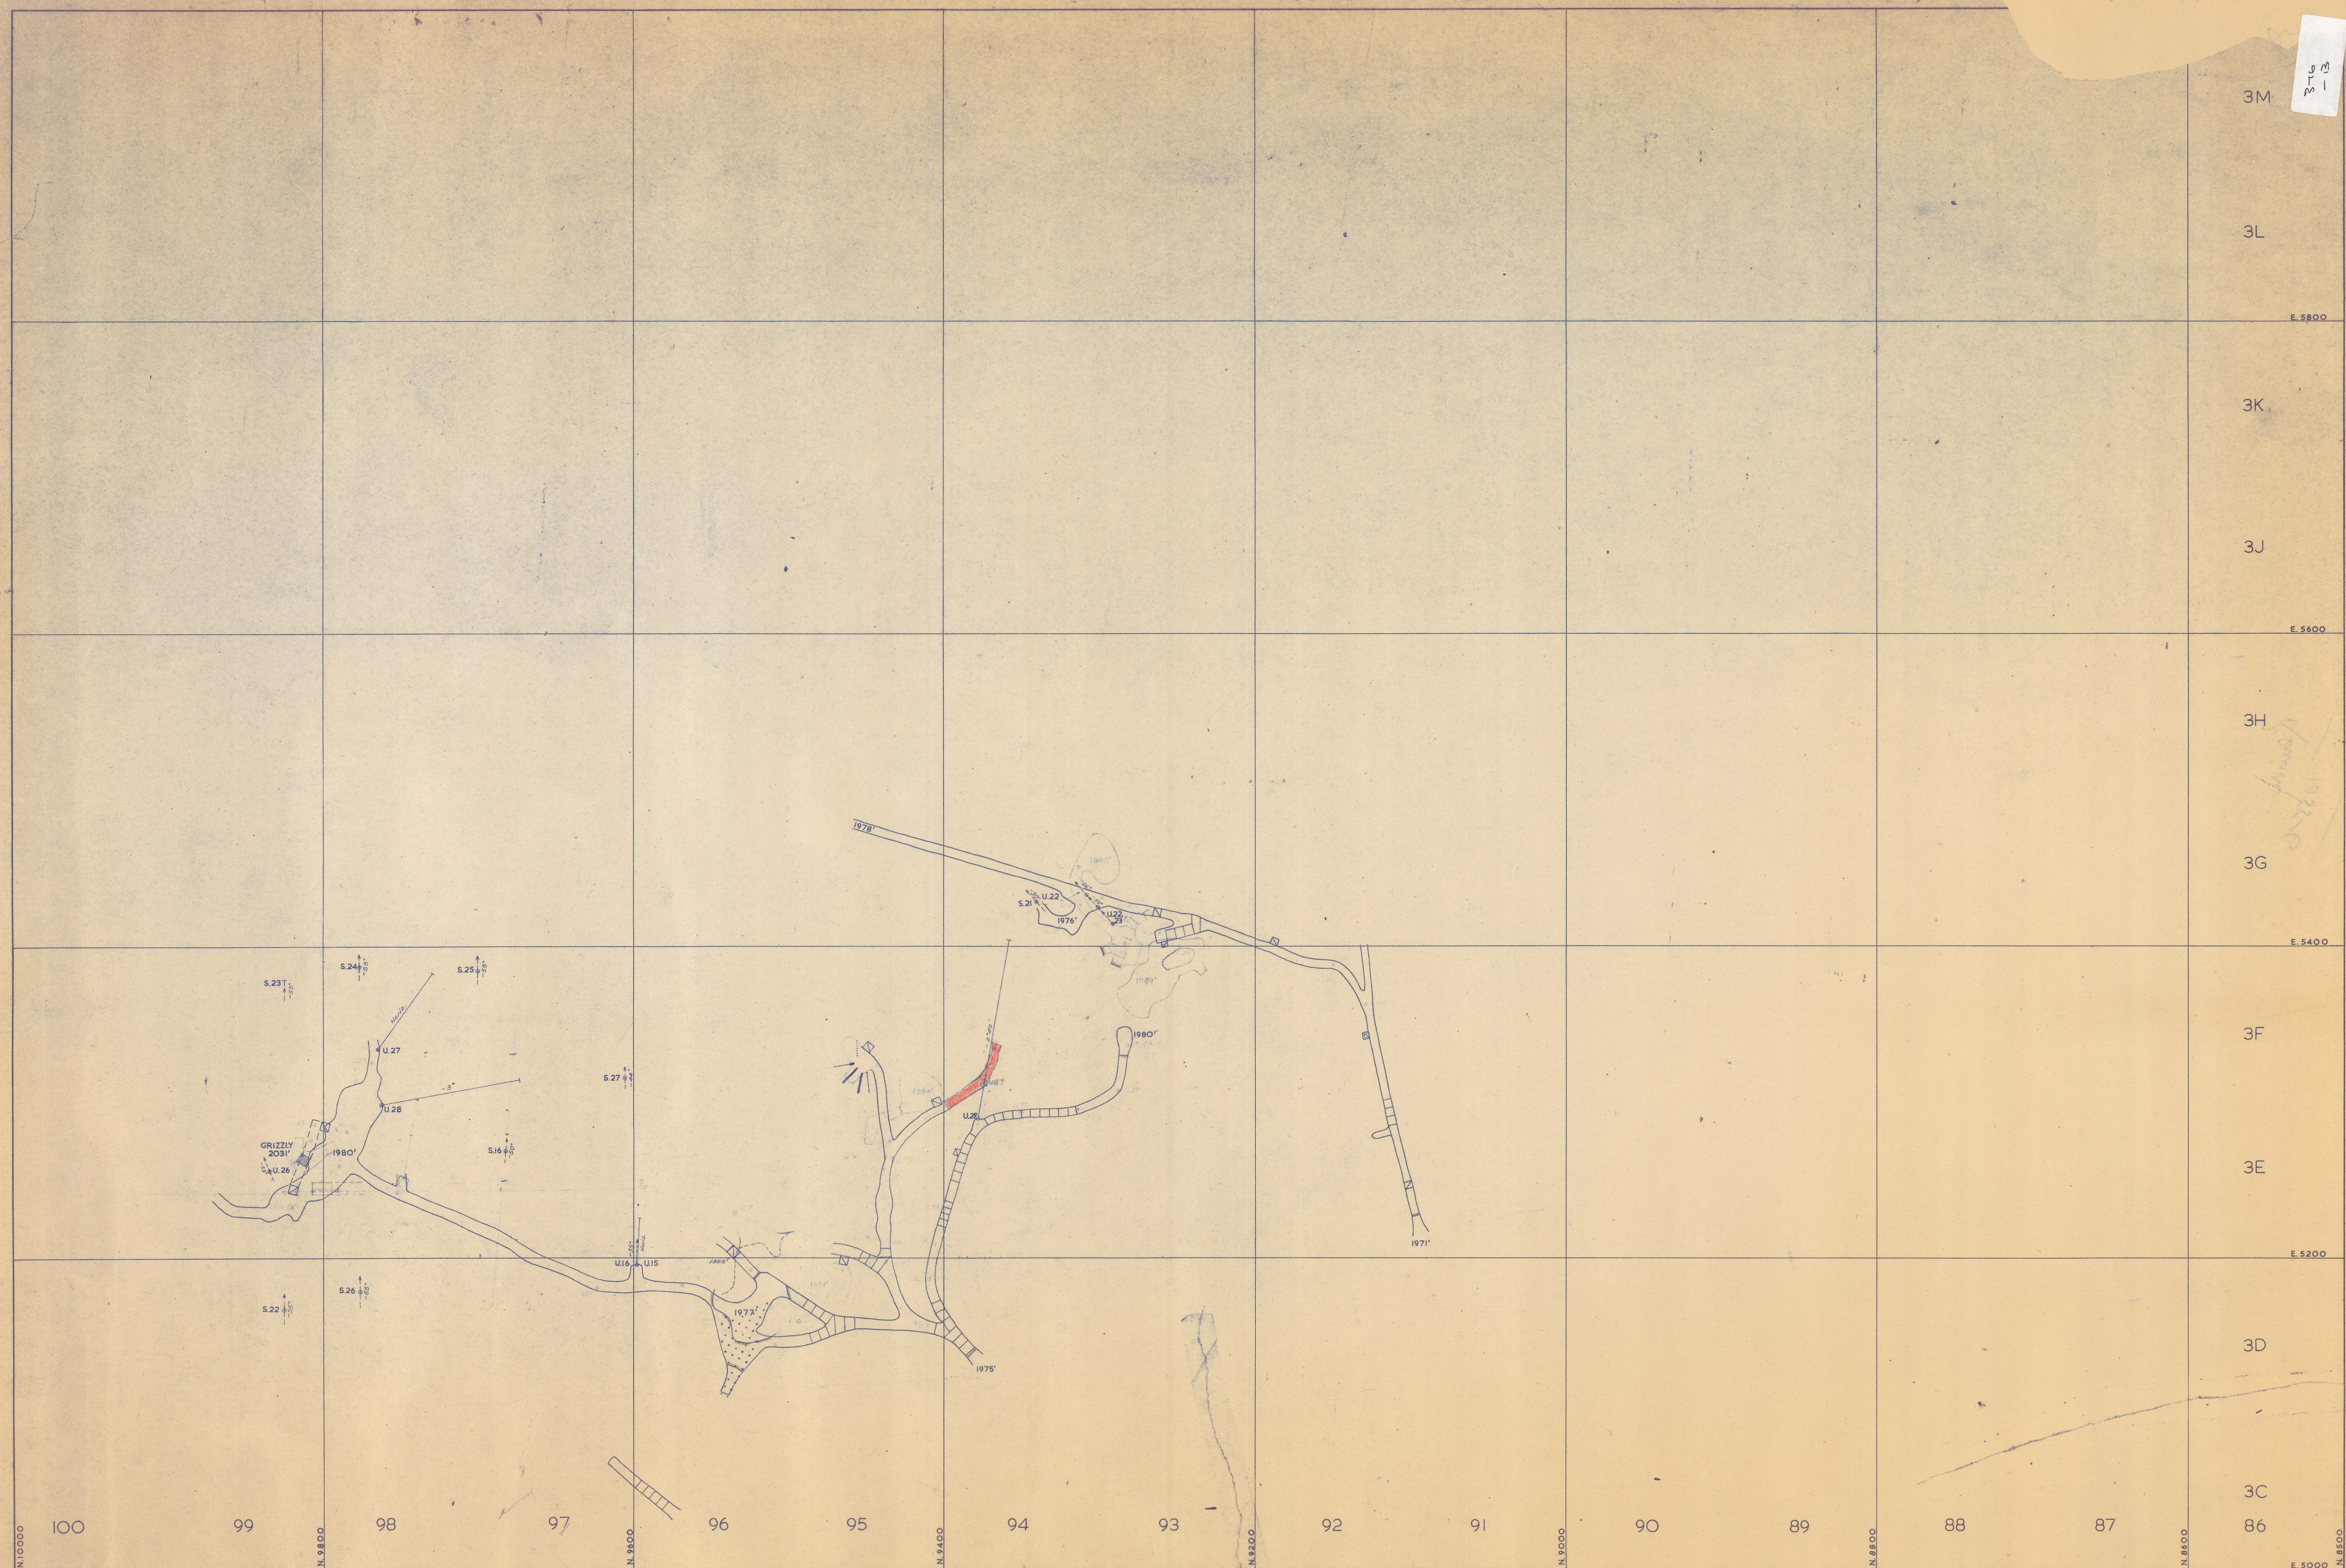

5 cm

Work done July '56 to April '57

1975 LEVEL - BATTERY WORKINGS

REINSON ASSOCIATED TIN MINES, N.L.

Surveyed by M.S.

PLAN NO. **G.6**
SCALE: 1 inch = 40 feet