


376
-17

376
-17

54' 1/2 D.D. S33

DD S33

DD S34

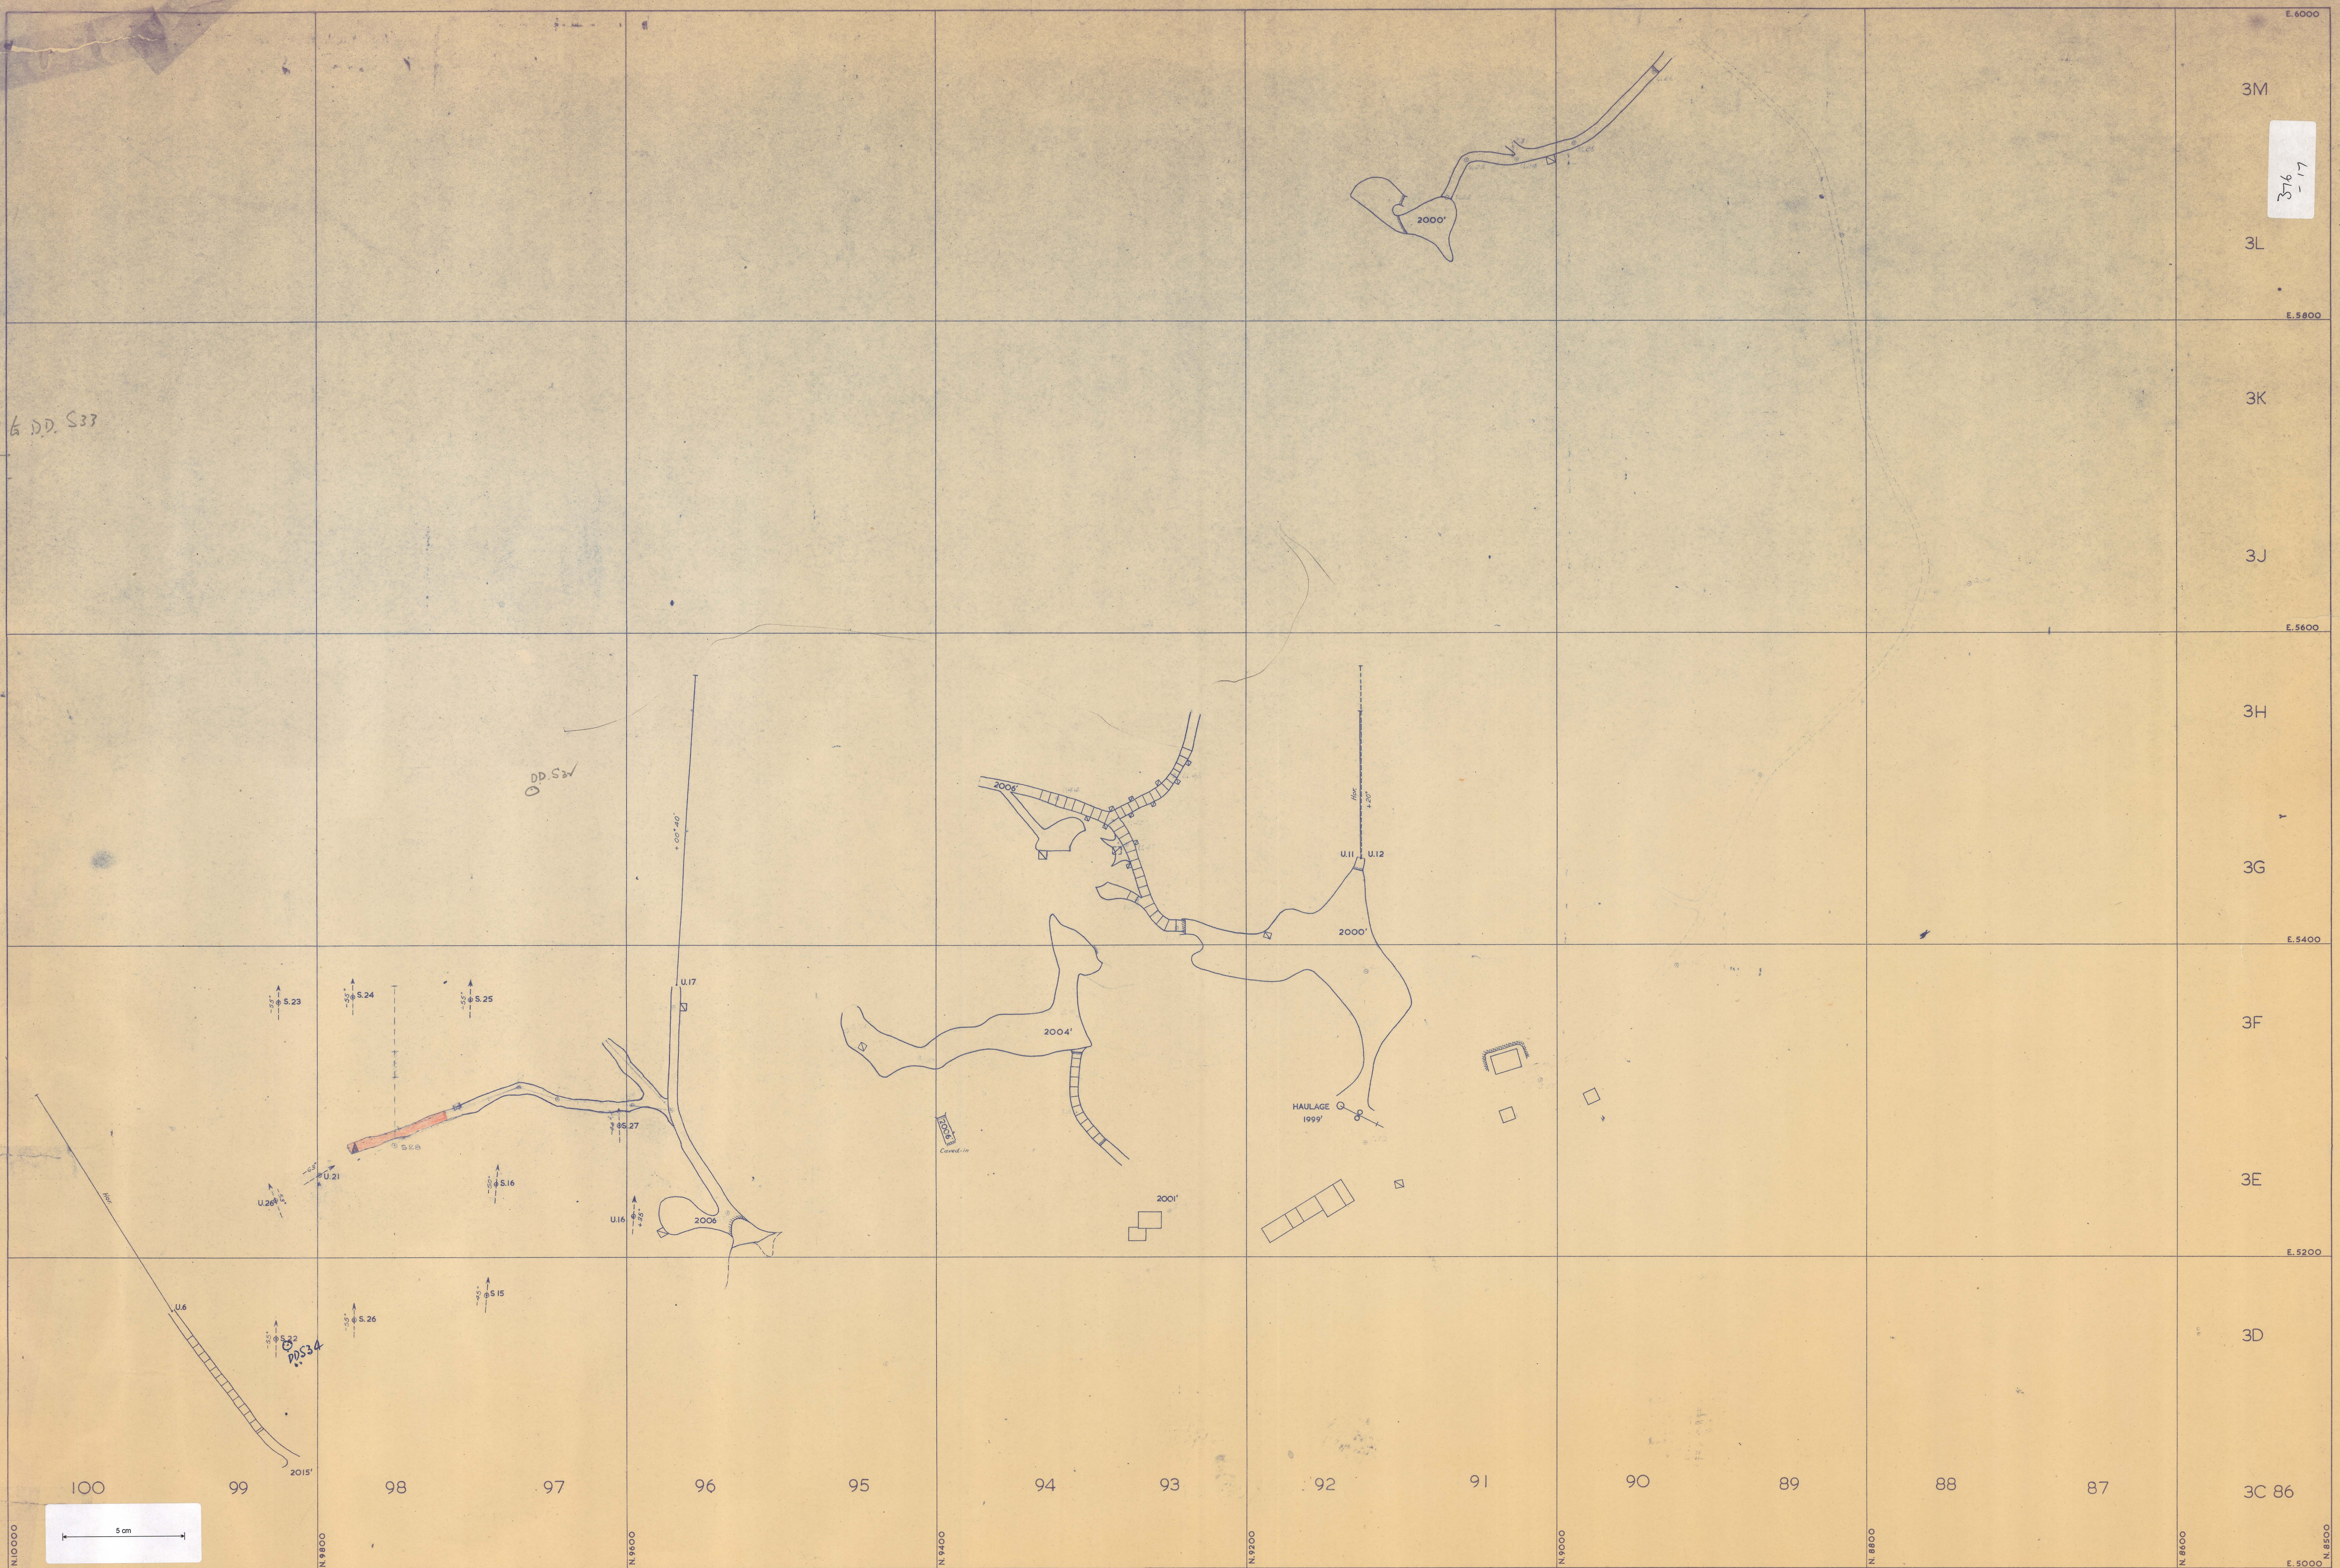

Work done July '56 to April '57

2000 LEVEL - BATTERY WORKINGS

REMSON ASSOCIATED TIN MINES, N.L.

Surveyed by M. S.

PLAN NO. **G.6**
SCALE: 1 inch = 40 feet