


376
-18

376
-18

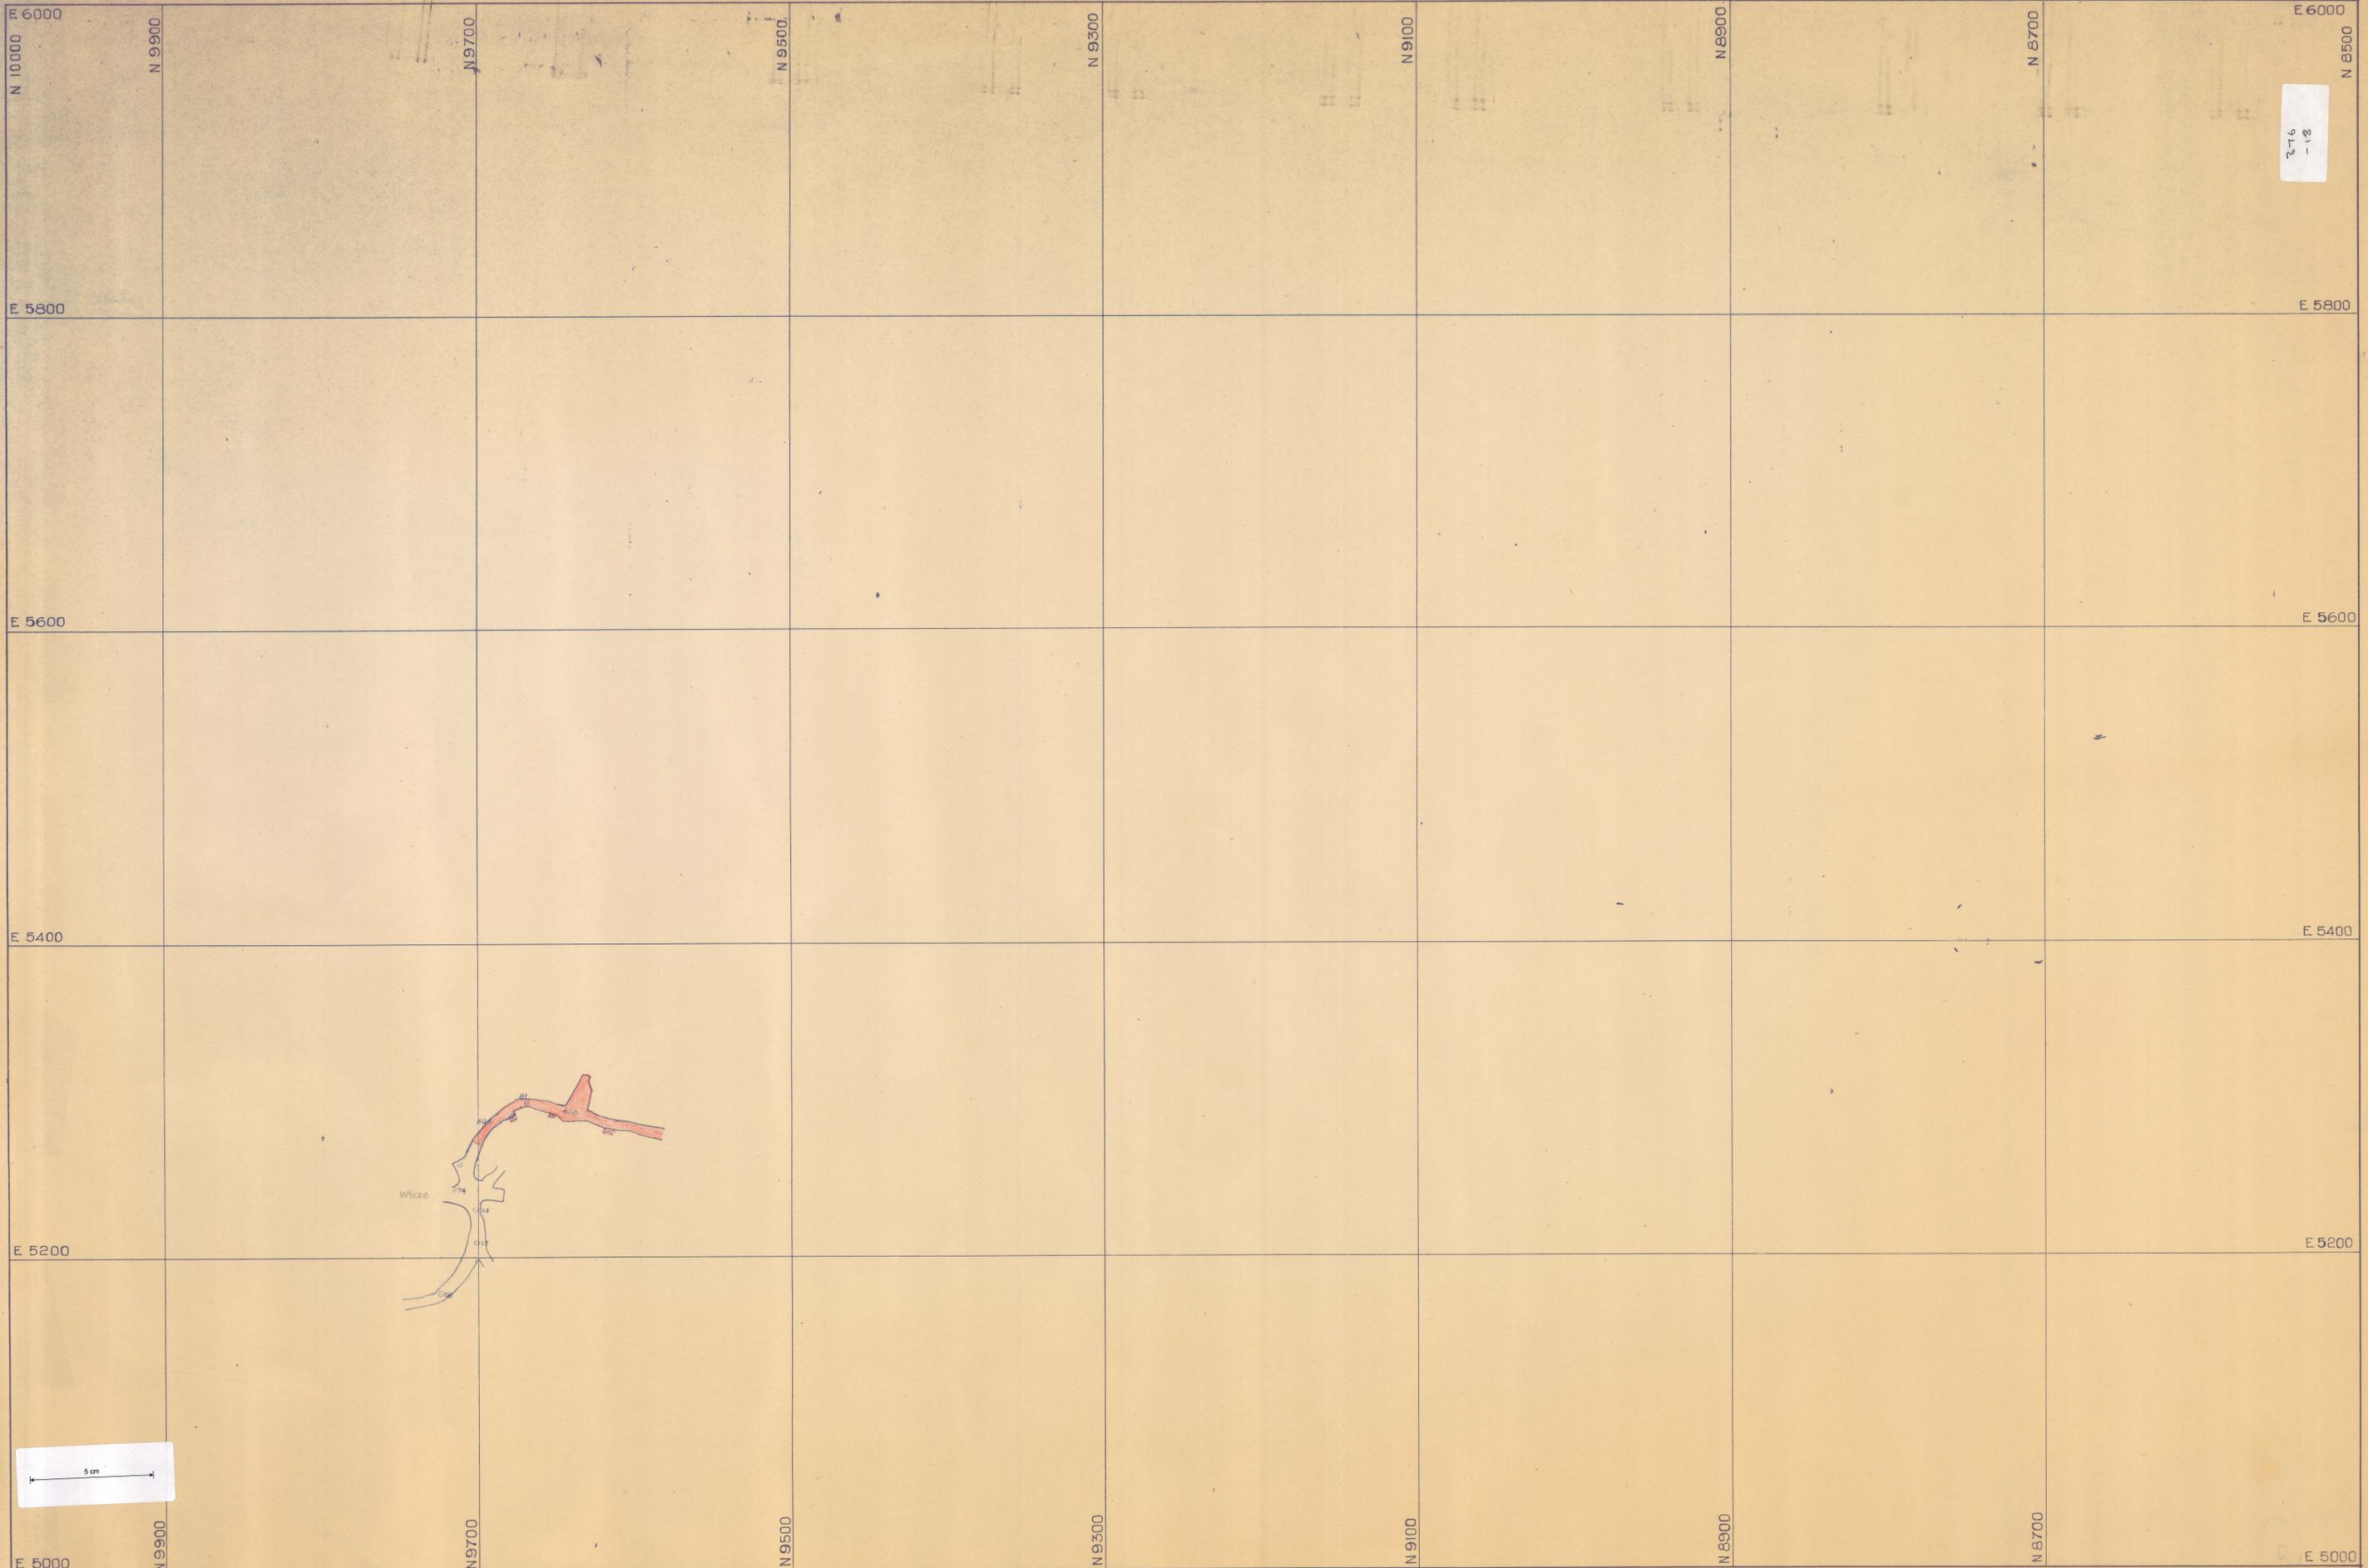

Work done July '56 to April '57

BATTERY WORKINGS

1900' LEVEL

SCALE 1" = 40'

RENISON ASSOCIATED TIN MINES (N.L.)

RRM-Ghre Feb/57