


-20

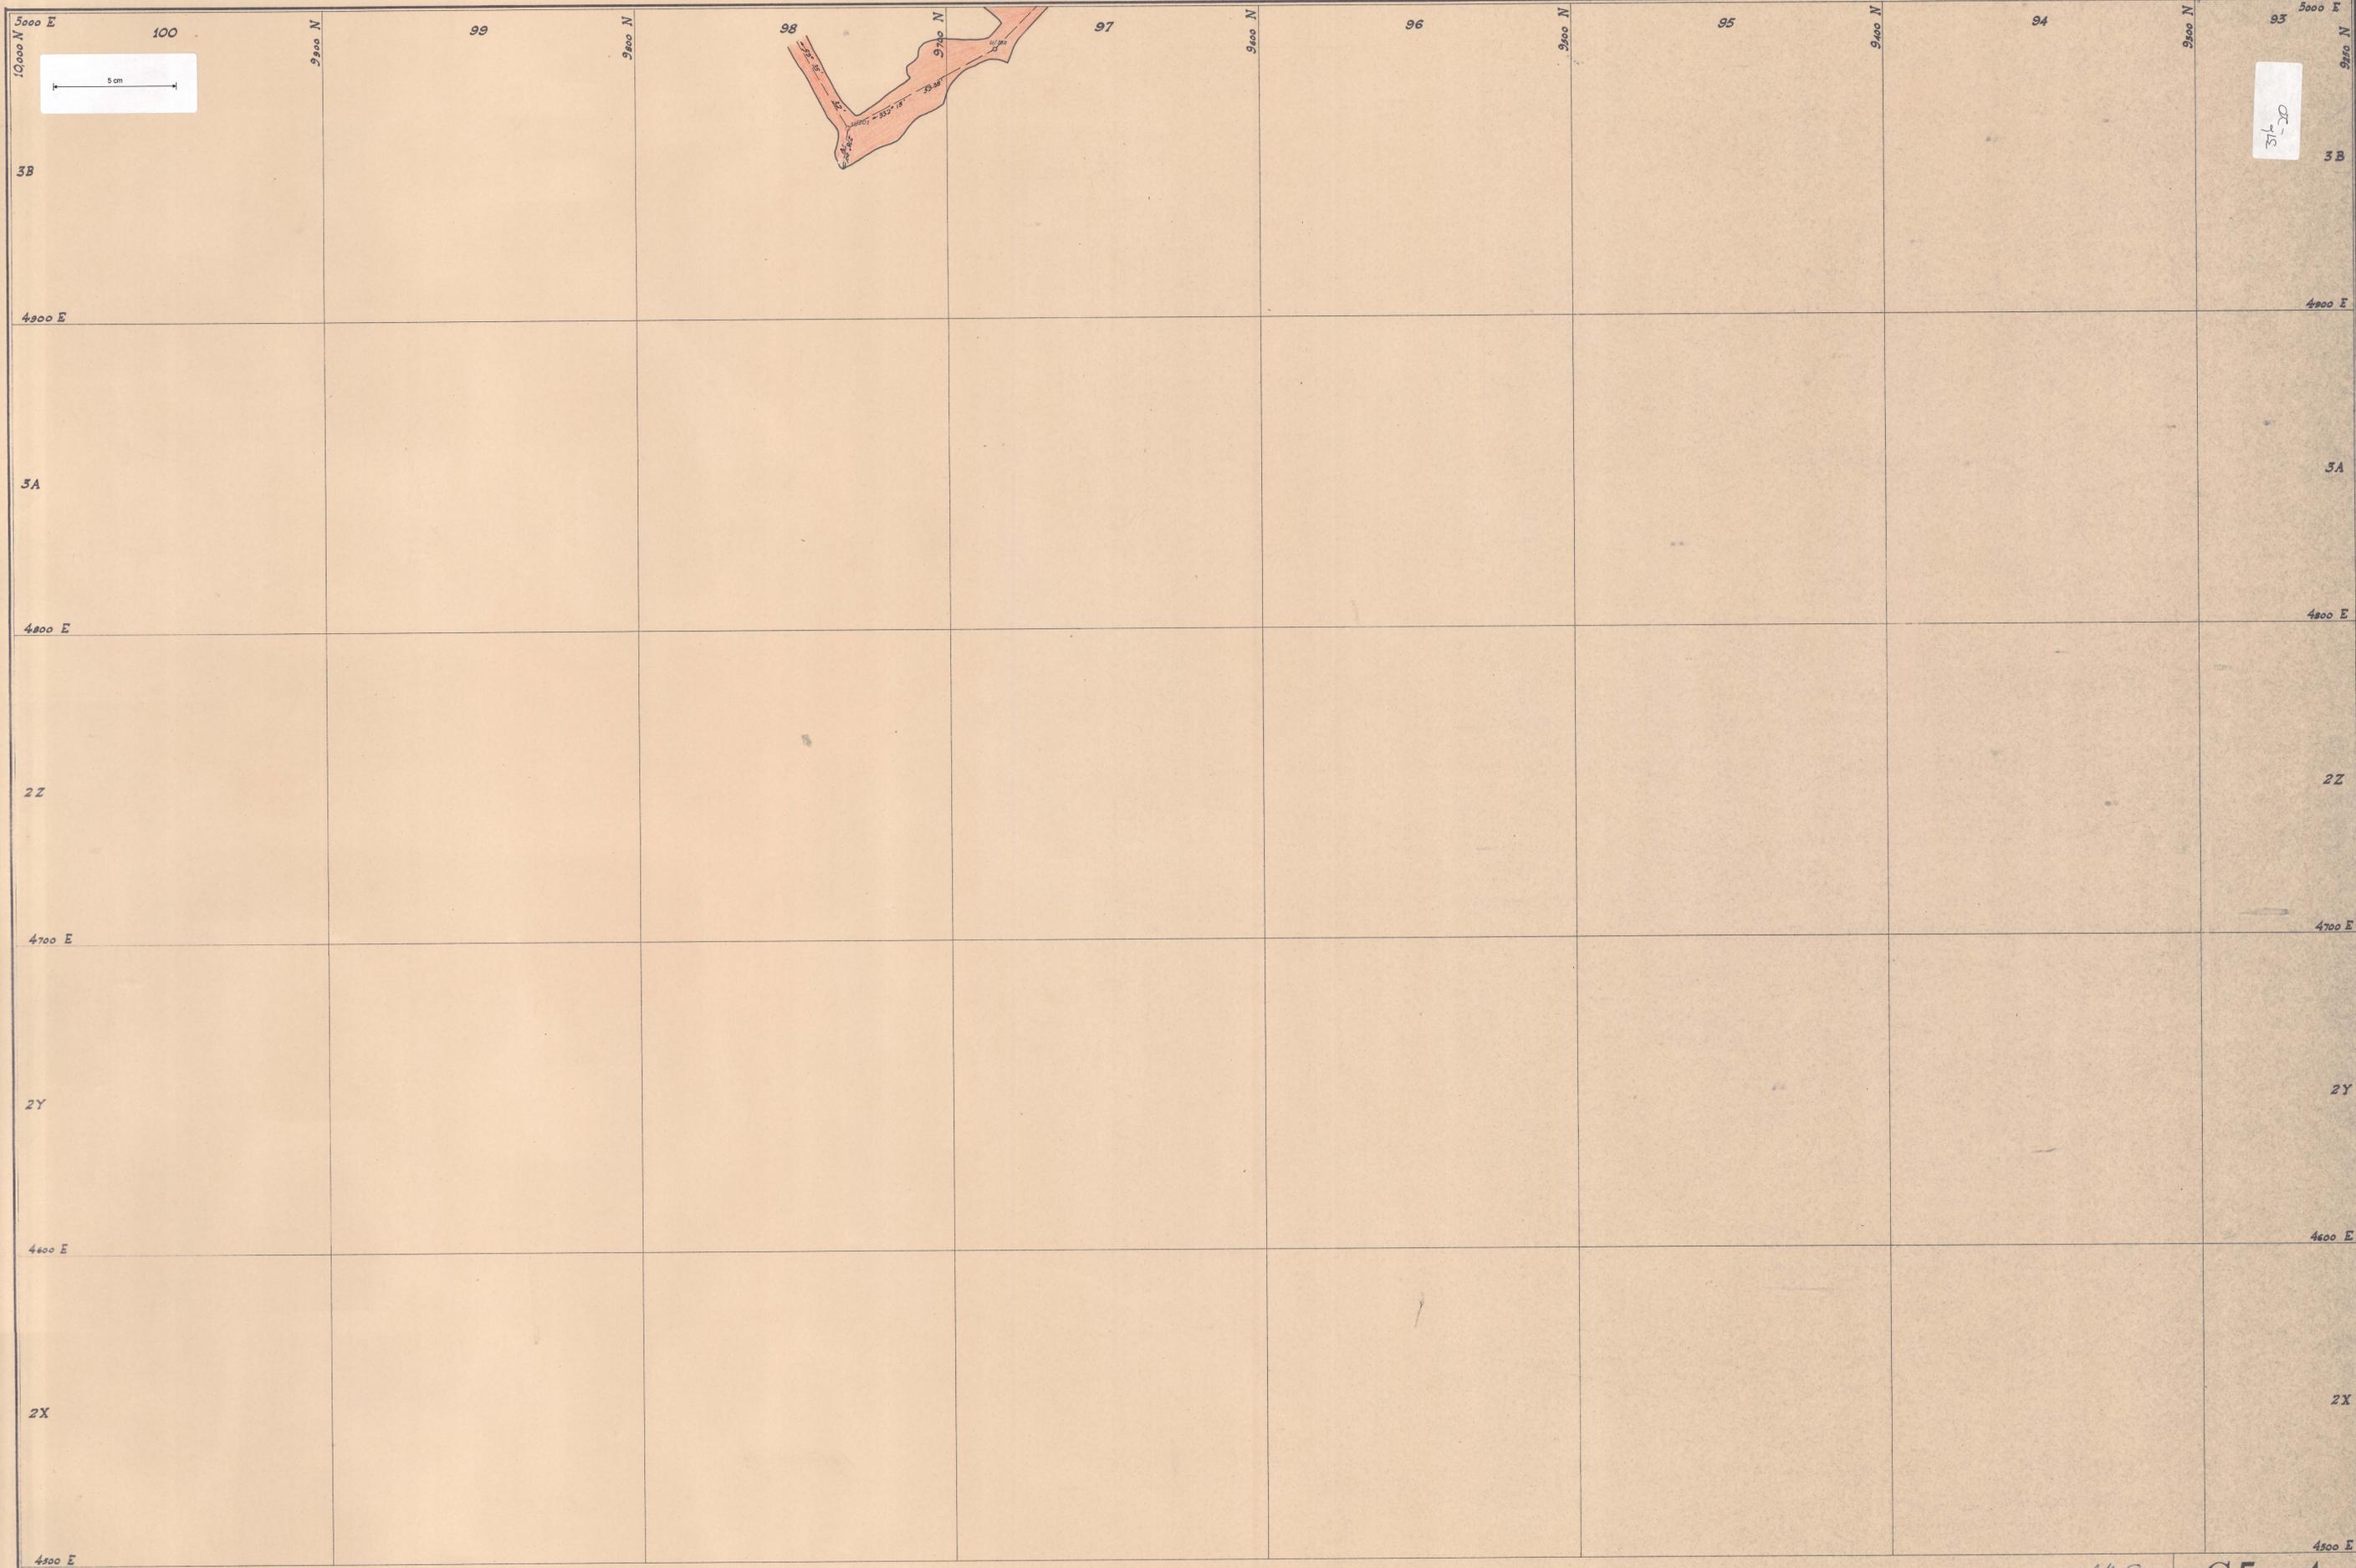

BATTERY WORKINGS — 1892 LEVEL

Workings For Year Ended
31-12-60 Shown In. Red.

Mine Manager. — *[Signature]*
Mine Surveyor. — *[Signature]*

G5-1
Scale—1 inch = 20 feet