


3-16
-21

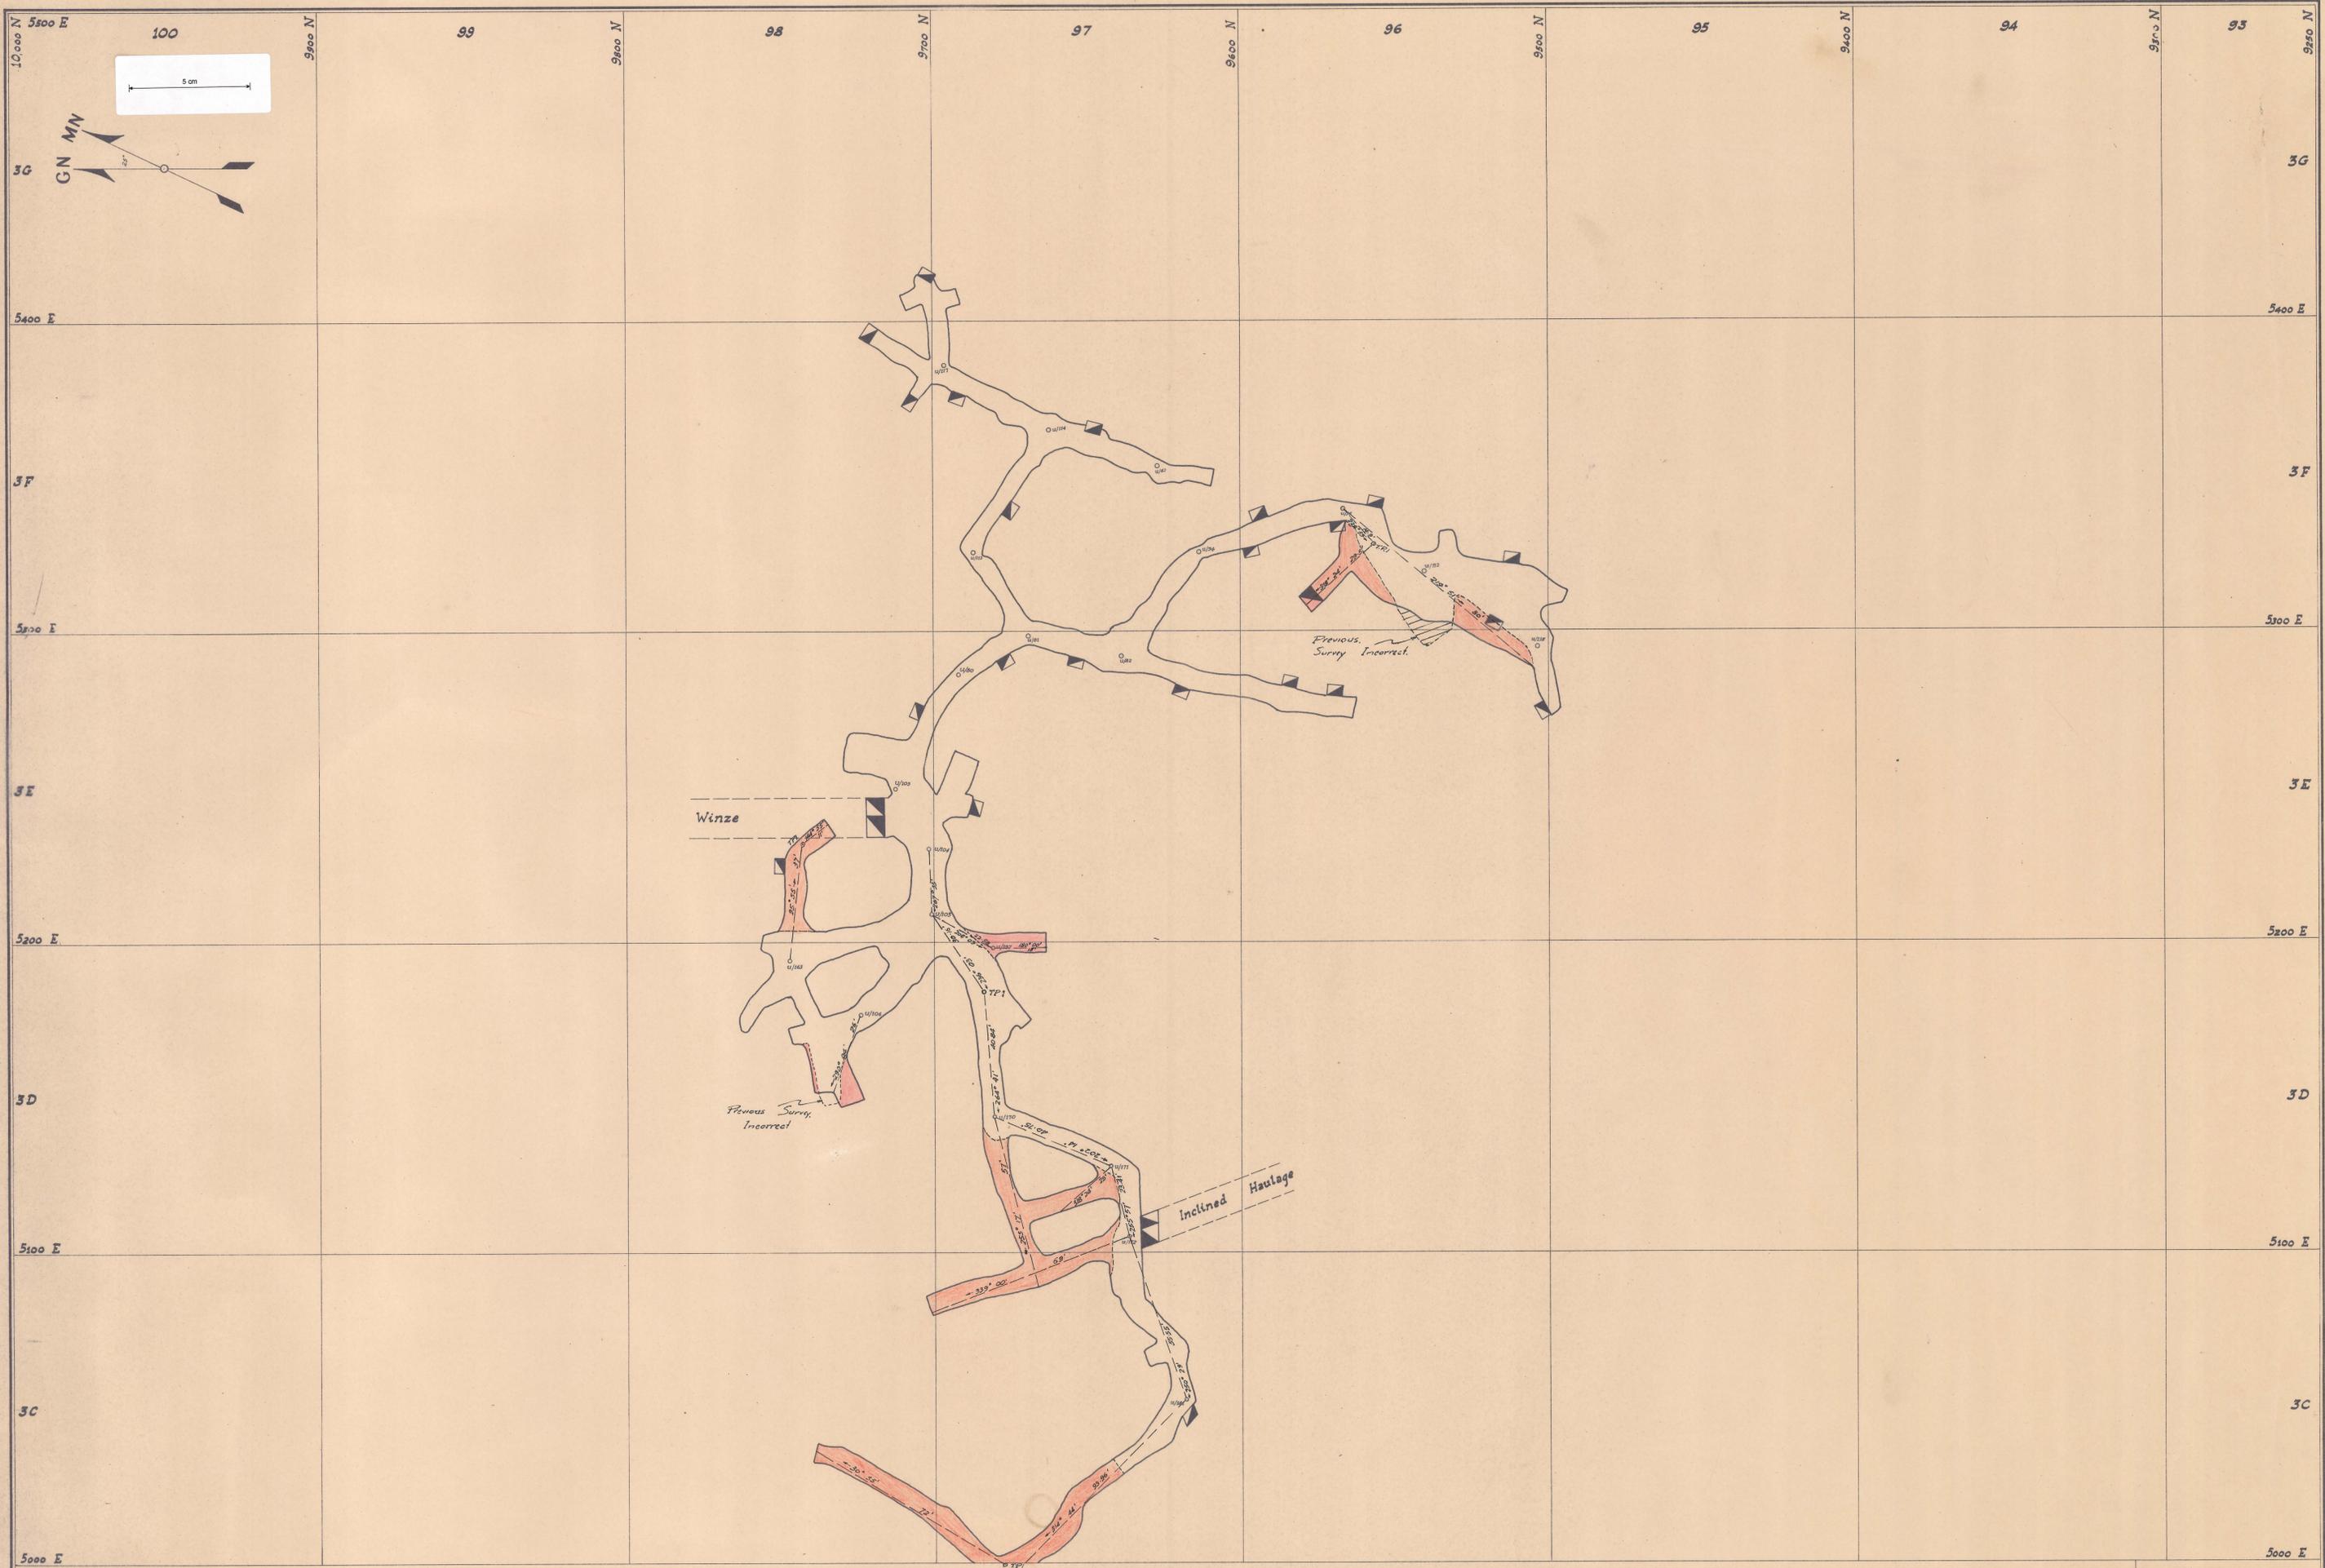

BATTERY WORKINGS — 1892 LEVEL

Workings For Year Ended
30-12-1960 Shown In Red

Mine Manager — *[Signature]*
Mine Surveyor — *[Signature]*

G6-3

Scale — 1 inch = 20 feet