


376
-22

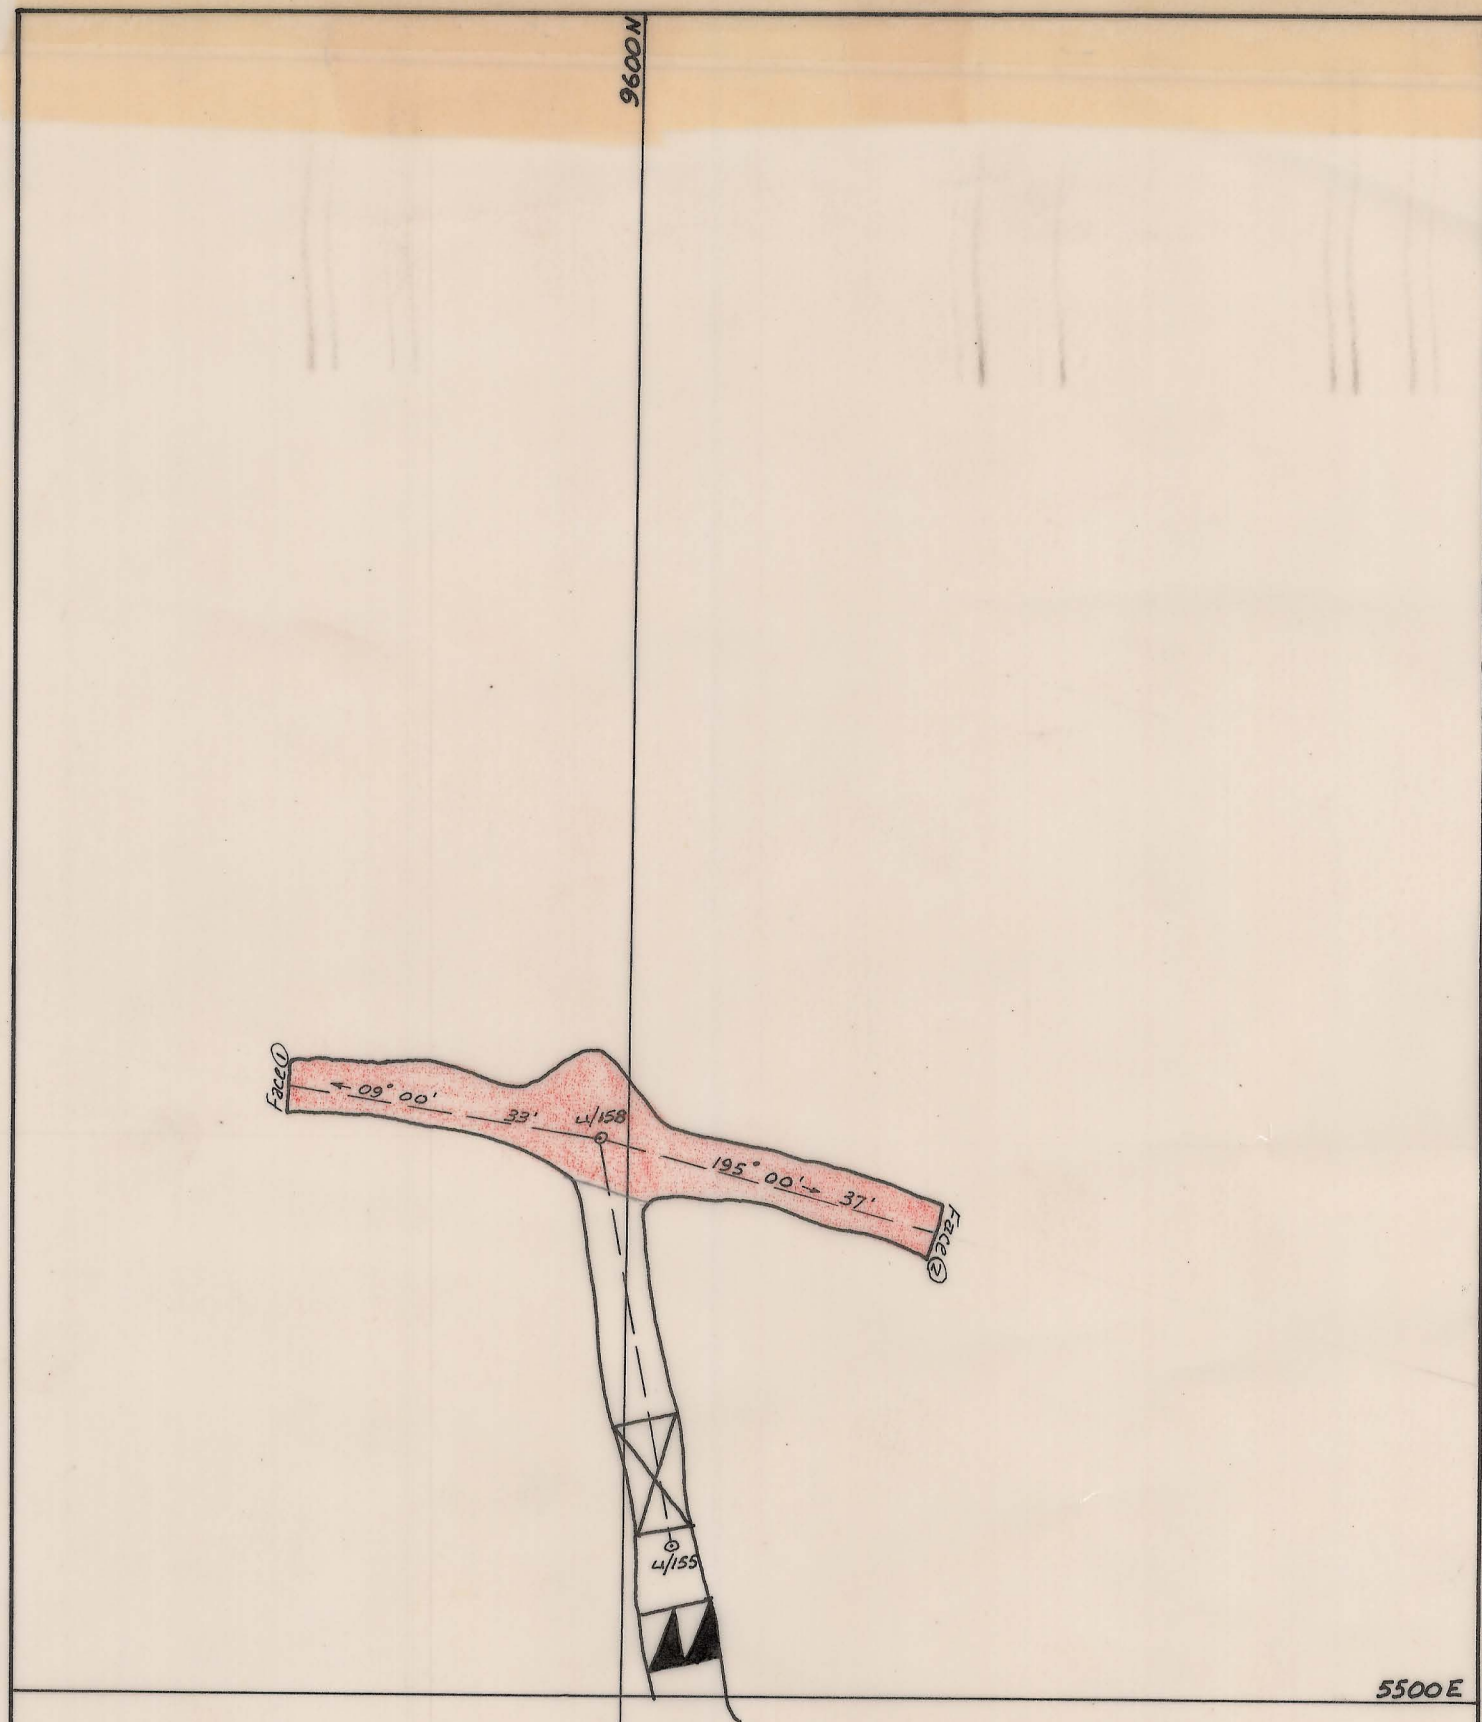

376
-22

WORKINGS. FOR YEAR.
ENDED 31/12/60. SHOWN IN RED.

Mine Manager. — *Ally*
Mine Surveyor. — *P. Lawndale*

R.A.T.M.: N.L.
Winze Workings
34/96 S/L.
1932 S/L
Scale 1"=20'