
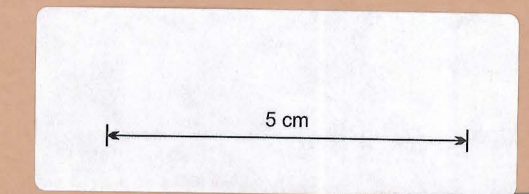


0376-034

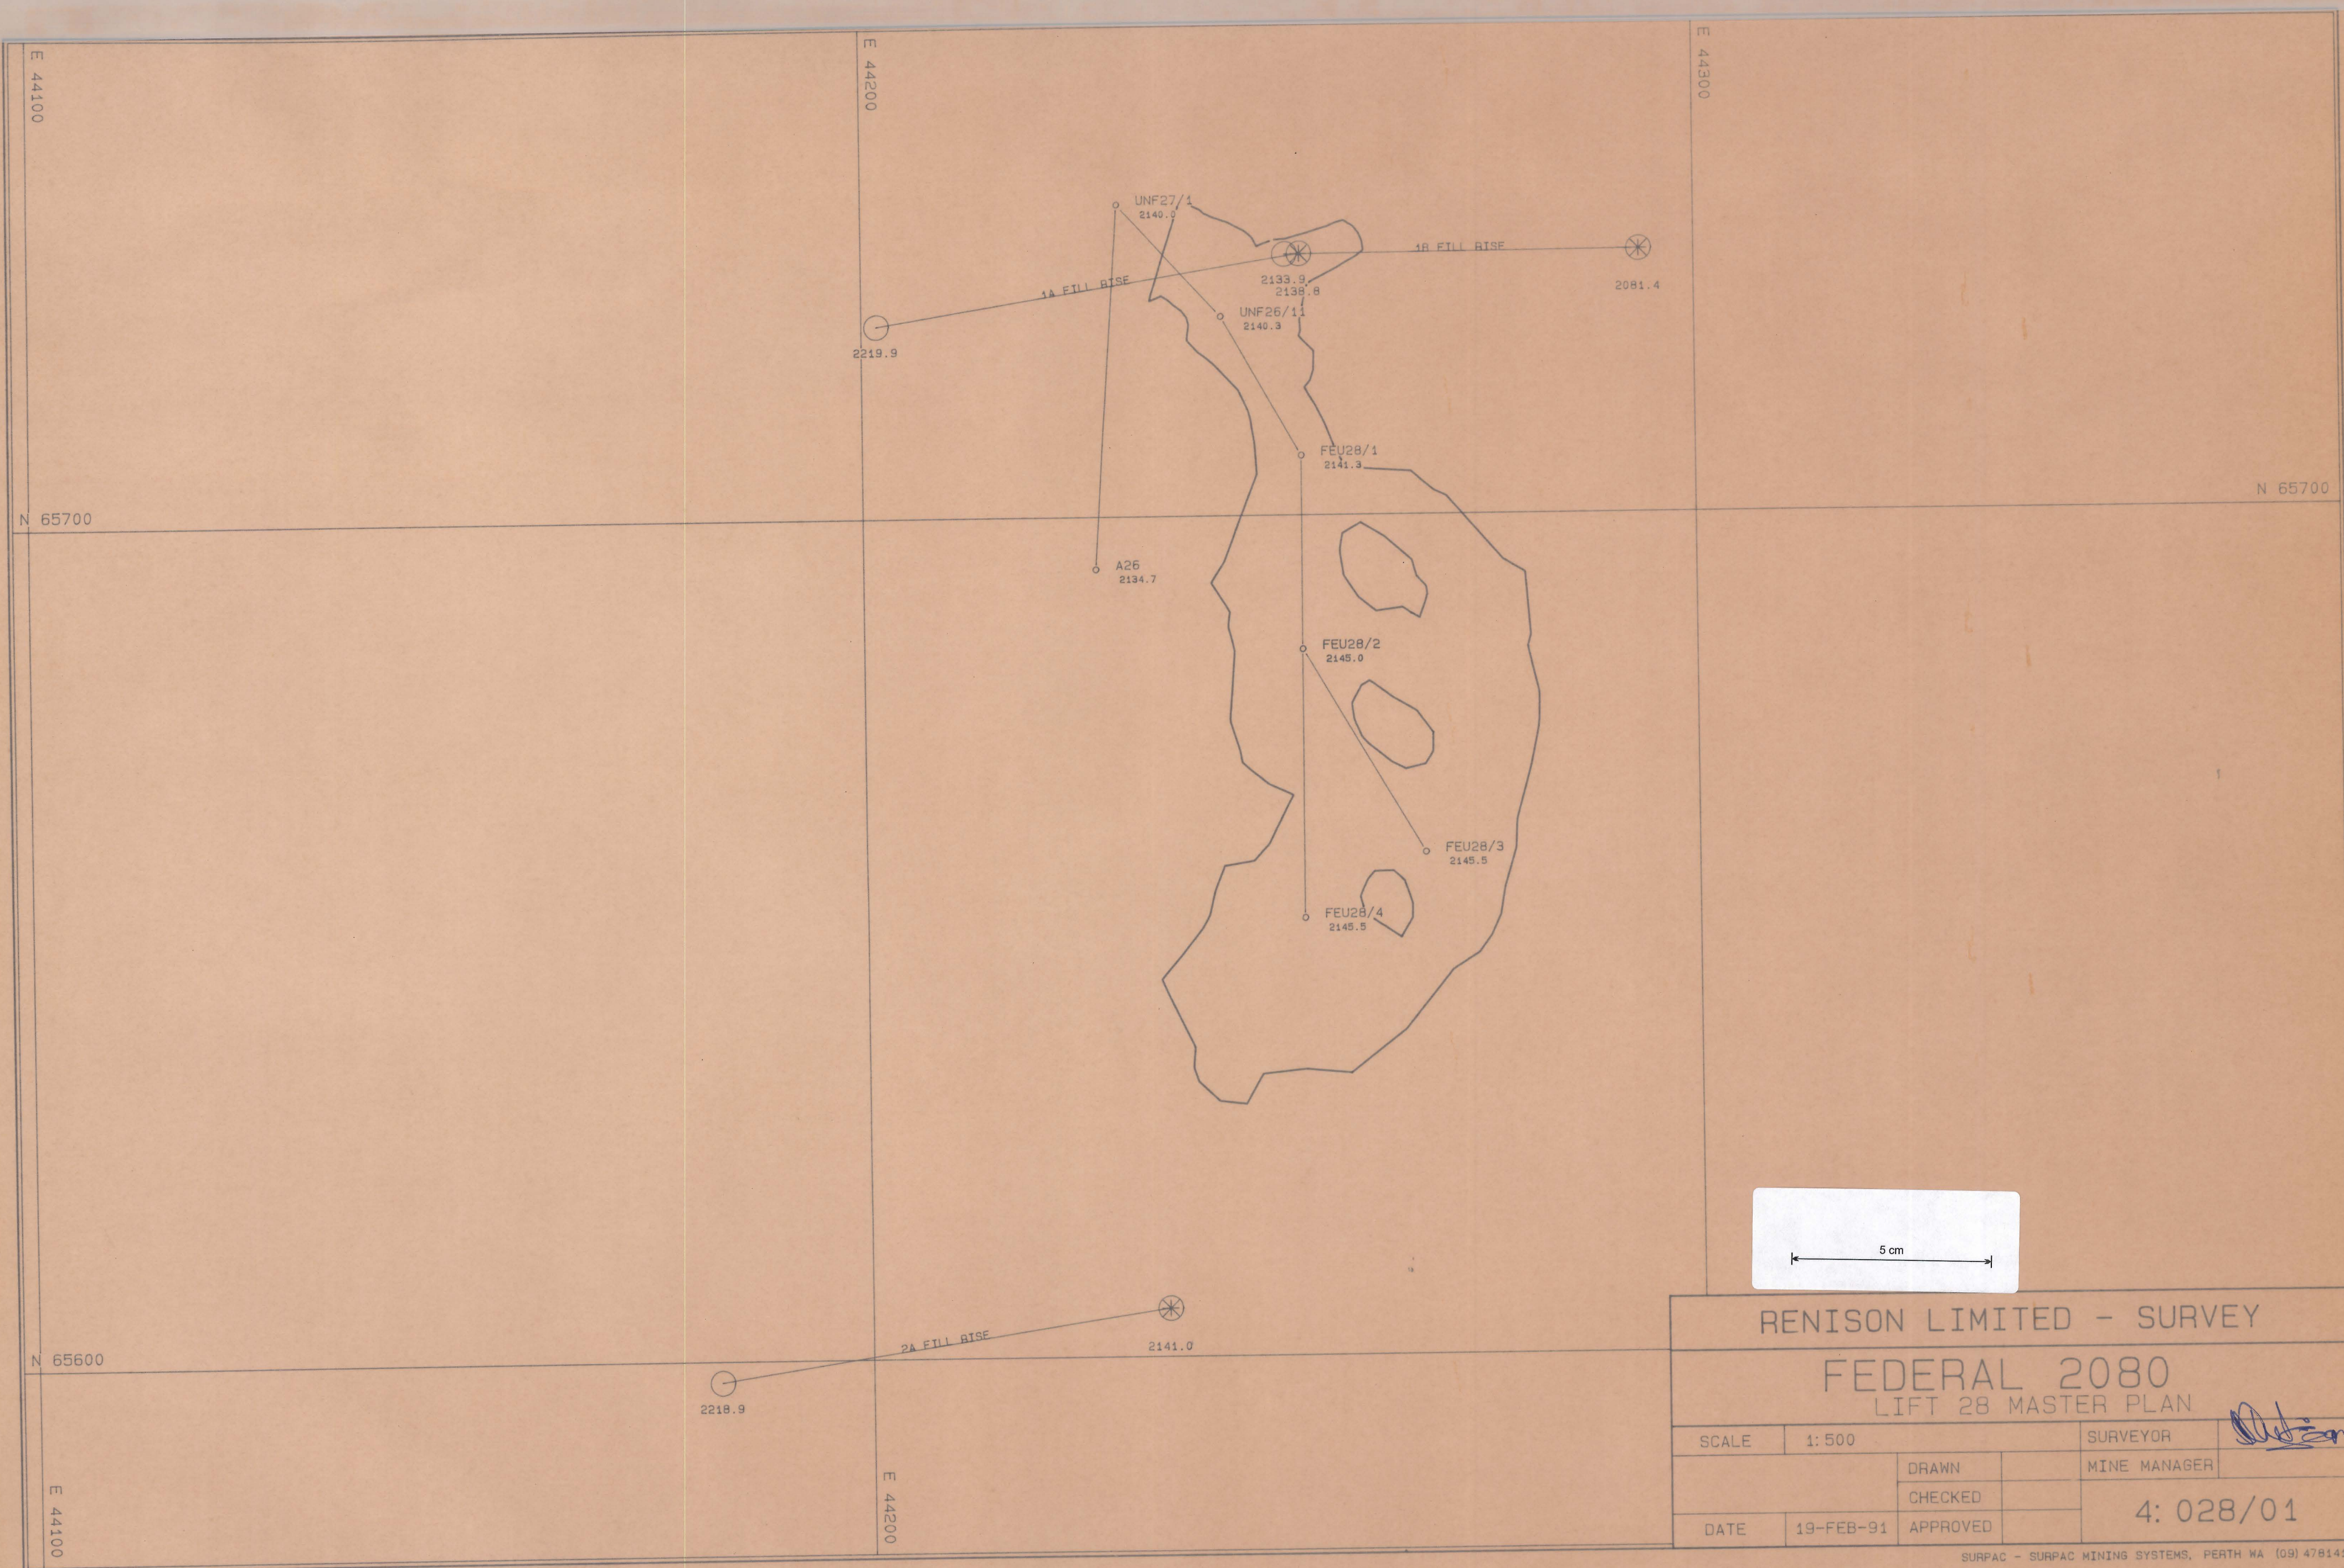

RENISON LIMITED - SURVEY			
FEDERAL 2080			
LIFT 28 MASTER PLAN			
SCALE	1: 500	SURVEYOR	<i>[Signature]</i>
		DRAWN	
		CHECKED	
DATE	19-FEB-91	APPROVED	4: 028/01