
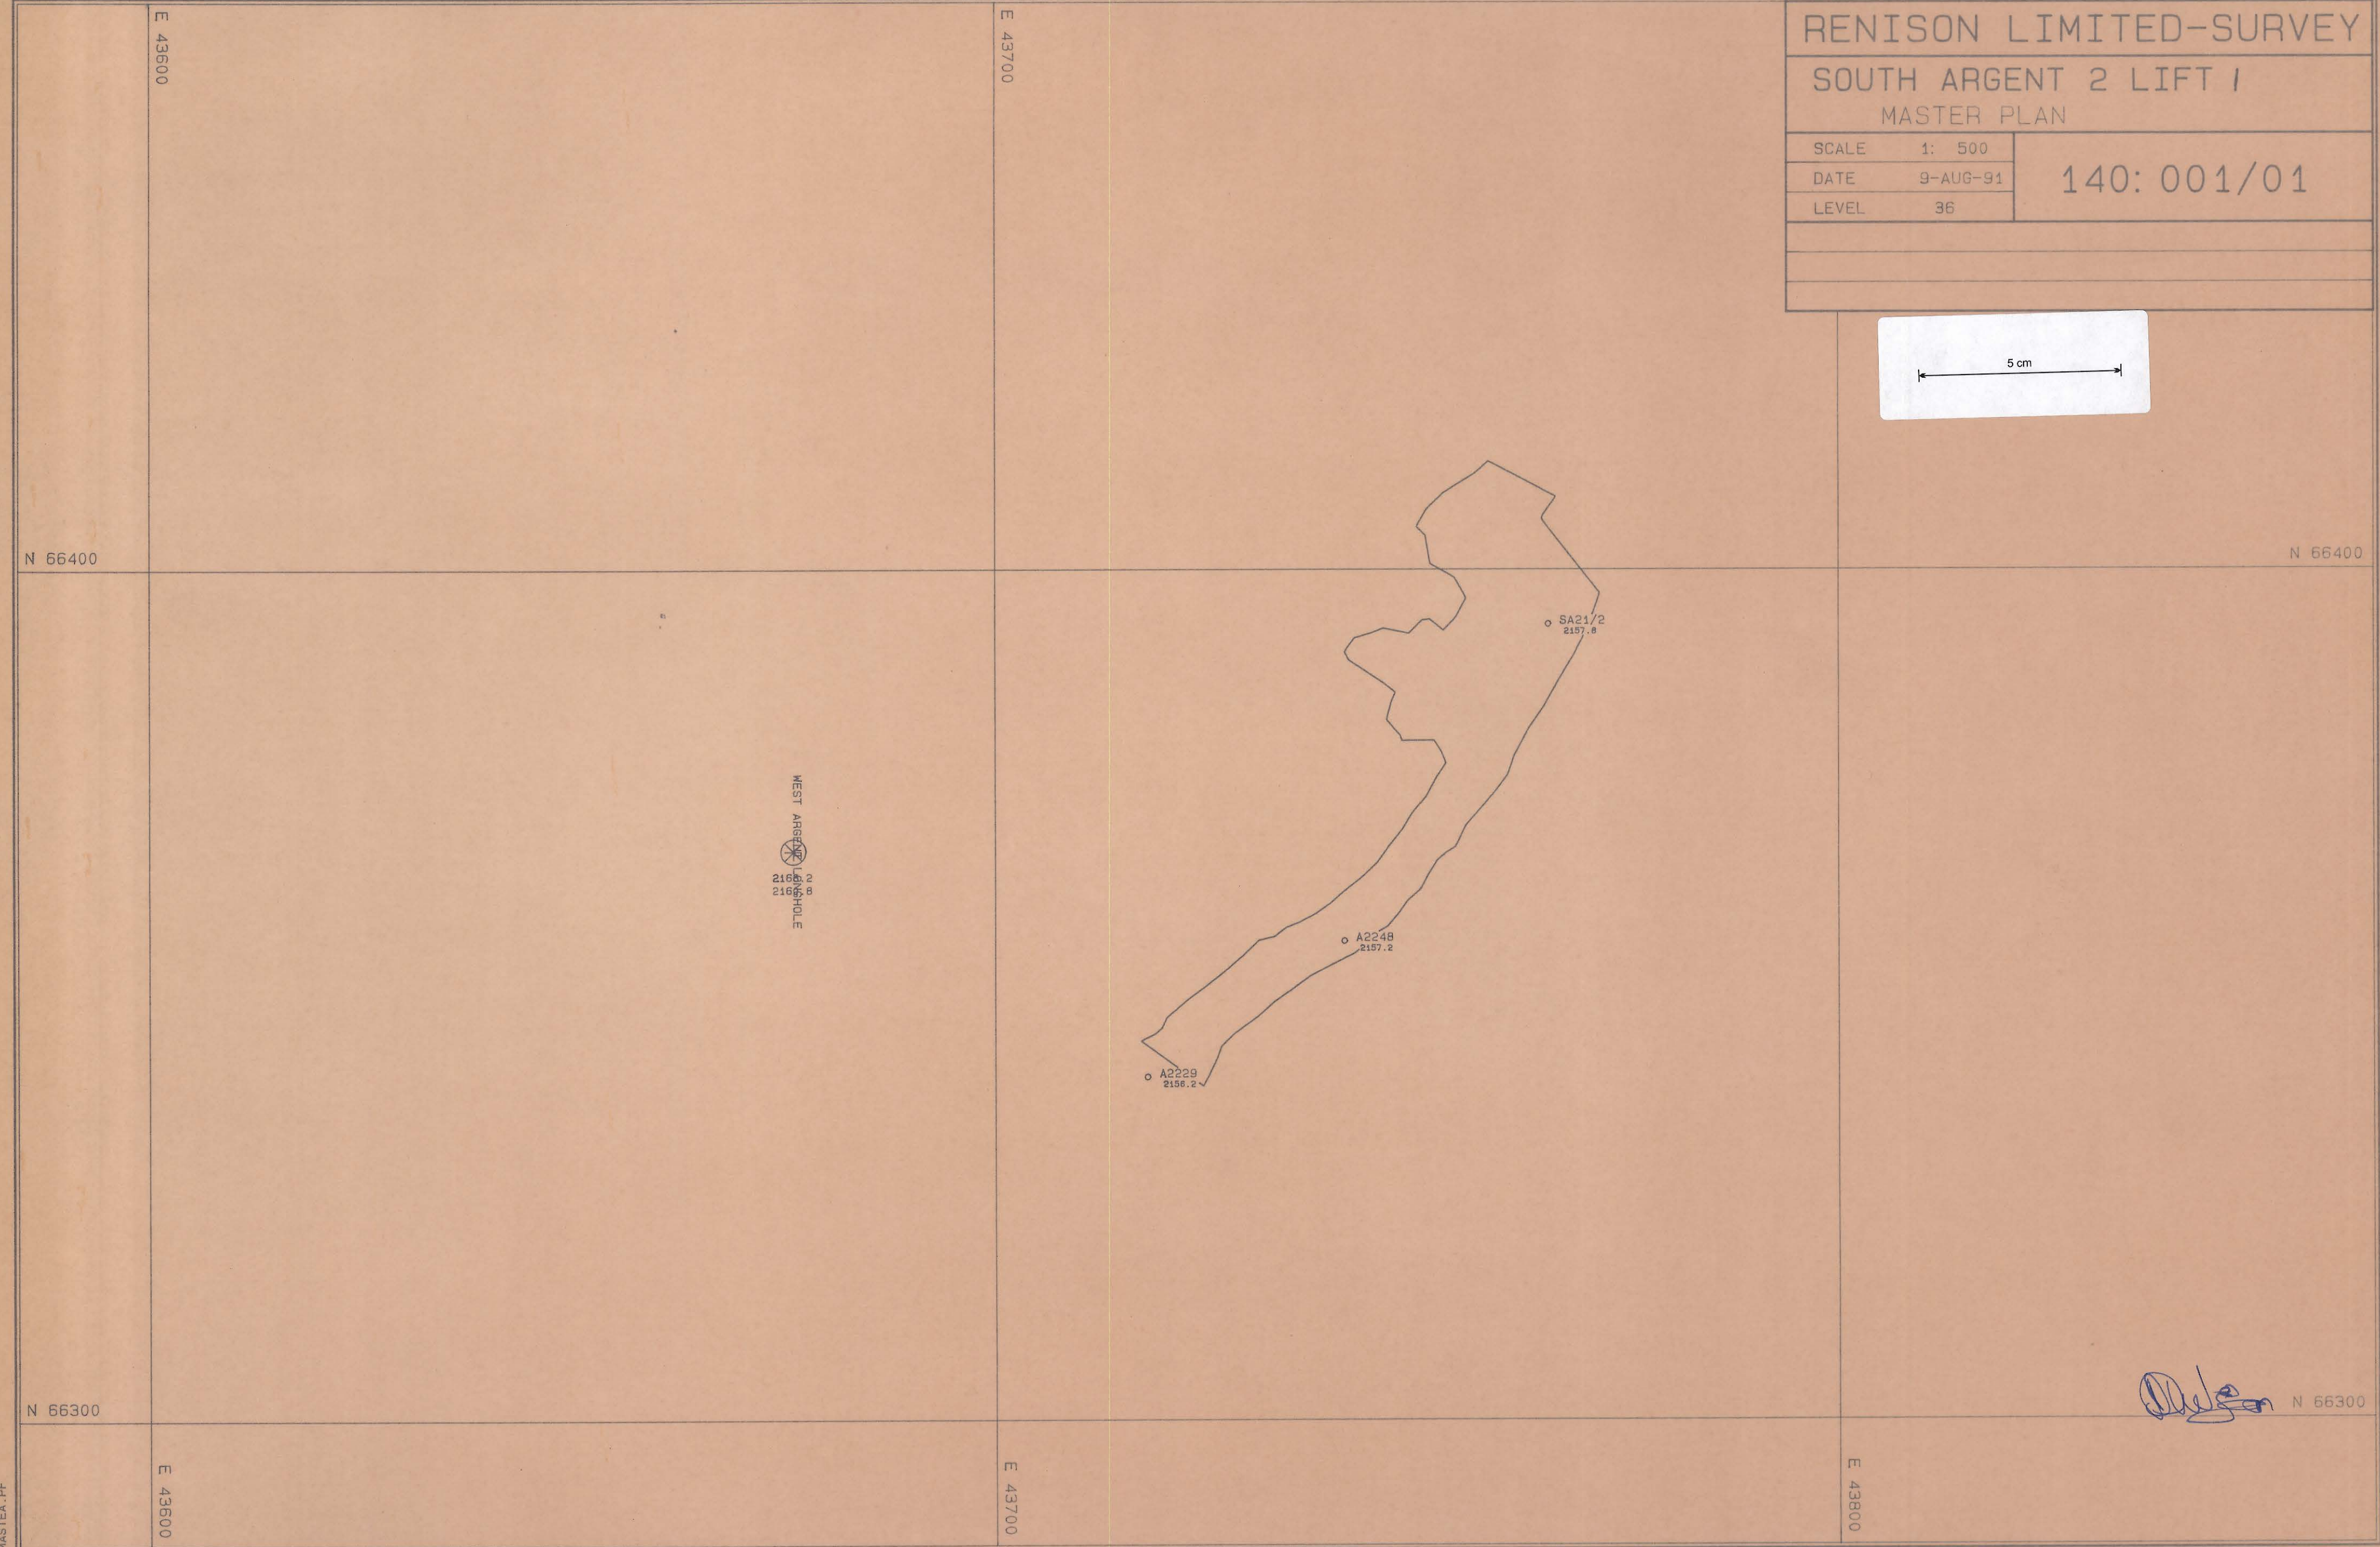


0376-037

RENISON LIMITED-SURVEY

SOUTH ARGENT 2 LIFT 1
MASTER PLAN

SCALE	1: 500	140: 001/01
DATE	9-AUG-91	
LEVEL	36	

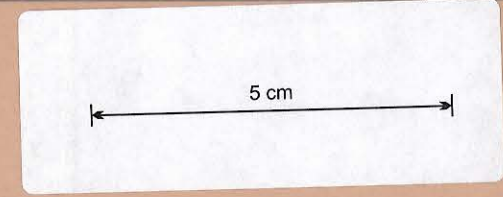

[Signature] N 66300

MASTEA.PF