


0376-043

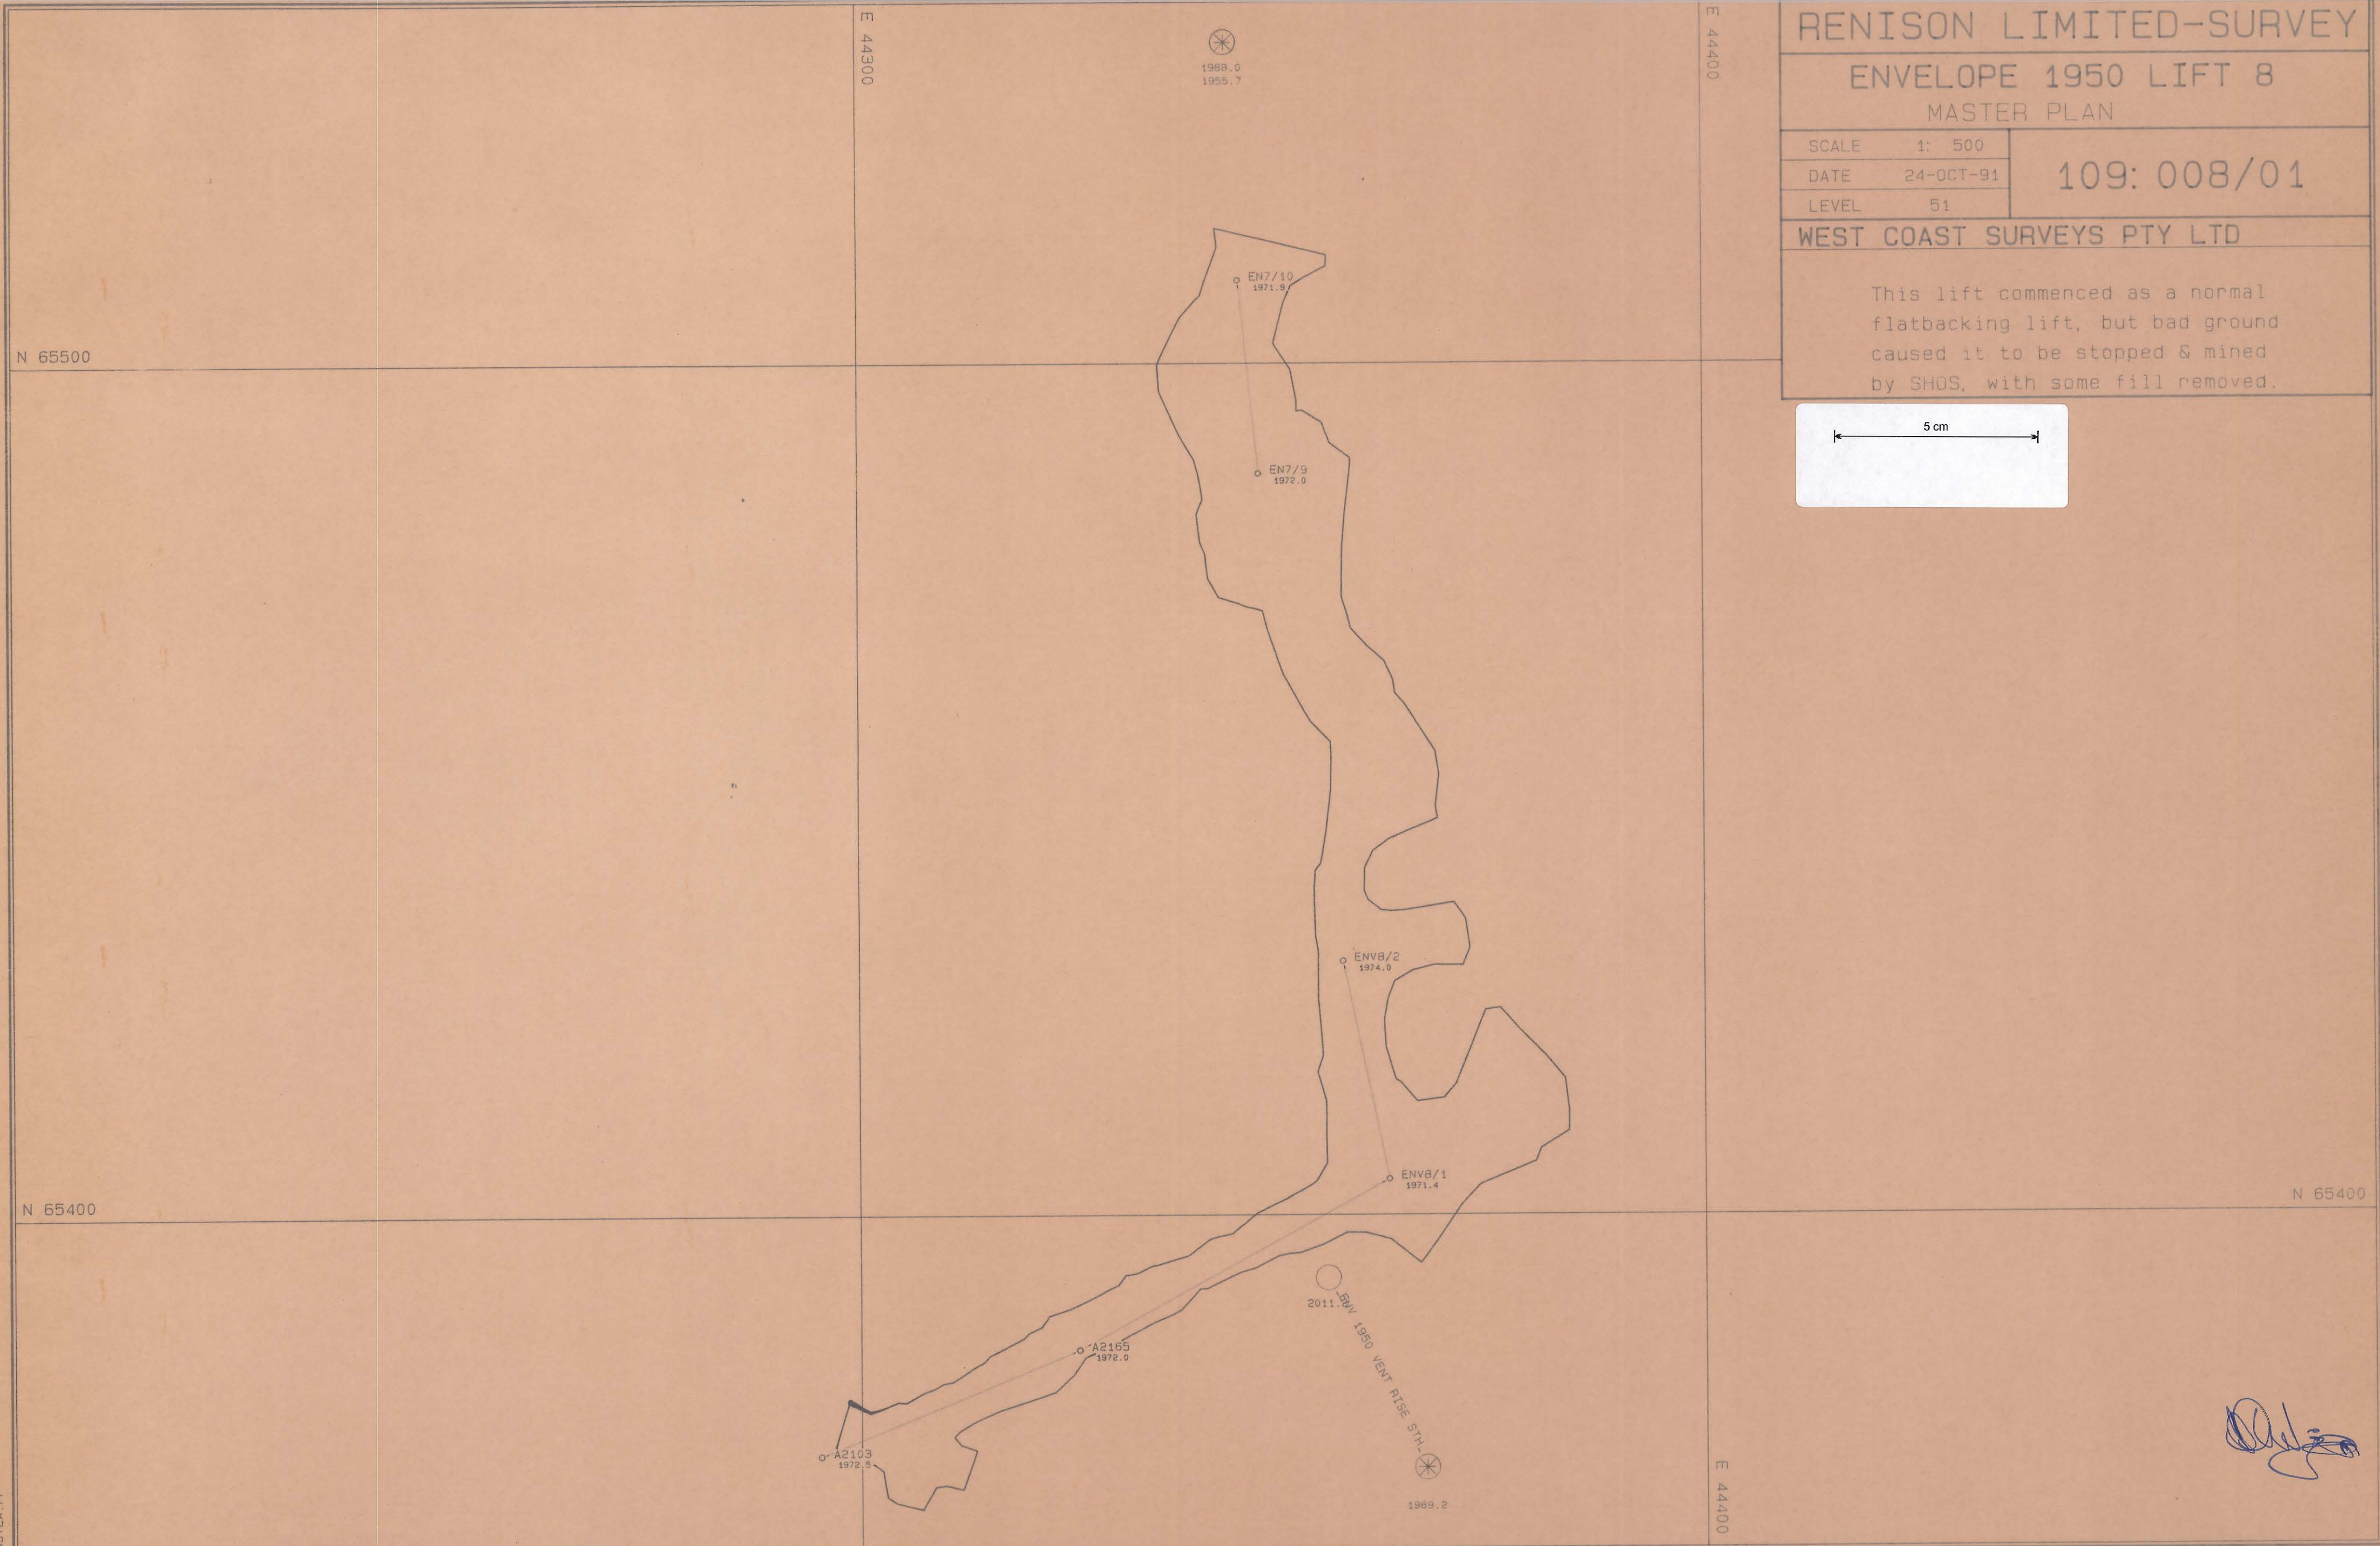

RENISON LIMITED-SURVEY

ENVELOPE 1950 LIFT 8

MASTER PLAN

SCALE 1: 500

DATE 24-OCT-91

LEVEL 51

109: 008/01

WEST COAST SURVEYS PTY LTD

This lift commenced as a normal flatbacking lift, but bad ground caused it to be stopped & mined by SHOS, with some fill removed.

[Signature]