

0376-044

RENISON LIMITED-SURVEY

3C RISE PILLAR LIFT MASTER PLAN

SCALE	1: 500
DATE	18-OCT-91
LEVEL	61

191: 001/01

5 cm

N 66000

N 66000

E 44200


E 44300

E 44200

E 44300

N 65900

N 65900

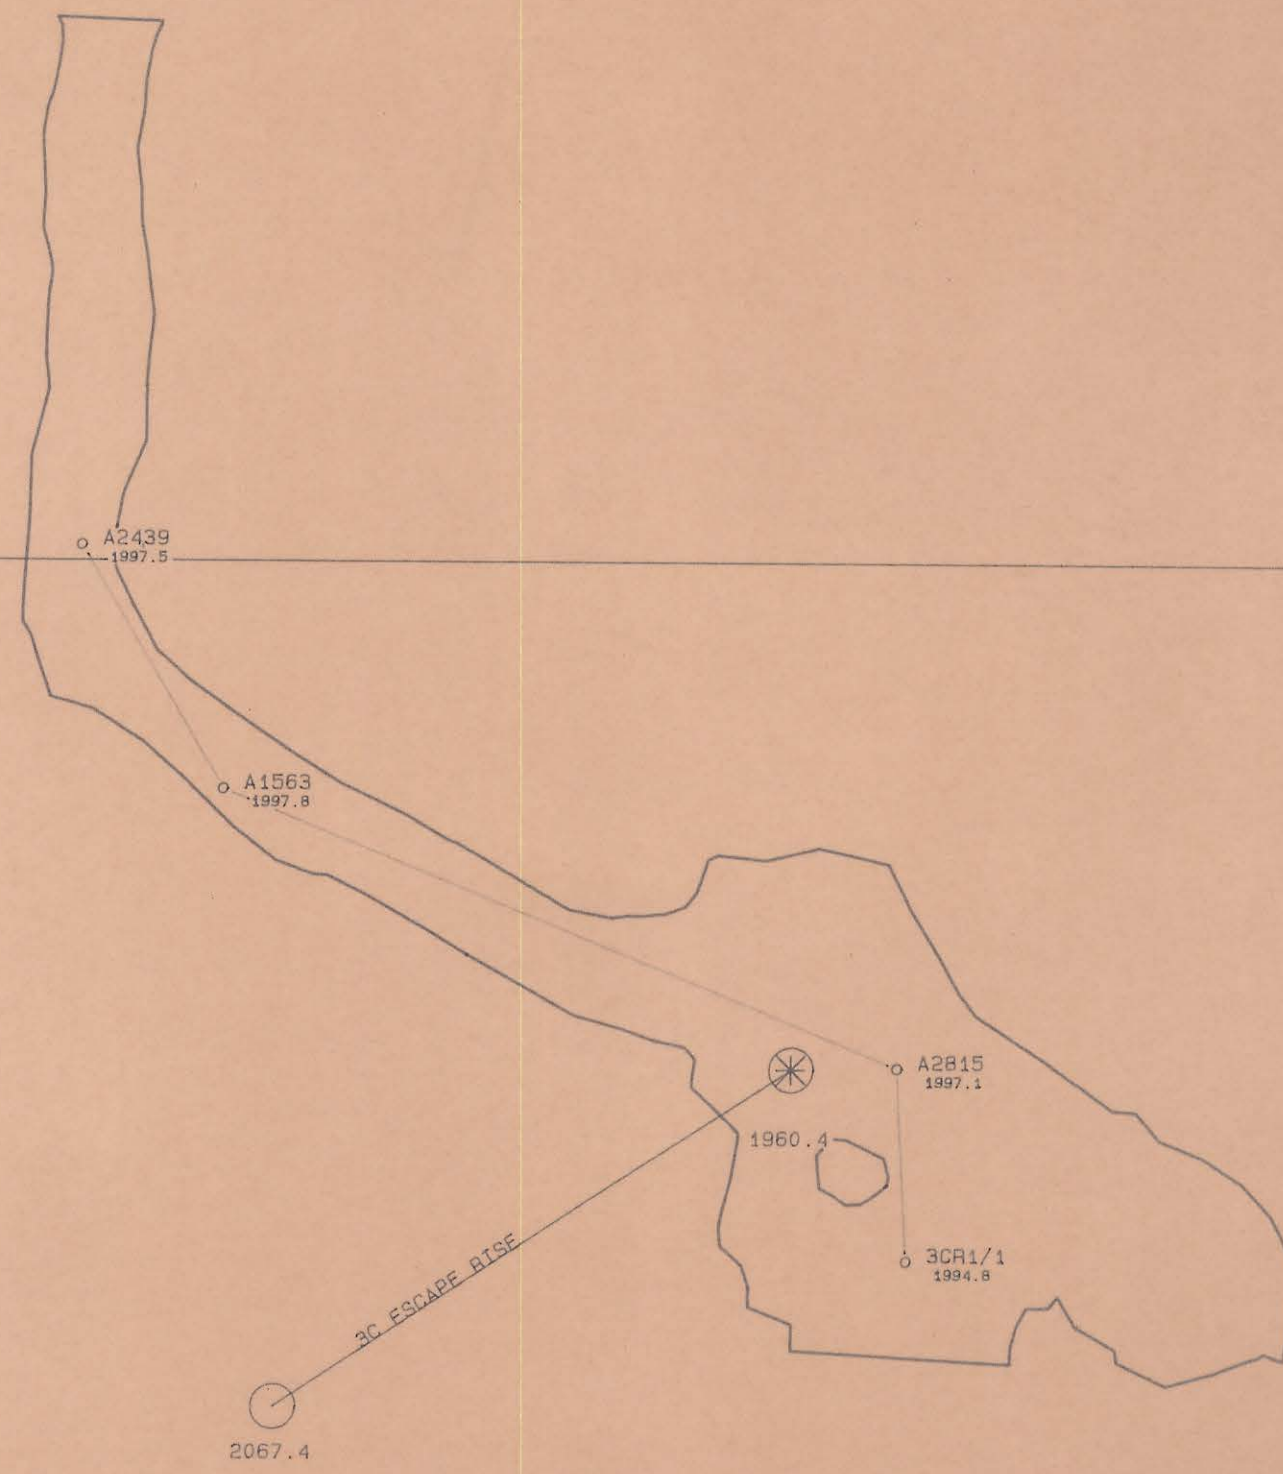

Adison