


0376-049



RENISON LIMITED	
PENZANCE 1960 LIFT 16	
MASTER PLAN	
SCALE 1: 500	10: 016/001
DATE 29-OCT-91	
LEVEL 33	
WEST COAST SURVEYS PTY LTD	
This is the last lift planned for Penzance 1960 at this stage. The lift was not filled. The fill used is from lift 15.	

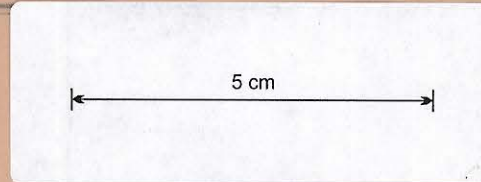