
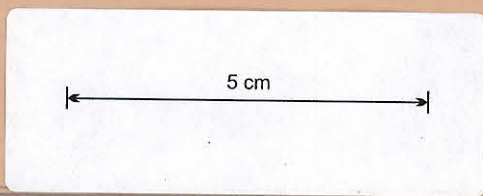


0376 - 050

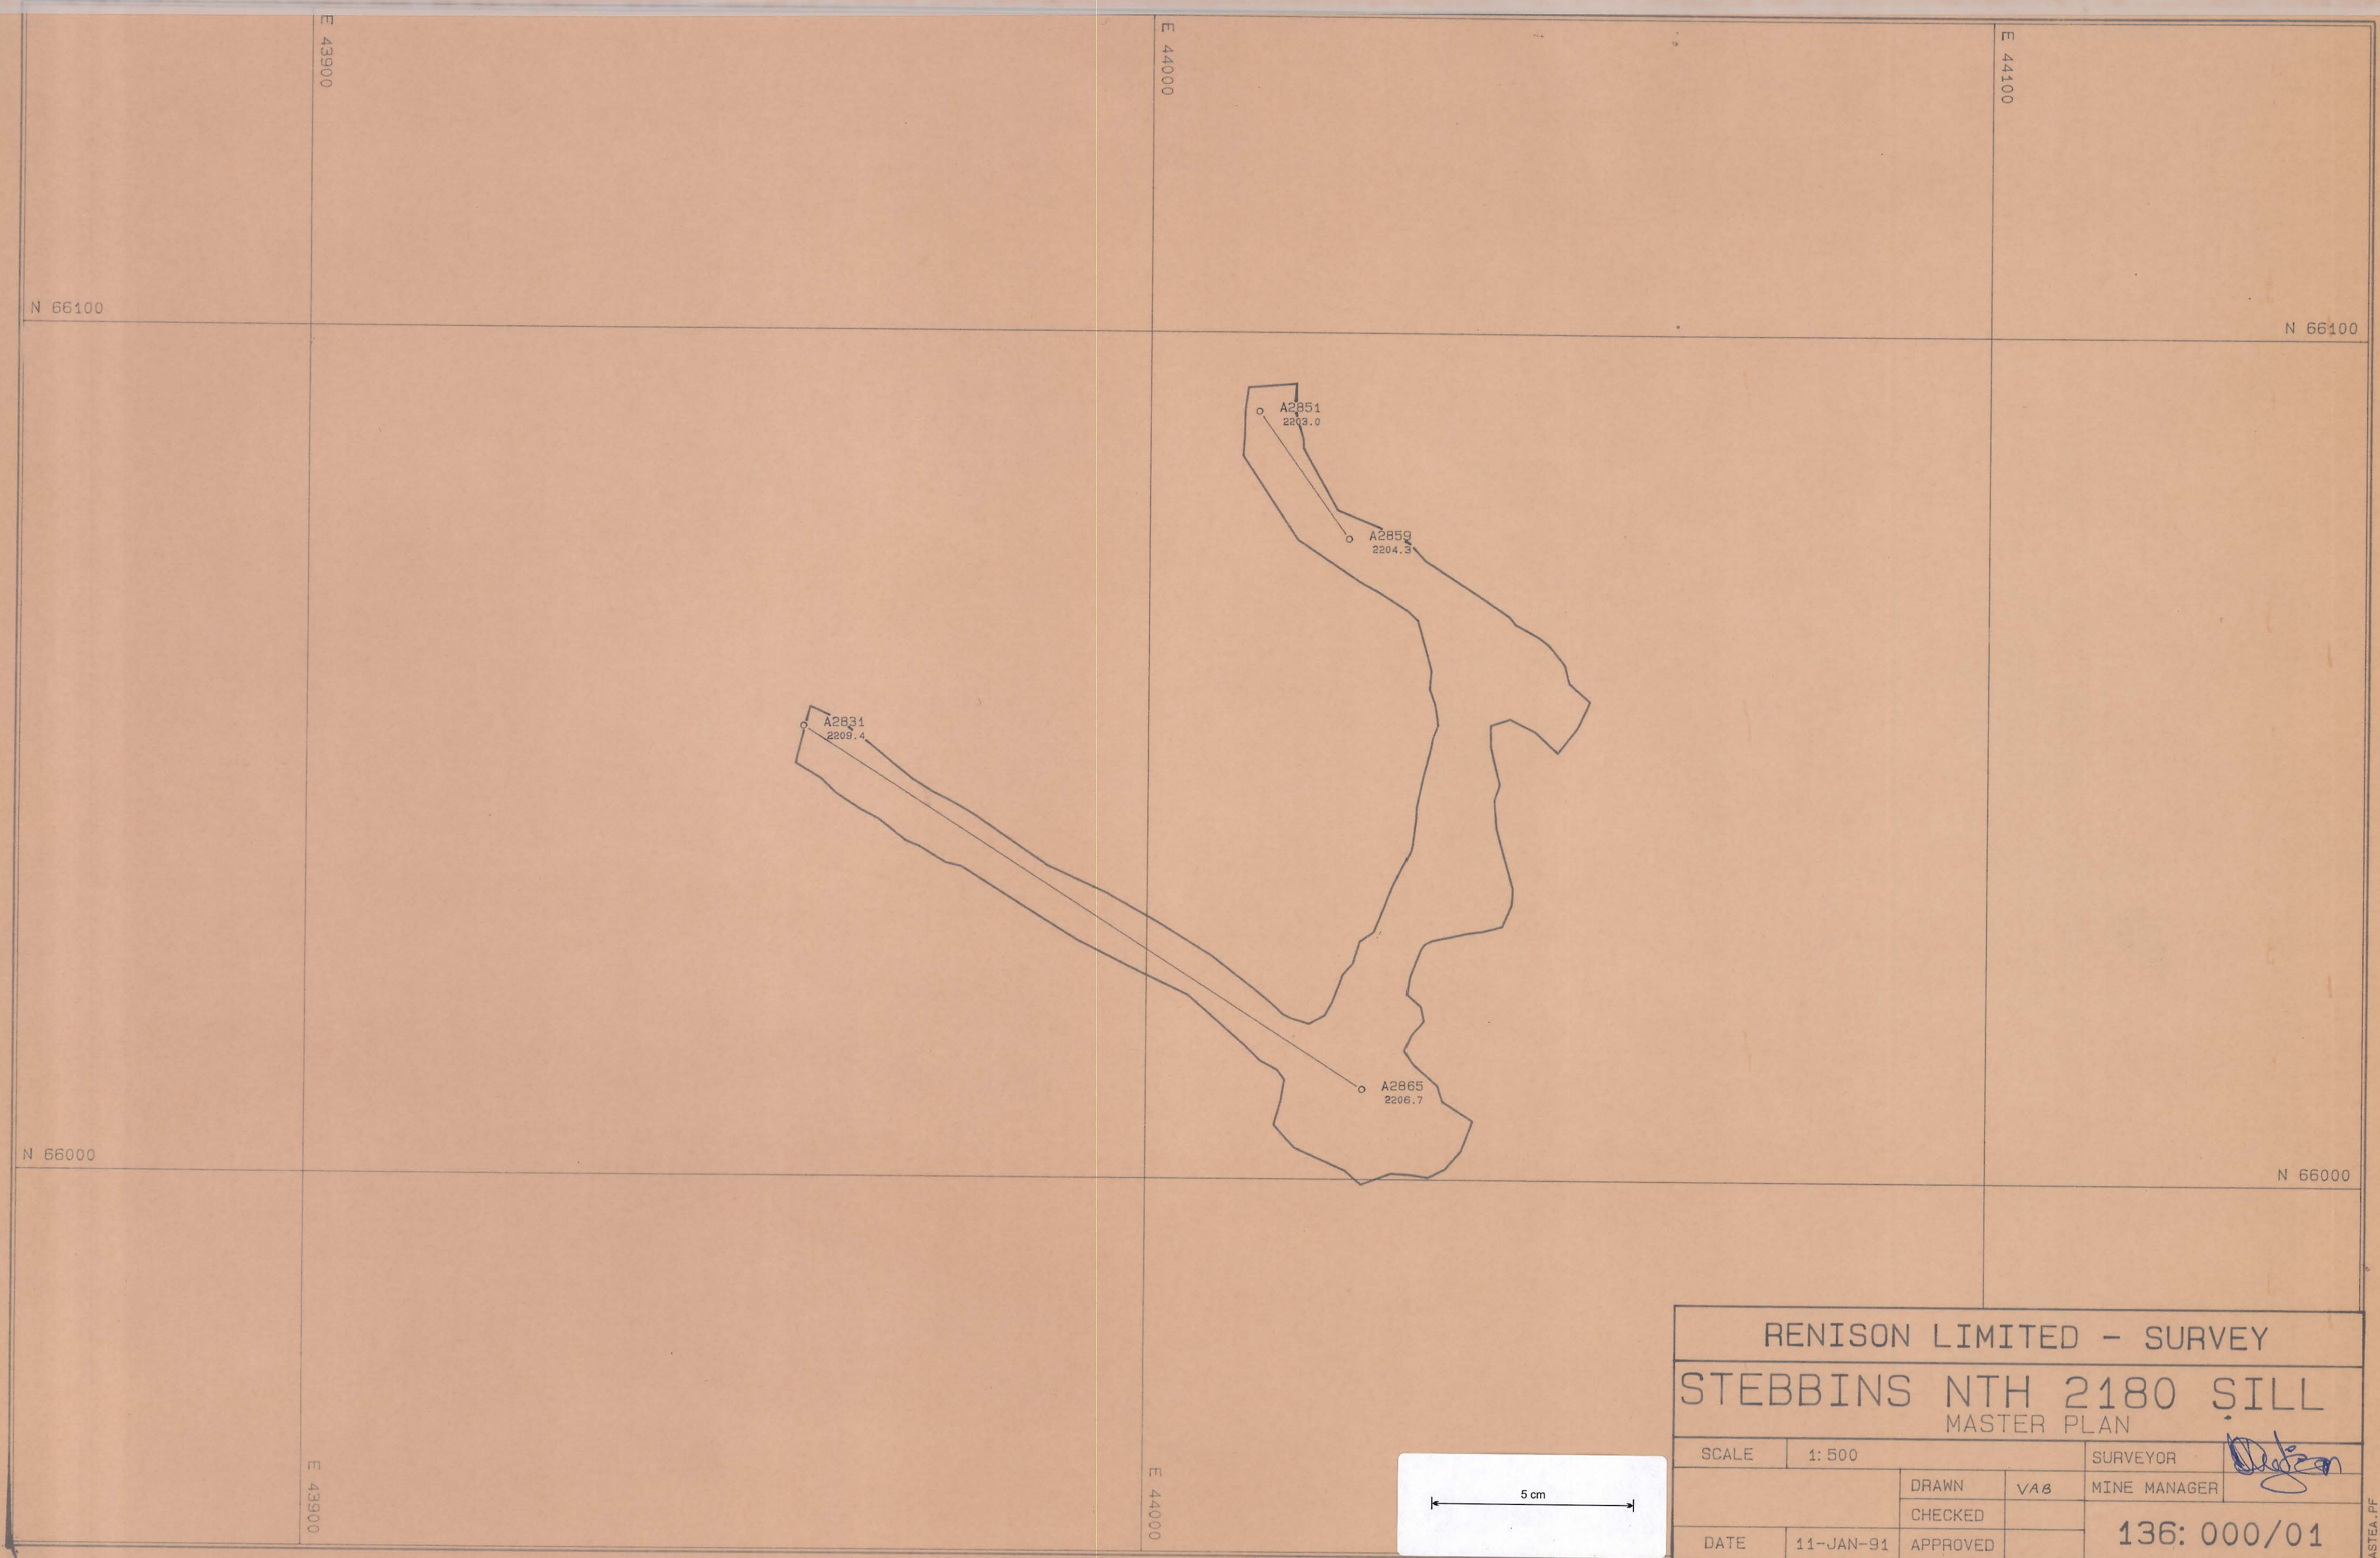

RENISON LIMITED - SURVEY			
STEBBINS NTH 2180 SILL			
MASTER PLAN			
SCALE	1: 500	SURVEYOR <i>[Signature]</i>	
		DRAWN VAB	MINE MANAGER
		CHECKED	
DATE	11-JAN-91	APPROVED	136: 000/01

MASTEA.PF