
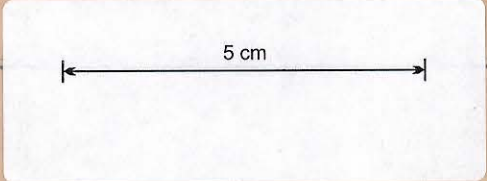


0376 - 052

RENISON LIMITED		
NTH STEBBINS 2180 LIFT 2		
MASTER PLAN		
SCALE	1: 500	136: 002/01
DATE	7-NOV-91	
LEVEL	40	
WEST COAST SURVEYS PTY LTD		
This was a normal flatback lift that was mined to the return air drive for ventilation. Most of the access was not filled.		

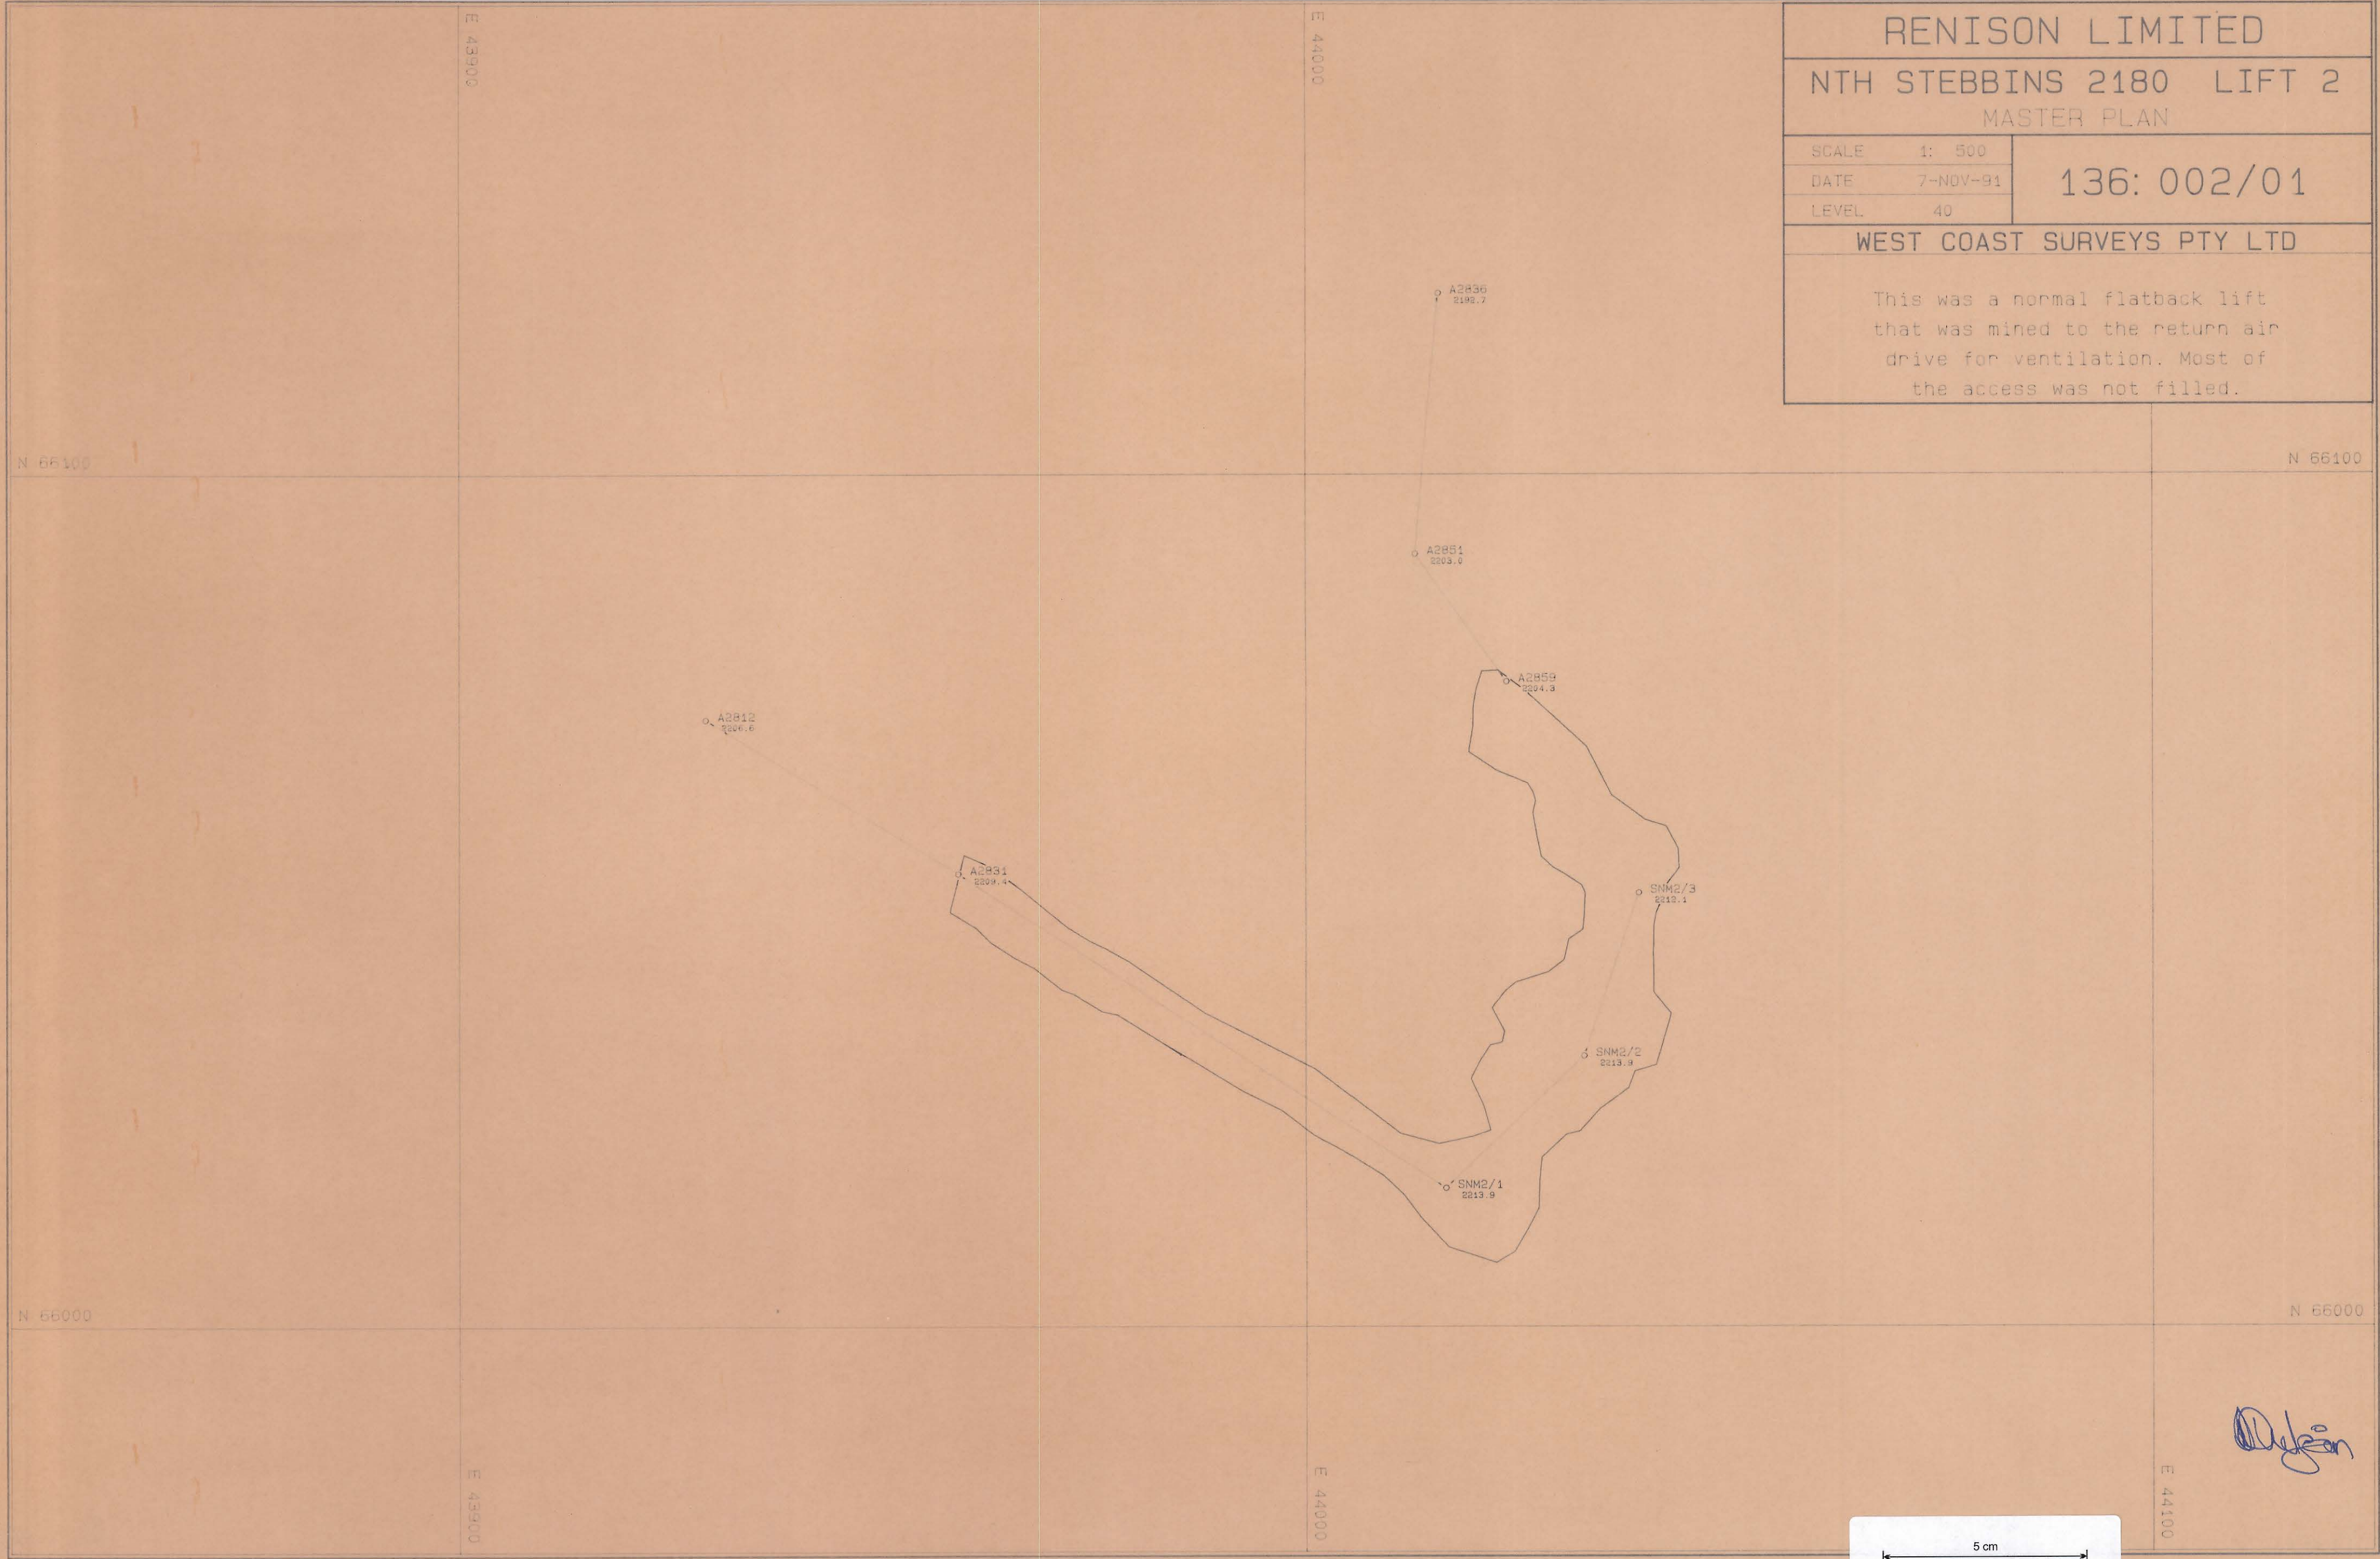

MASTEA.PK