


0376-053

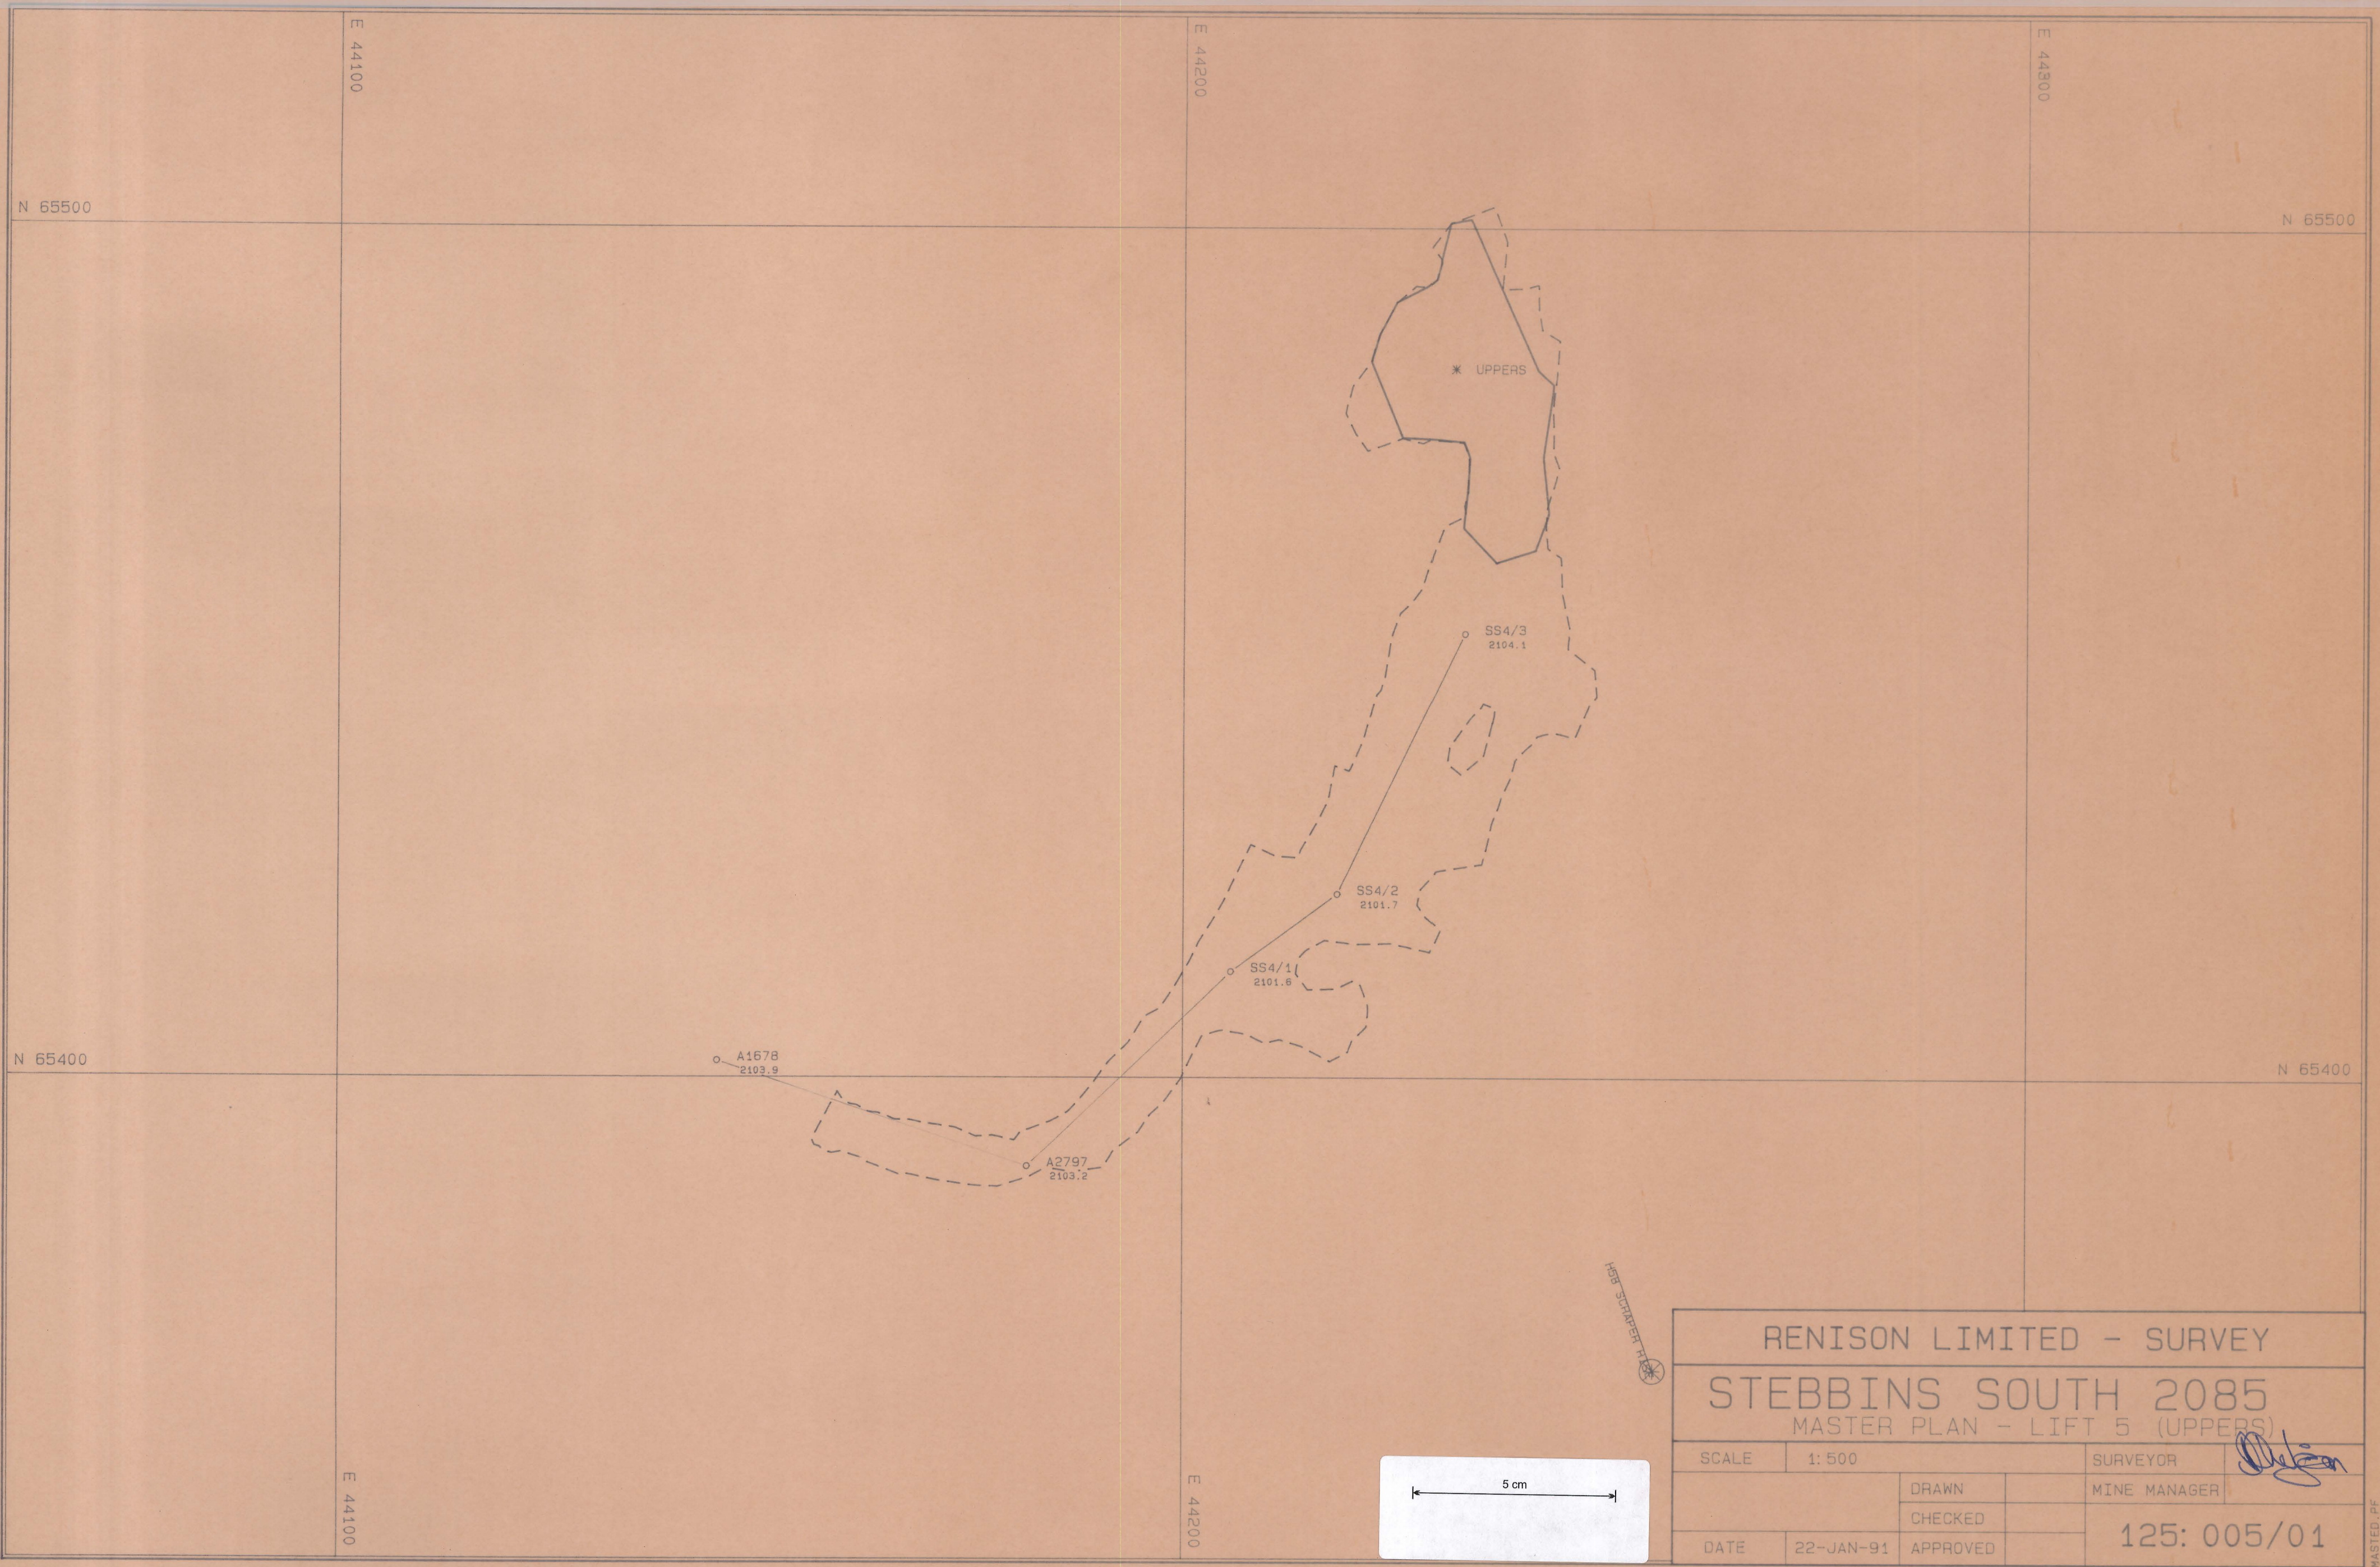

RENISON LIMITED - SURVEY			
STEBBINS SOUTH 2085			
MASTER PLAN - LIFT 5 (UPPERS)			
SCALE	1:500	SURVEYOR	<i>[Signature]</i>
		MINE MANAGER	
DATE	22-JAN-91	CHECKED	
		APPROVED	
125: 005/01			