


0376 - 056

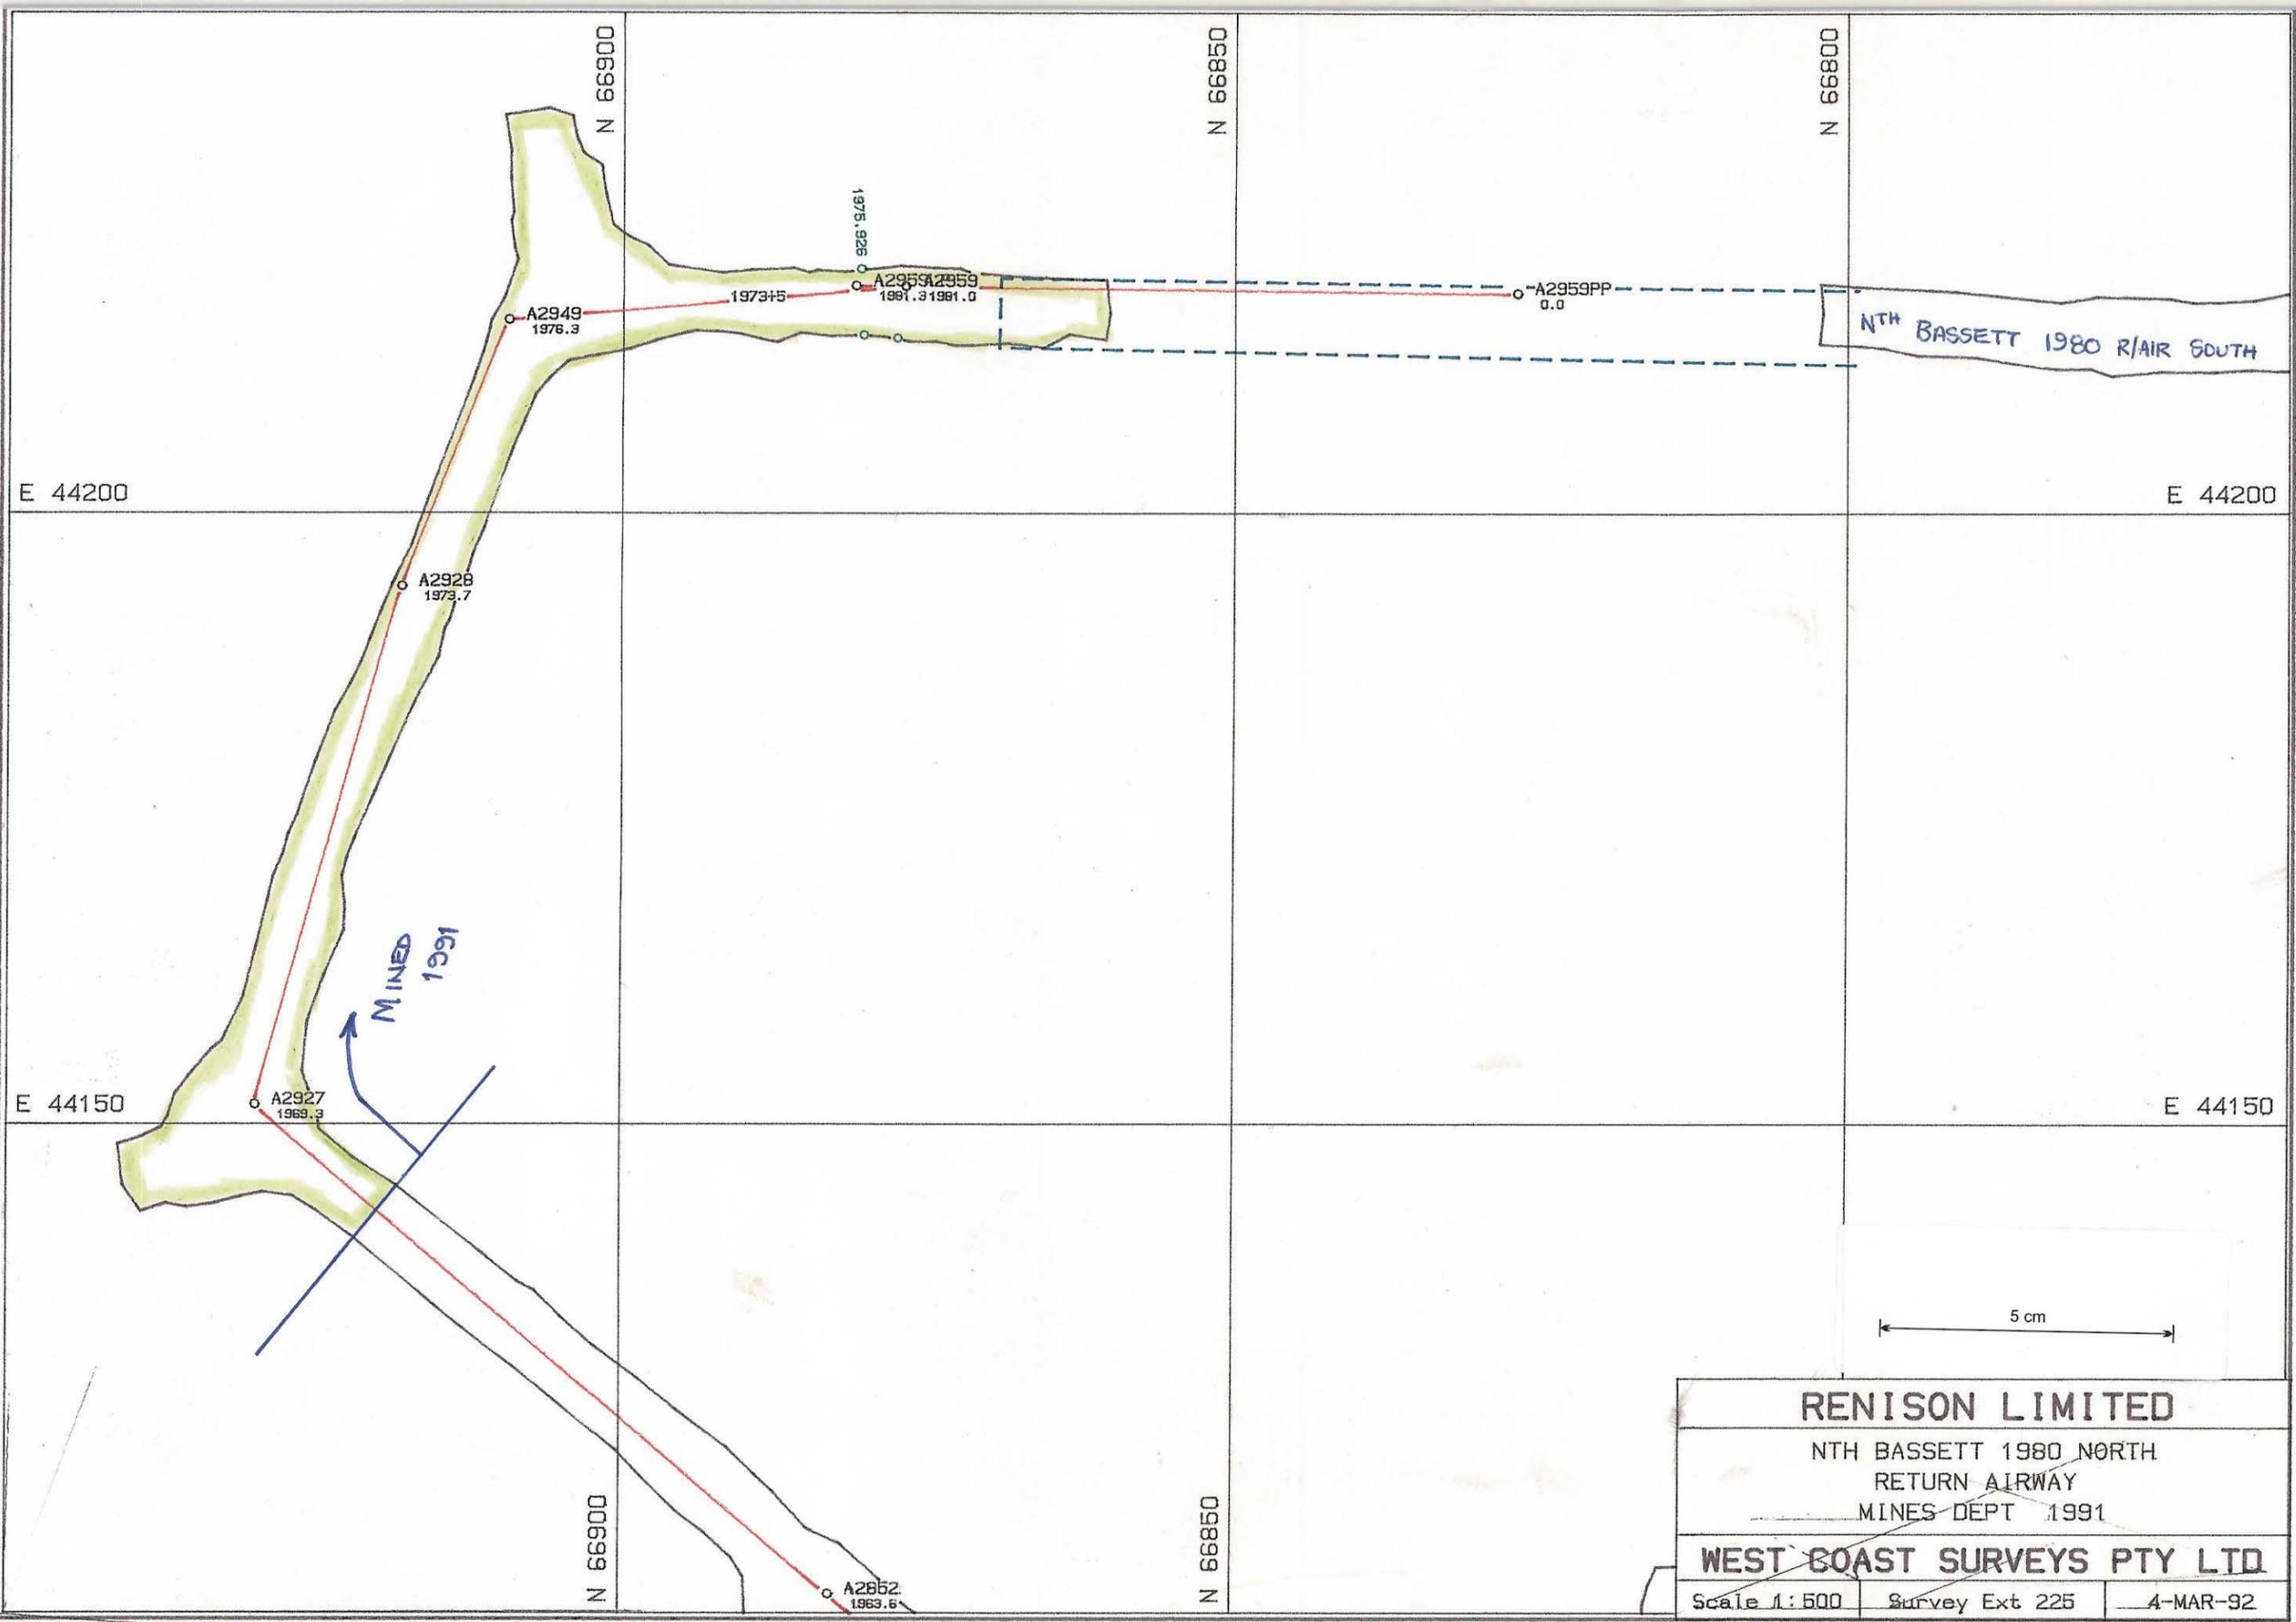

RENISON LIMITED		
NTH BASSETT 1980 NORTH RETURN AIRWAY MINES DEPT 1991		
WEST COAST SURVEYS PTY LTD		
Scale 1:500	Survey Ext 225	4-MAR-92

NTHBAC.PF