


0376-057

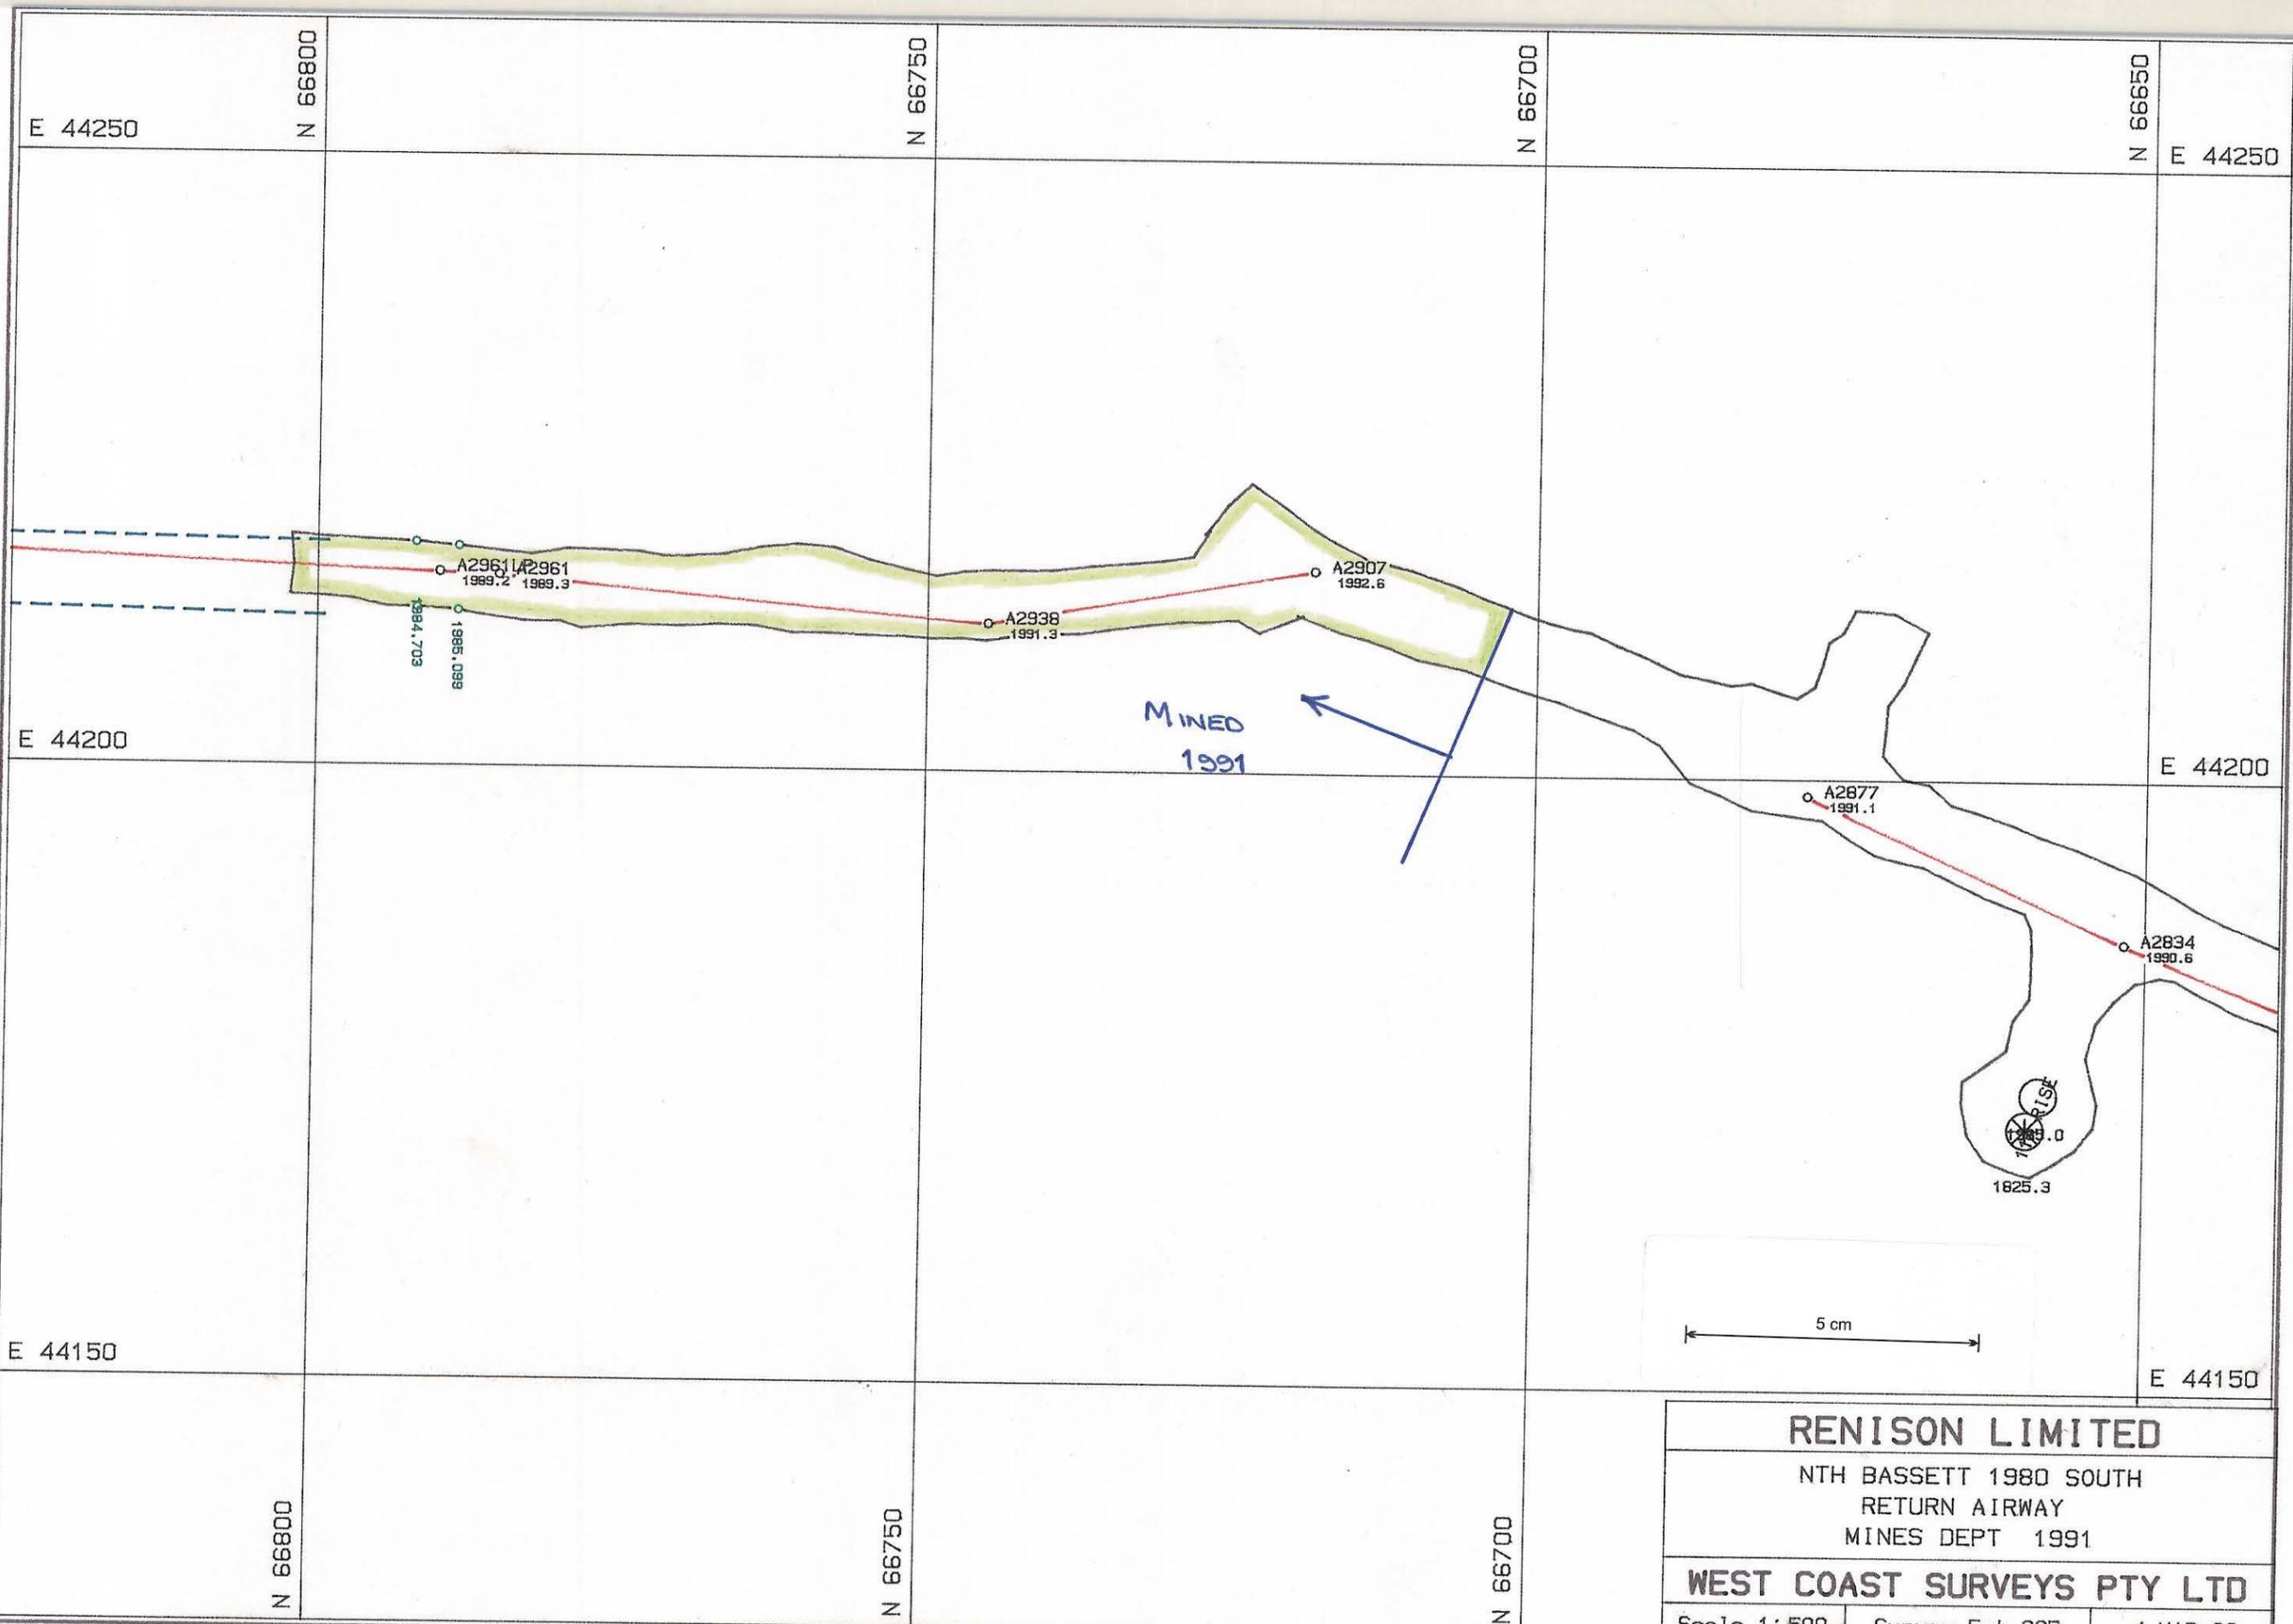

NTHBAS.PP