


0376 - 059

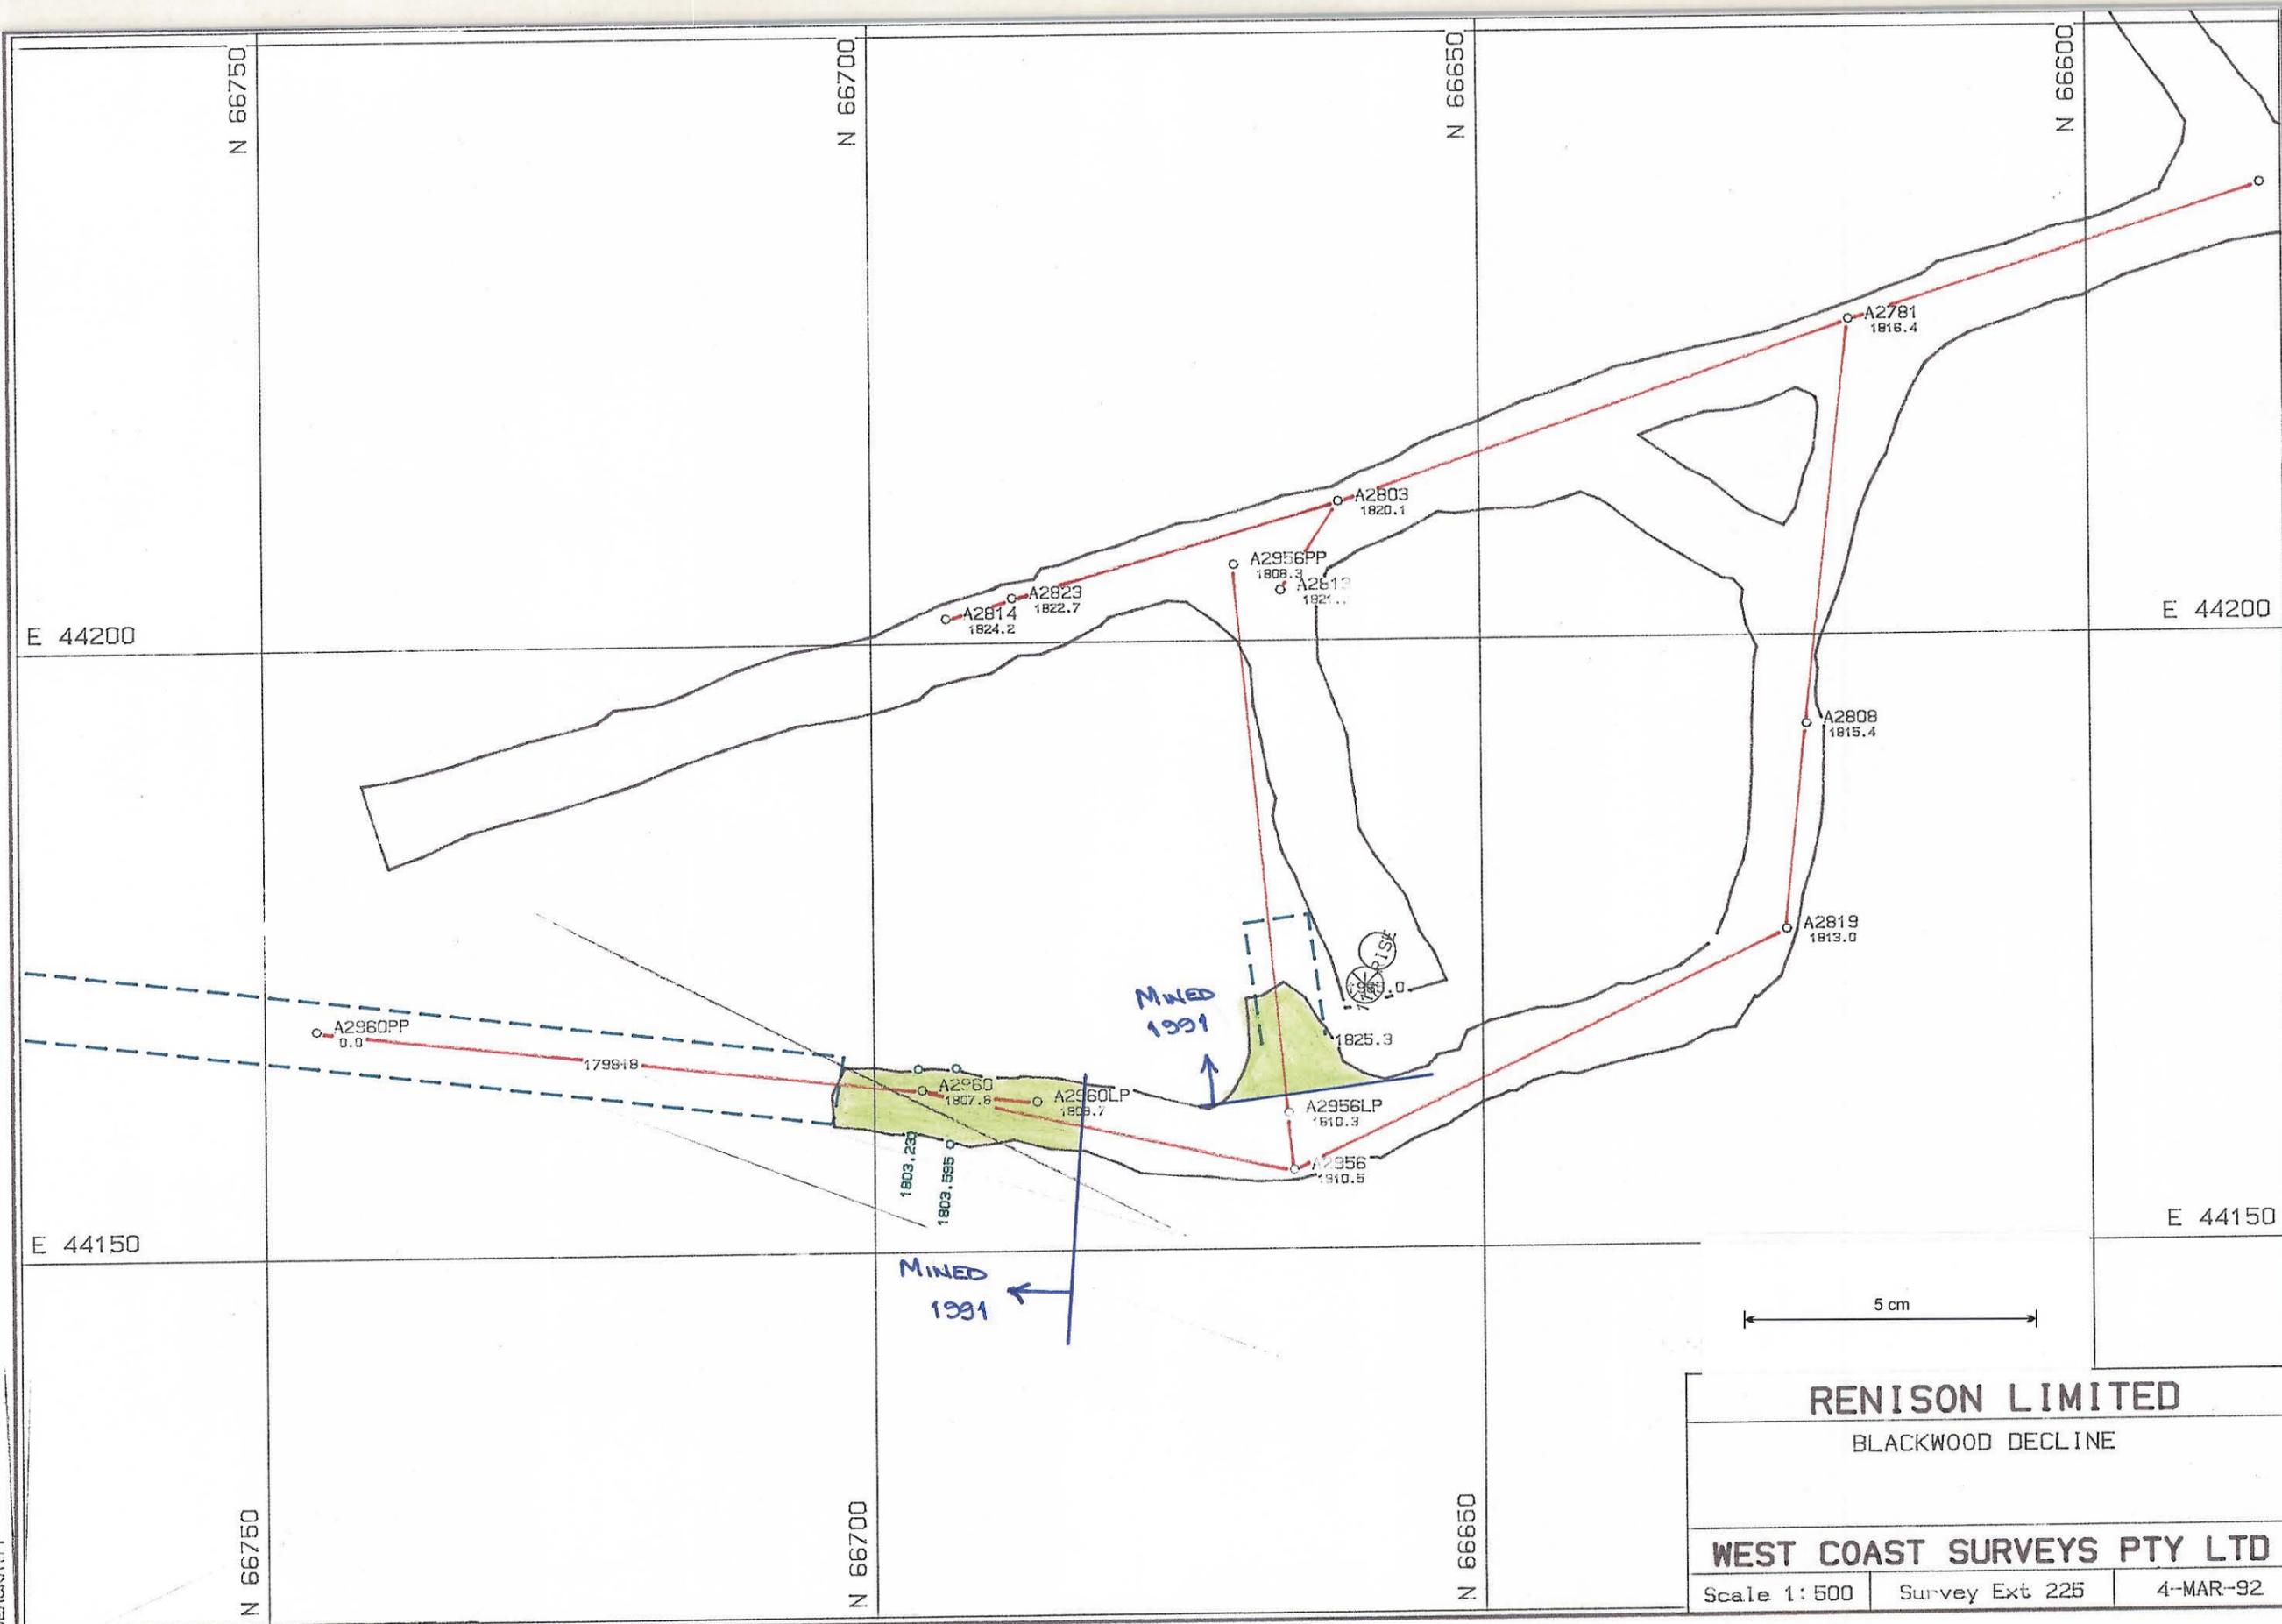

**RENISON LIMITED**  
 BLACKWOOD DECLINE  
**WEST COAST SURVEYS PTY LTD**  
 Scale 1: 500 | Survey Ext 225 | 4-MAR-92