


0376 - 060

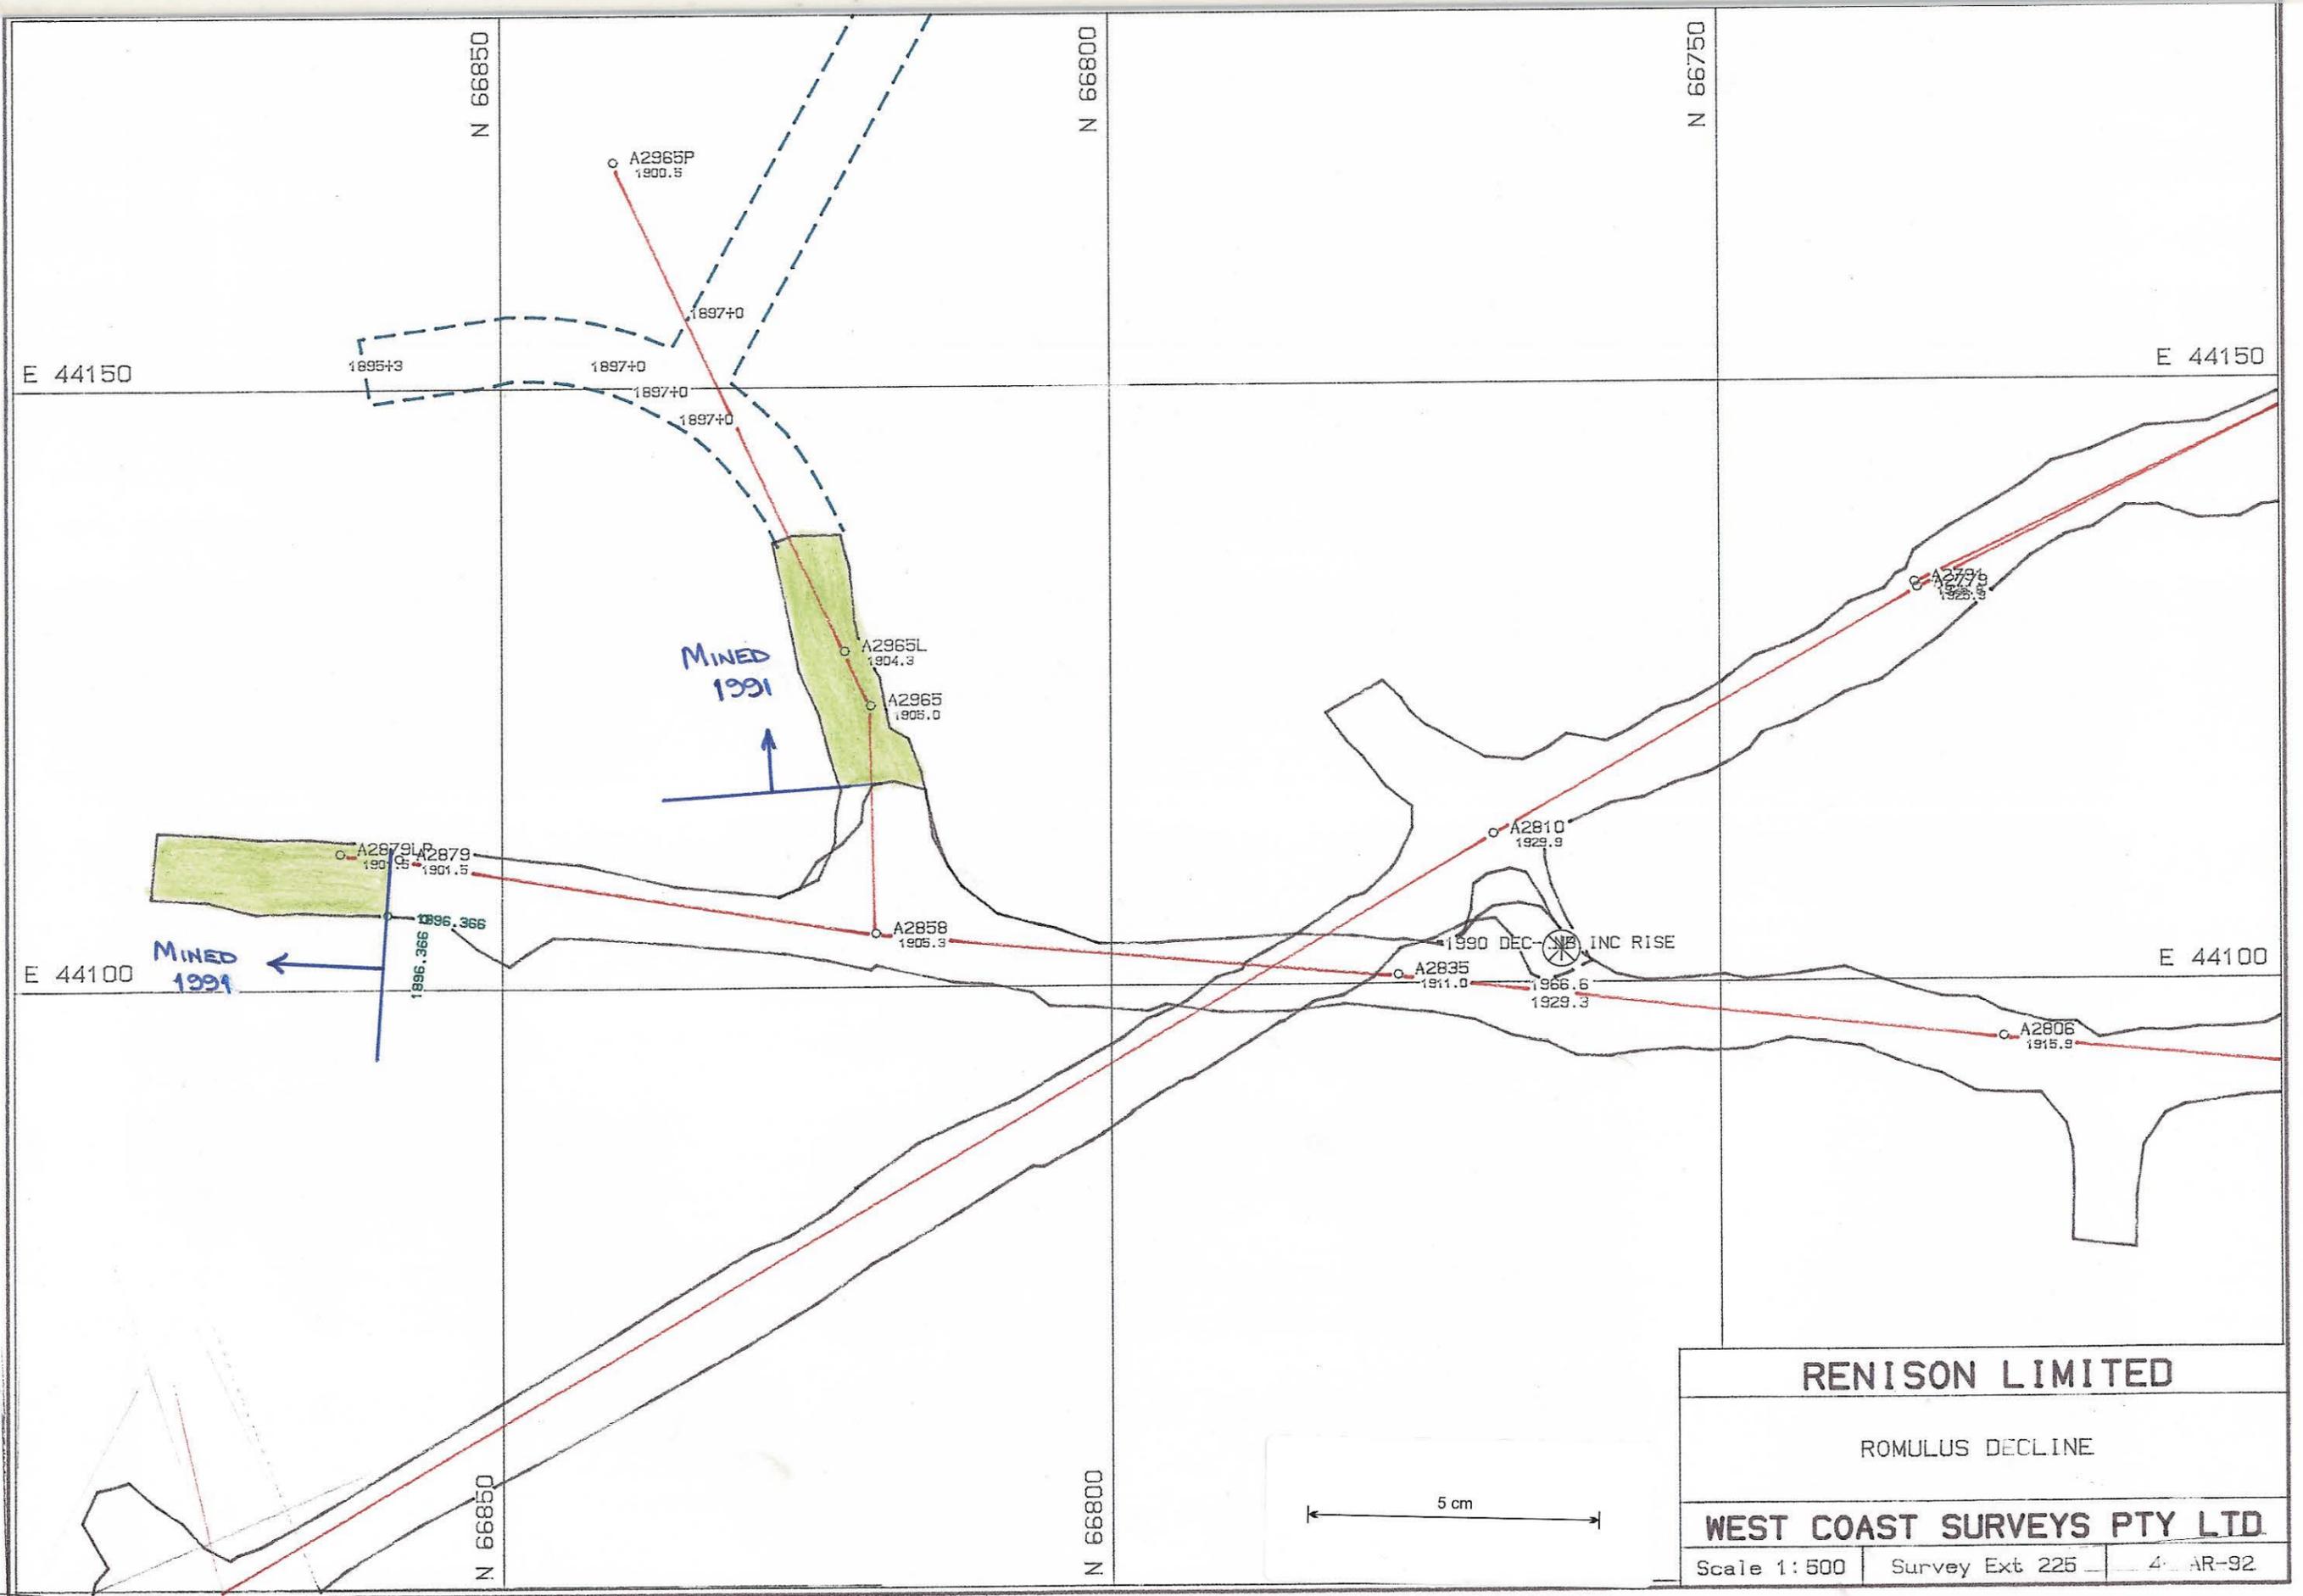

RENISON LIMITED		
ROMULUS DECLINE		
WEST COAST SURVEYS PTY LTD		
Scale 1:500	Survey Ext 225	4 AR-92

ROMULA.PF