


0376 - 061

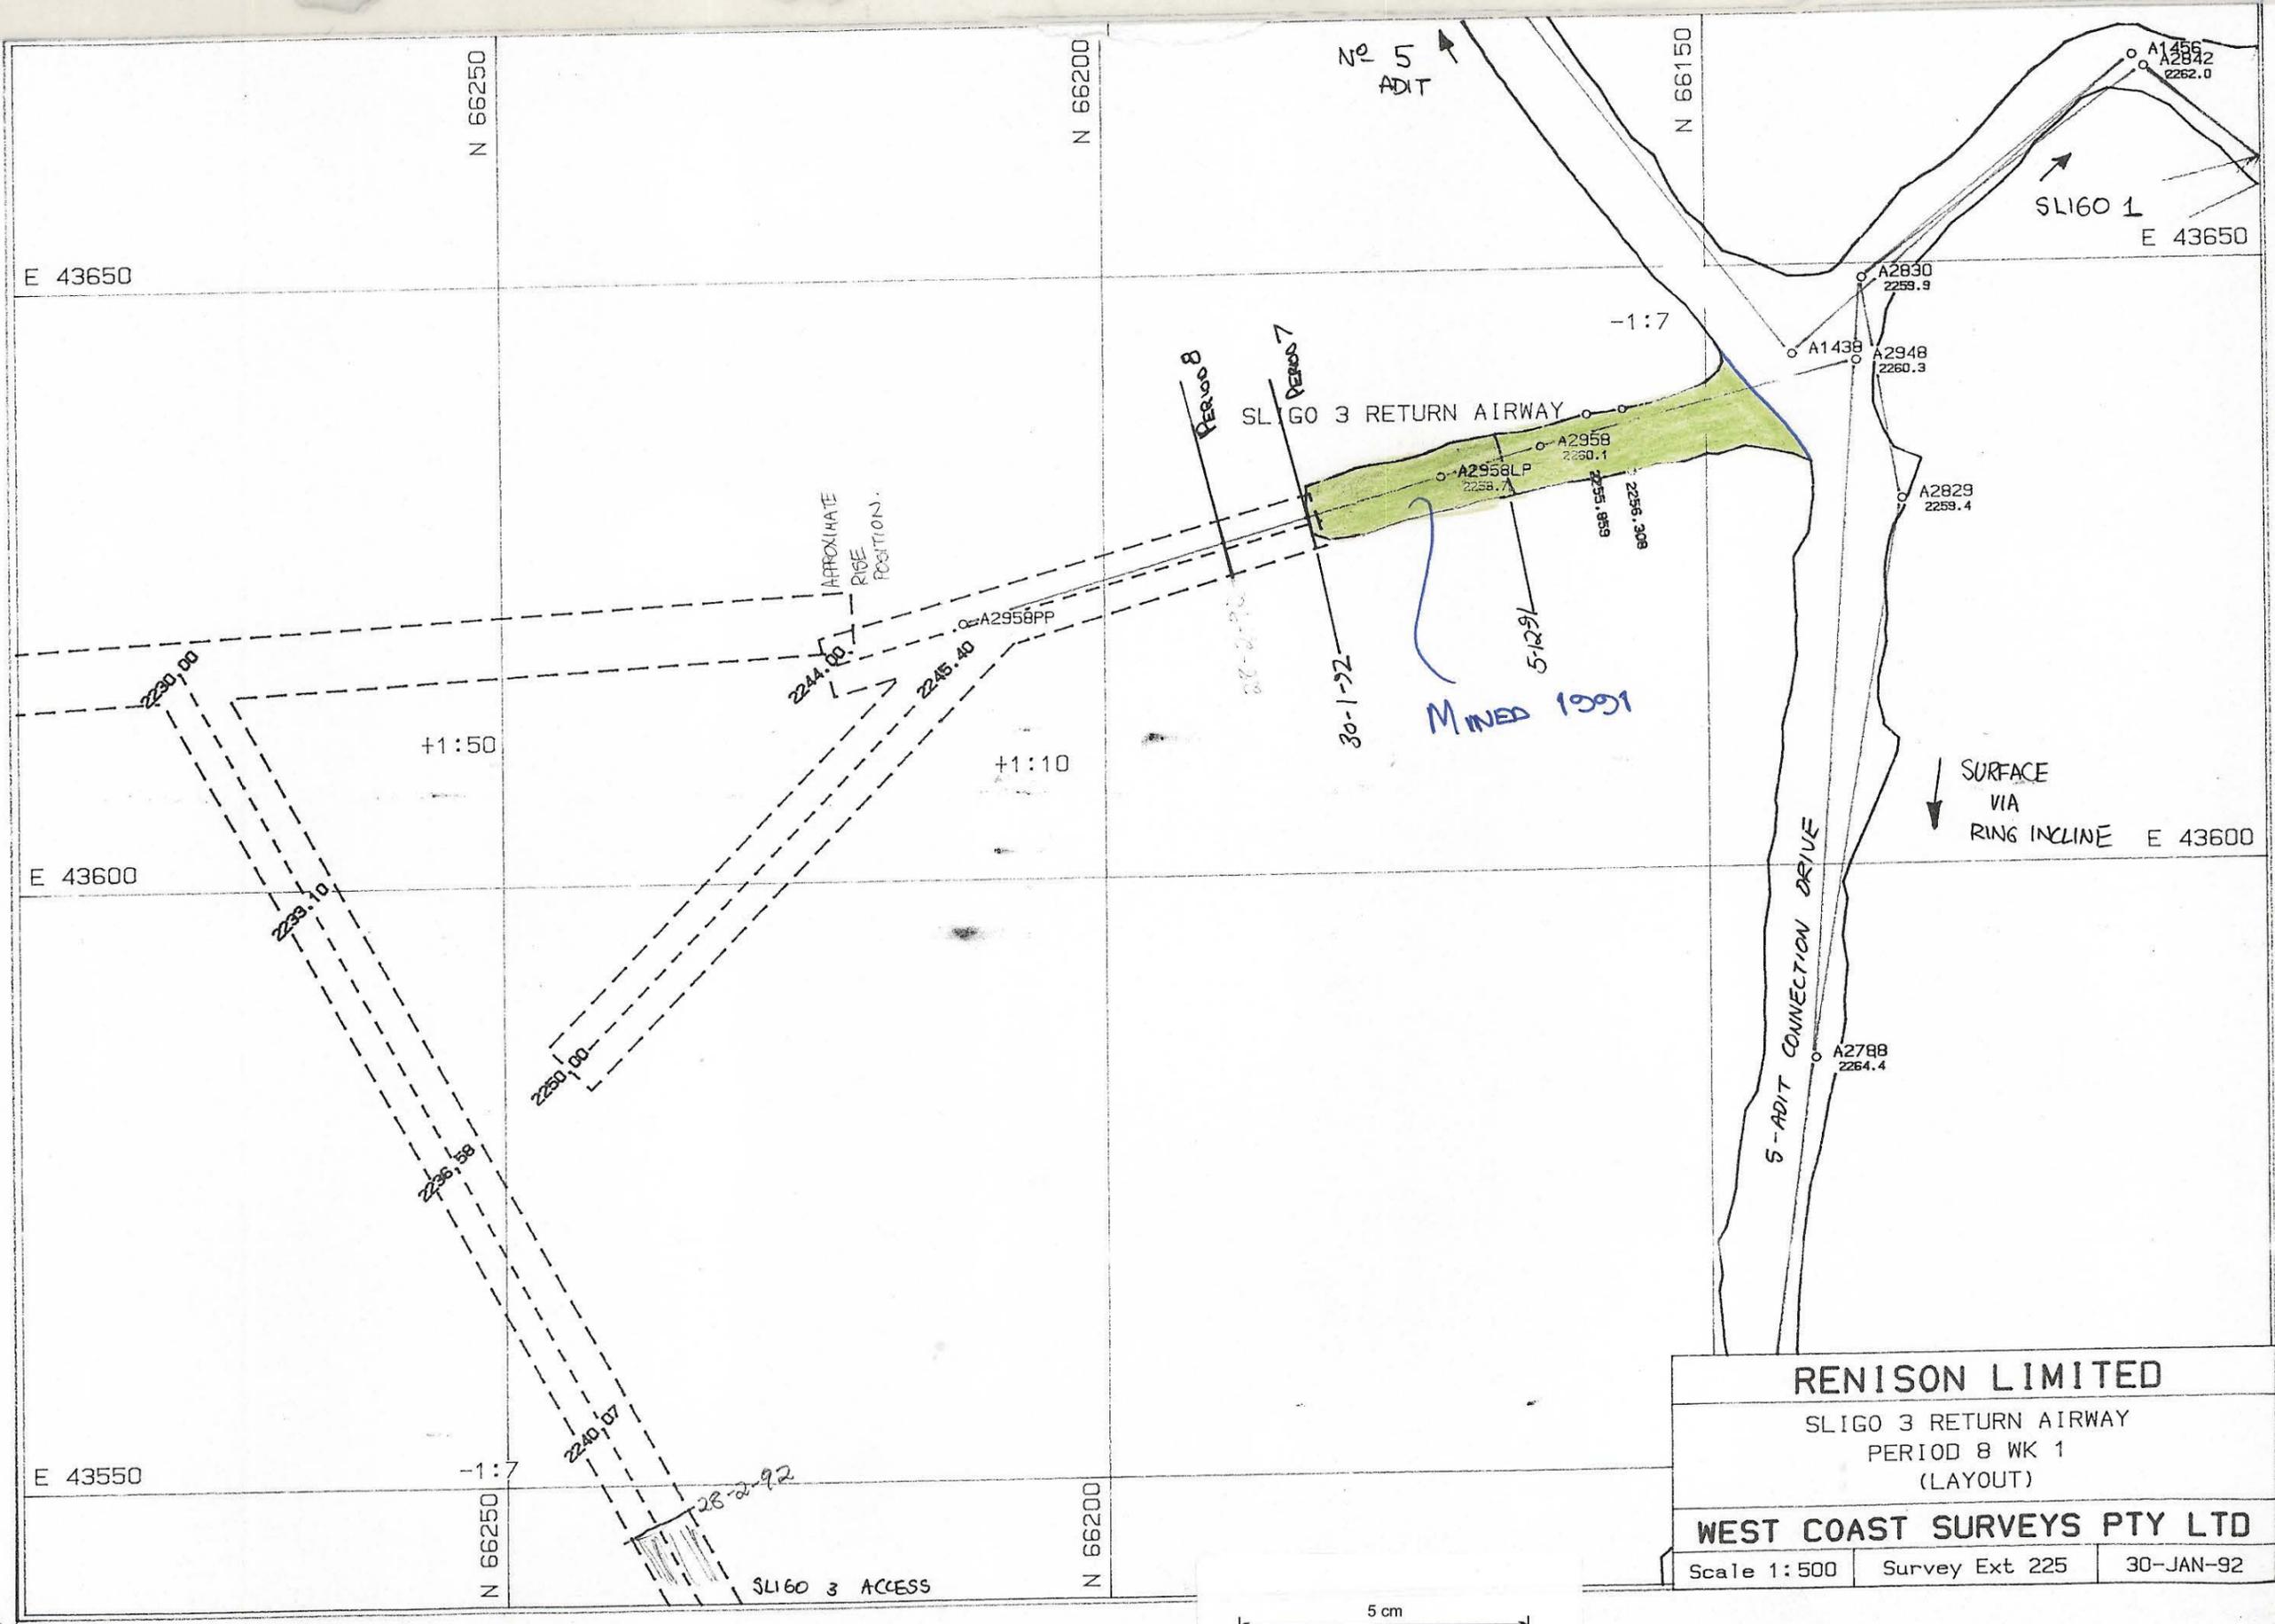

**RENISON LIMITED**  
 SLIGO 3 RETURN AIRWAY  
 PERIOD 8 WK 1  
 (LAYOUT)  
**WEST COAST SURVEYS PTY LTD**  
 Scale 1:500    Survey Ext 225    30-JAN-92

