


0376-062

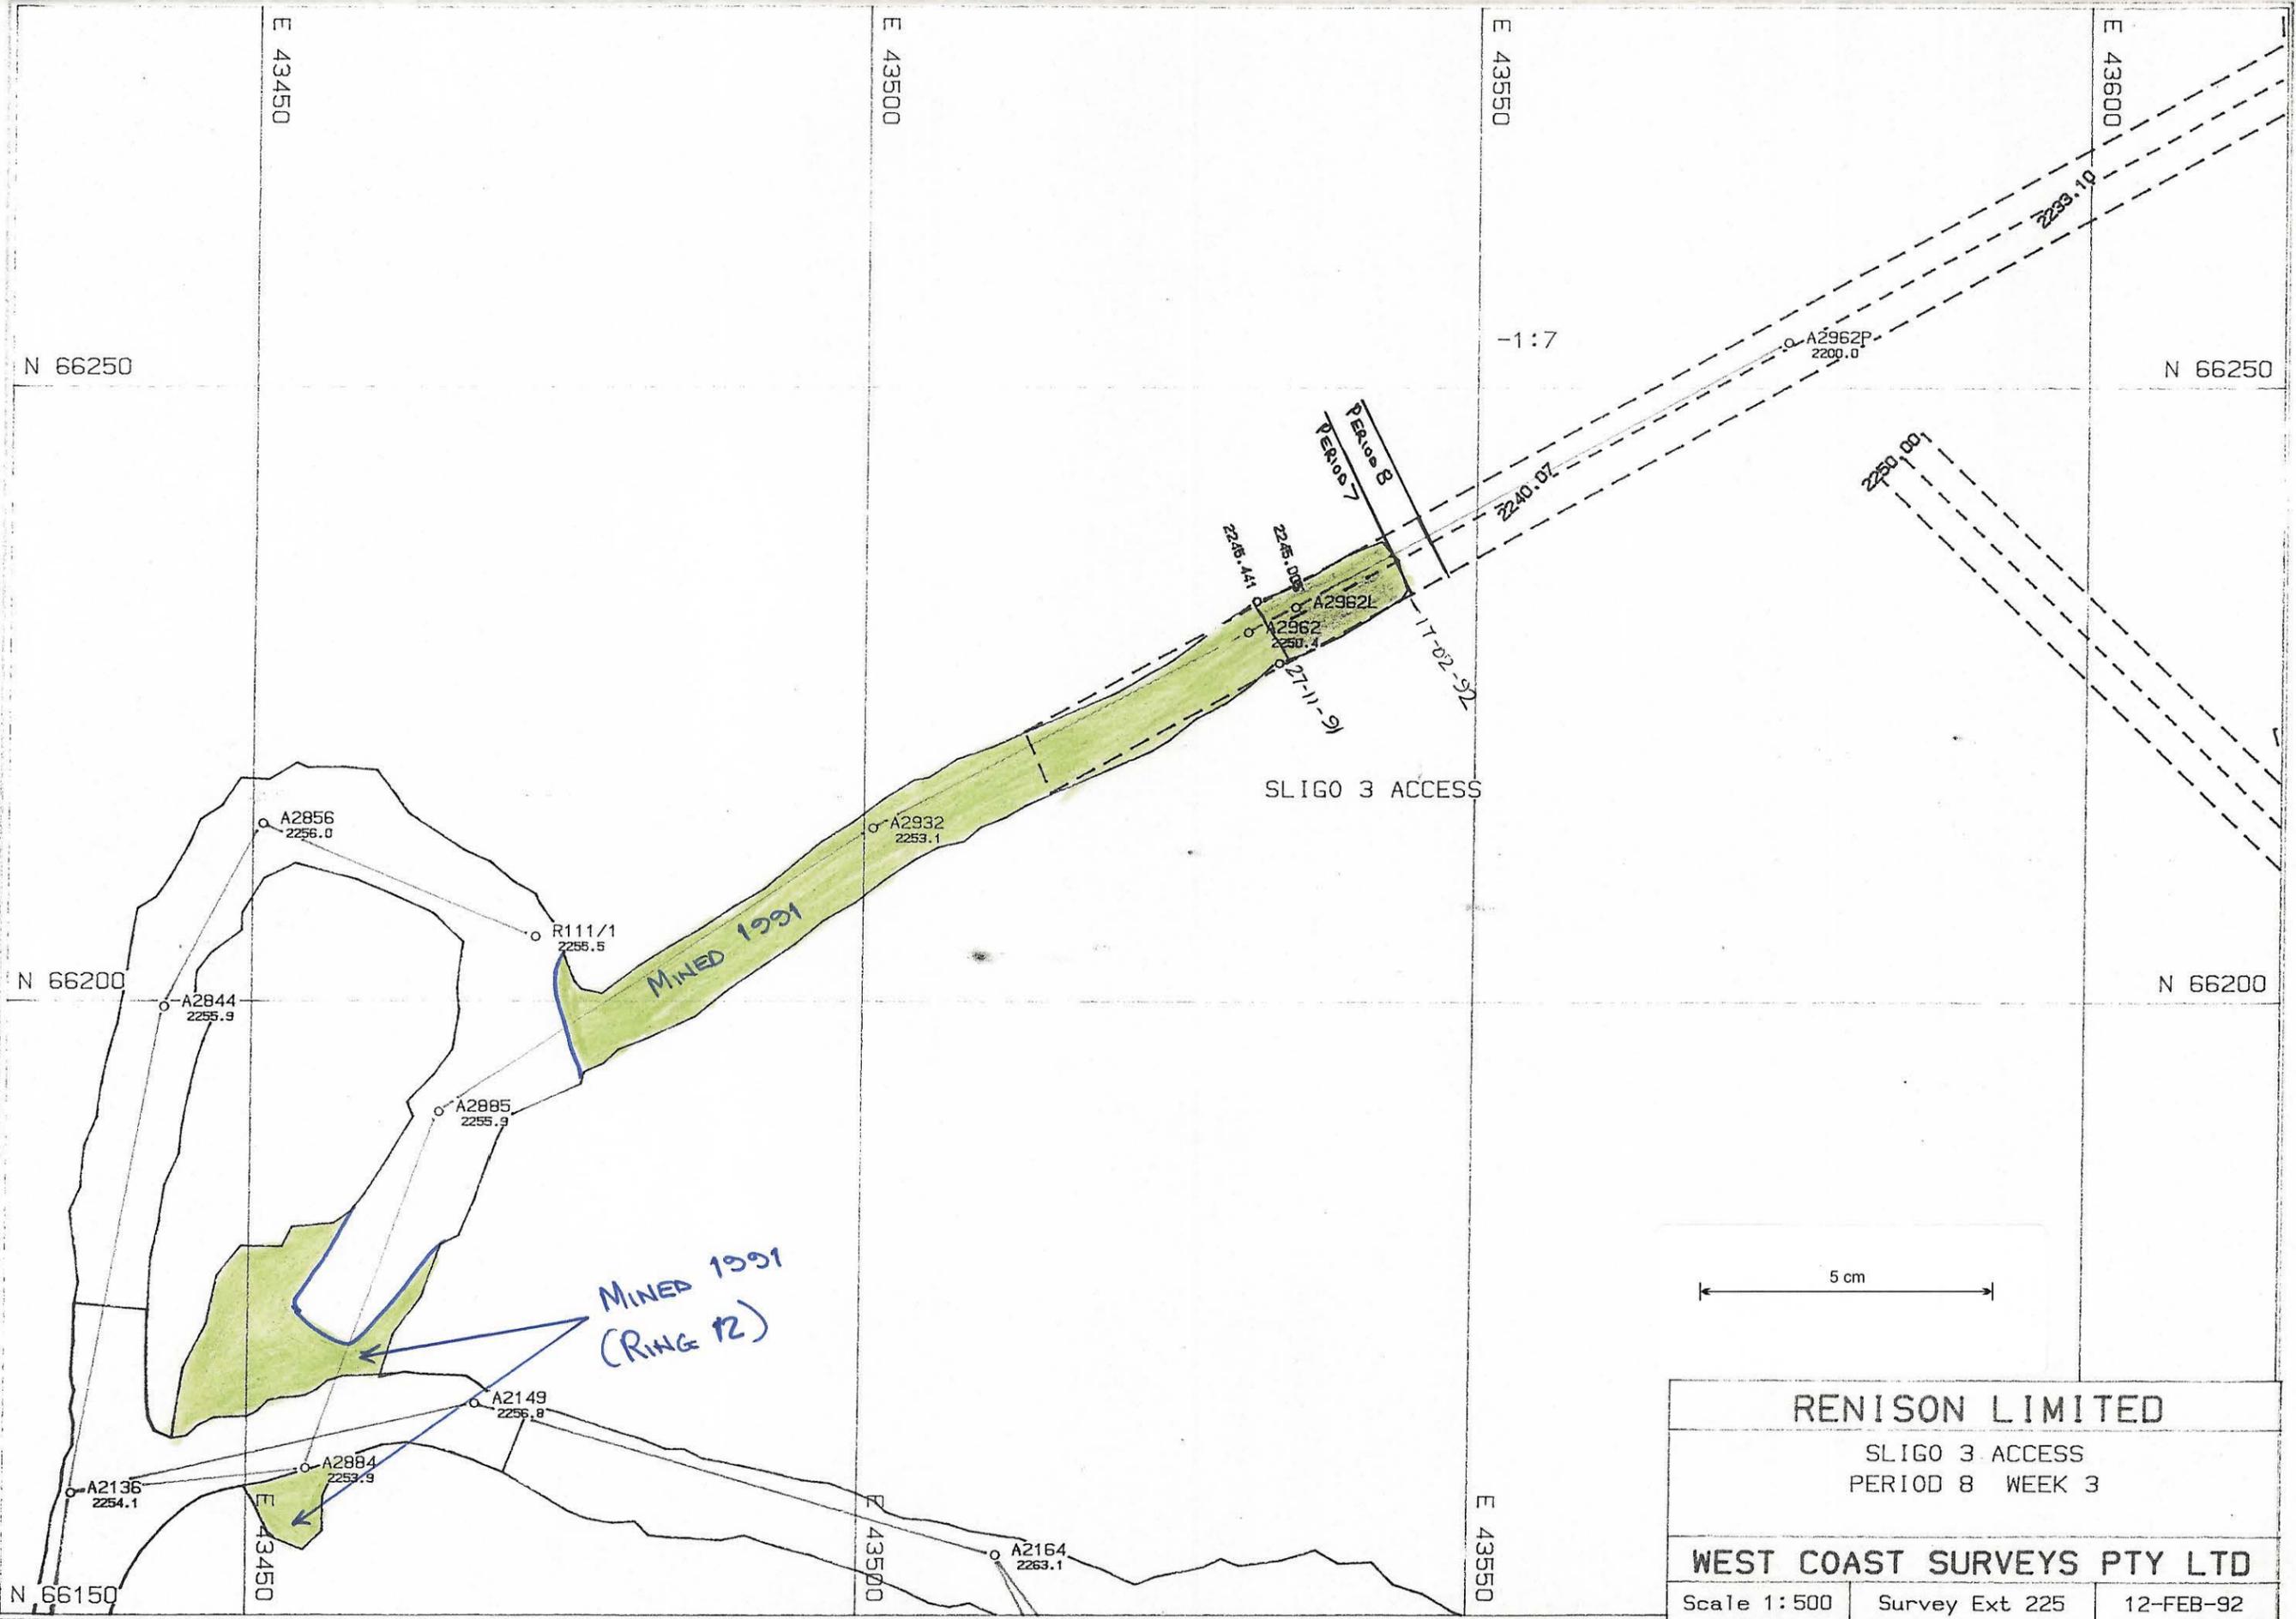

SLIGOA.PF