


0376-064

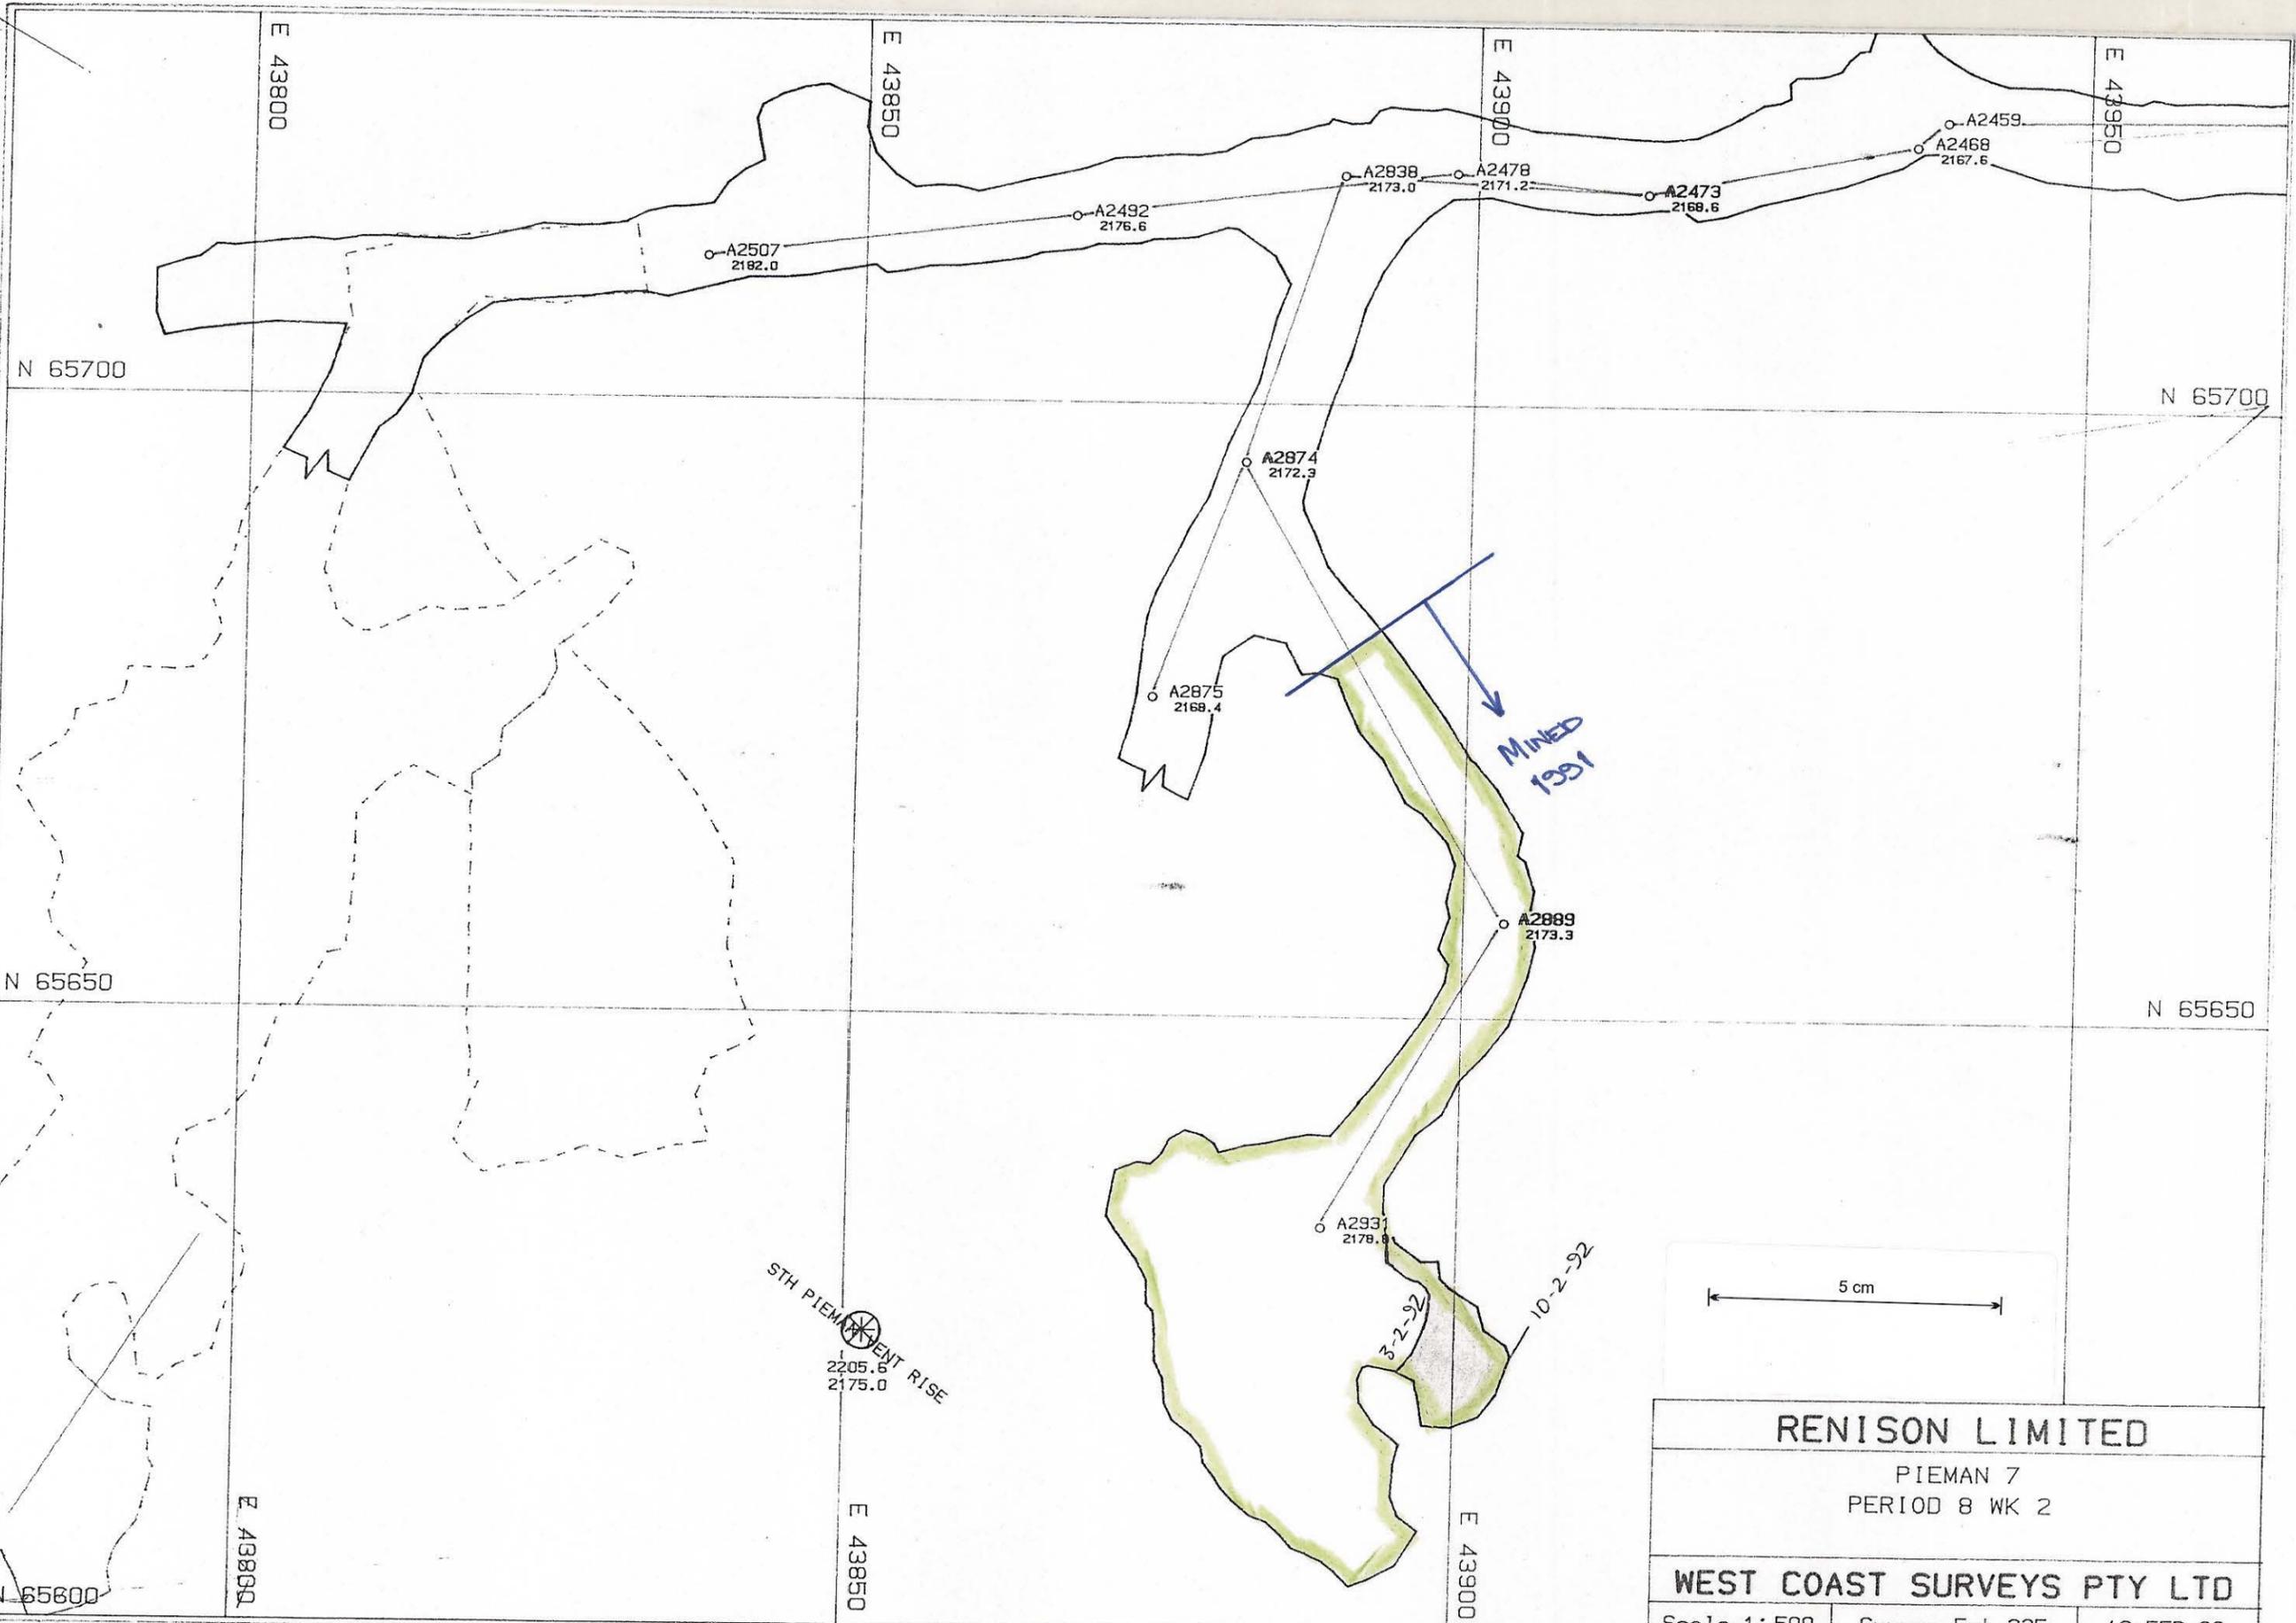

RENISON LIMITED		
PIEMAN 7 PERIOD 8 WK 2		
WEST COAST SURVEYS PTY LTD		
Scale 1:500	Survey Ext 225	10-FEB-92

PIEMAN.PF