


0376 - 066

PRODUCTION HEADINGS

UPDATE
11-02-92

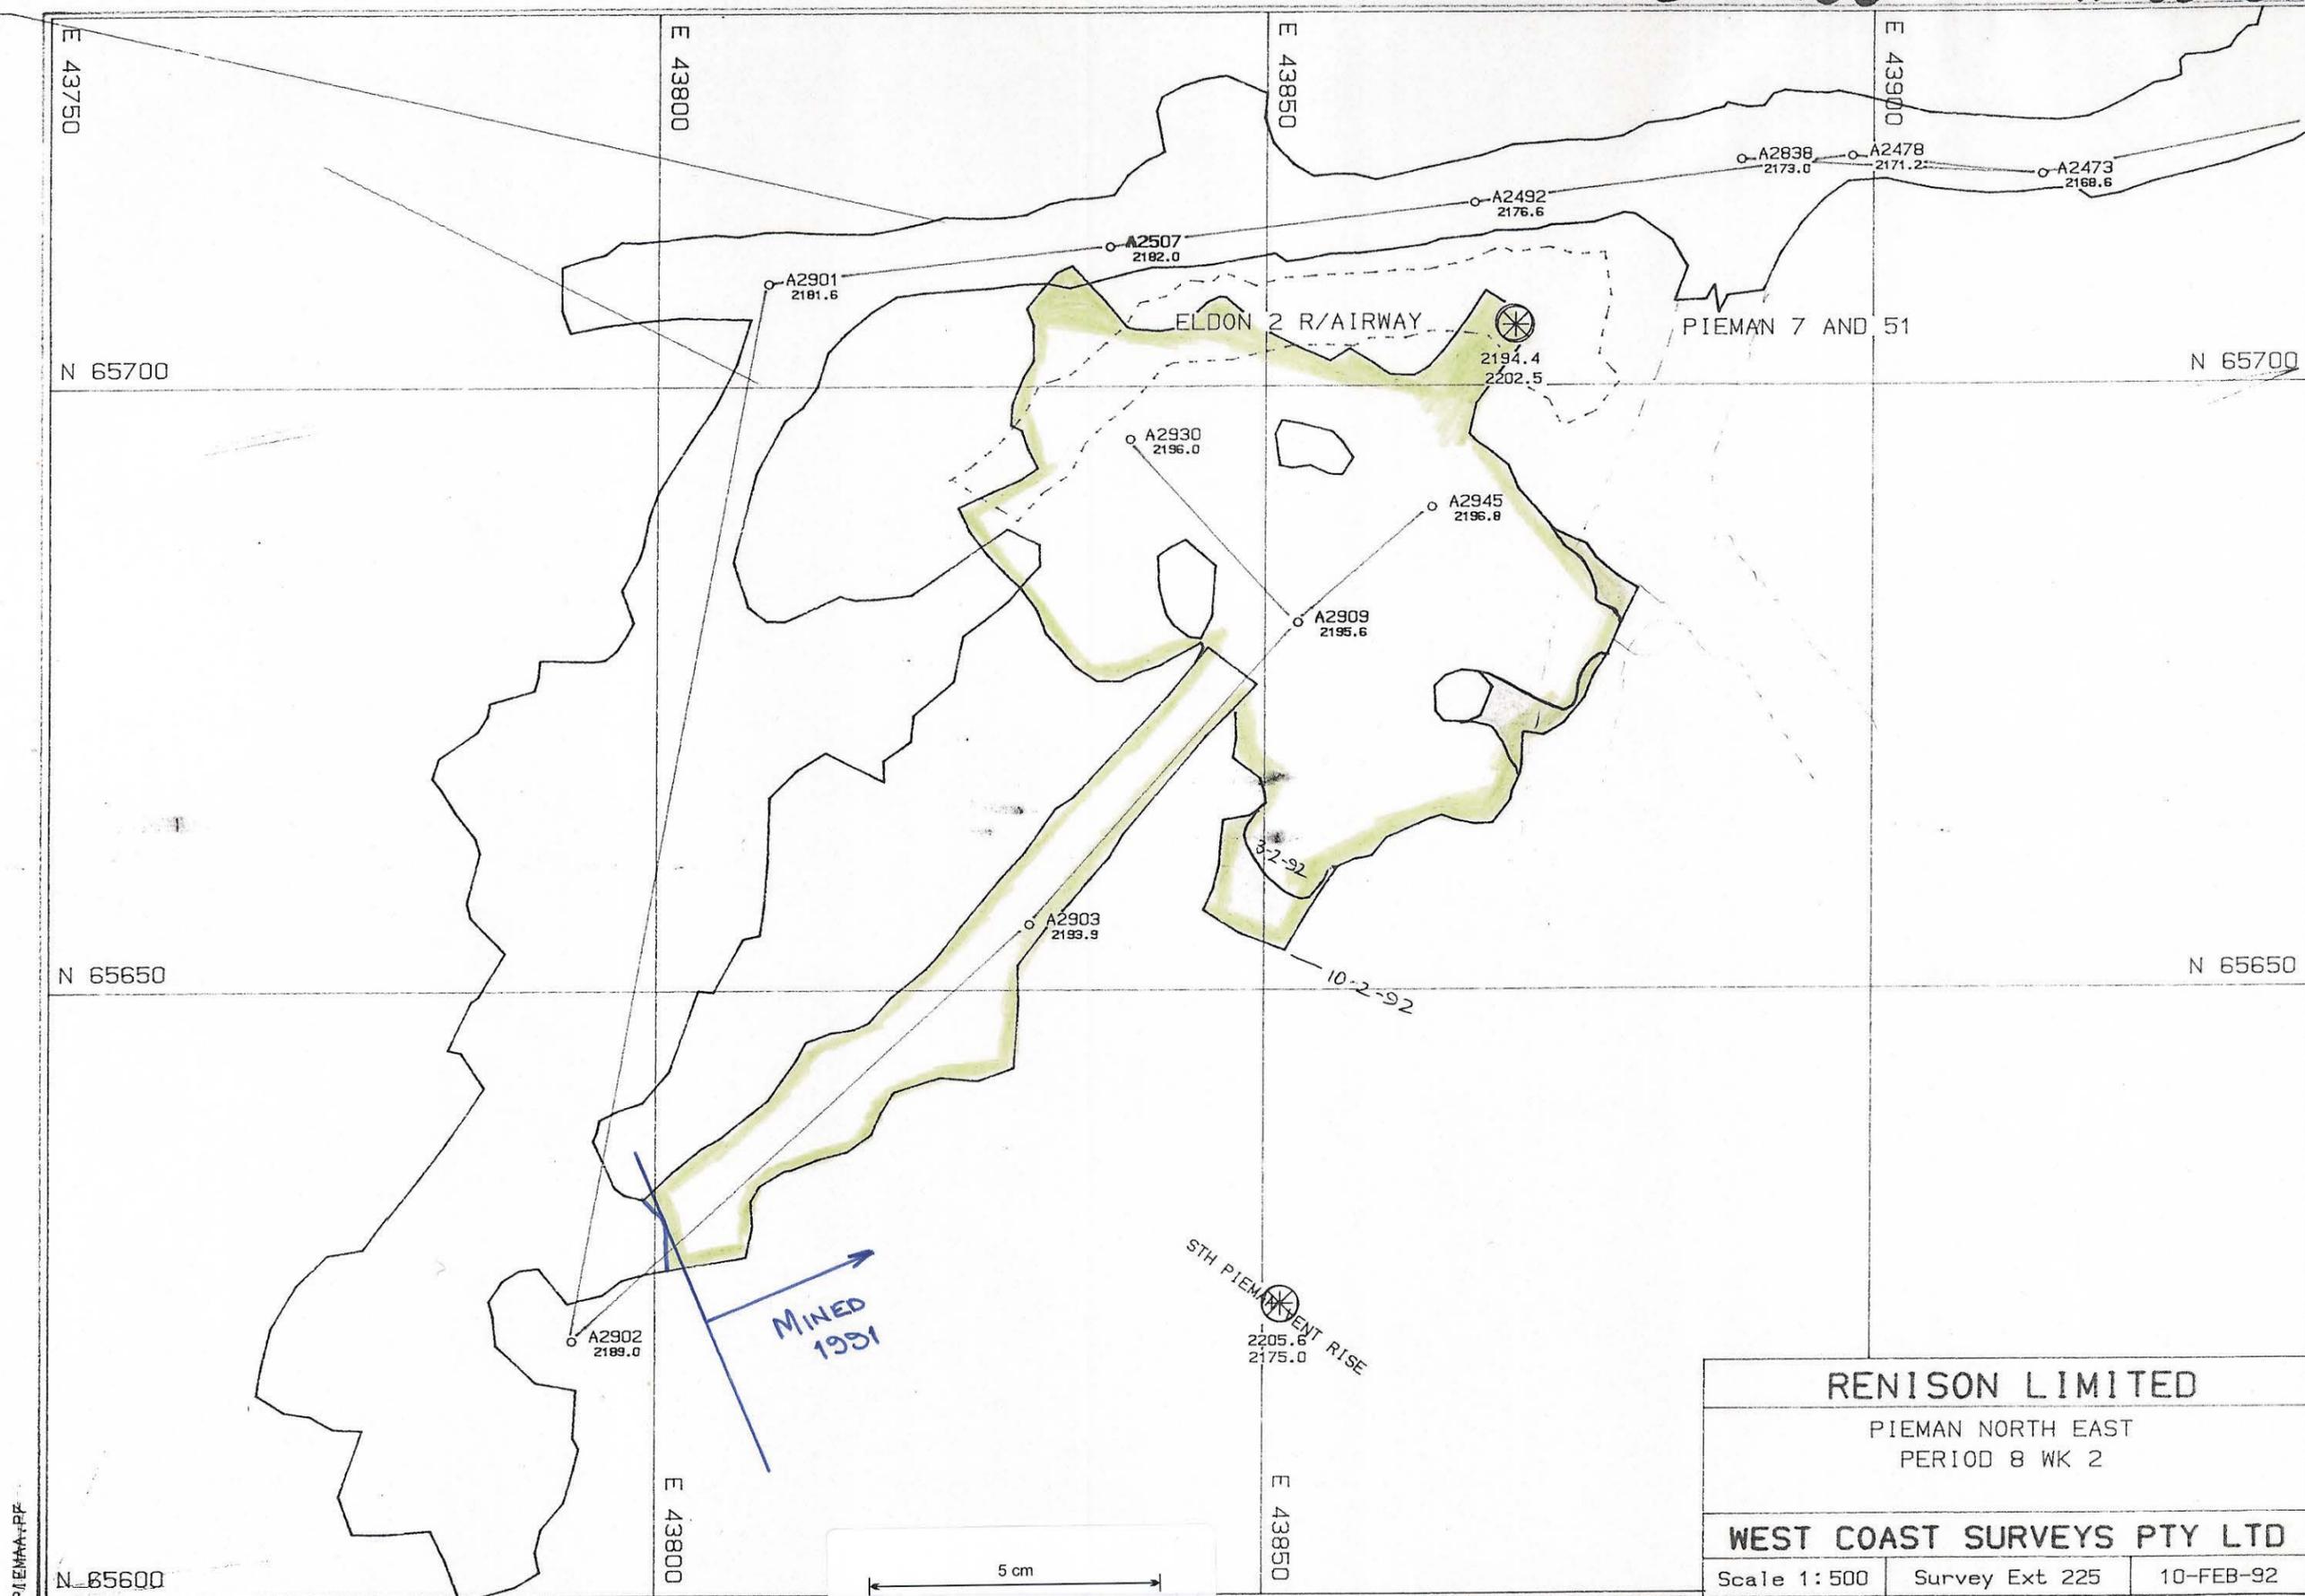

RENISON LIMITED		
PIEMAN NORTH EAST PERIOD 8 WK 2		
WEST COAST SURVEYS PTY LTD		
Scale 1:500	Survey Ext 225	10-FEB-92