


0376 - 067

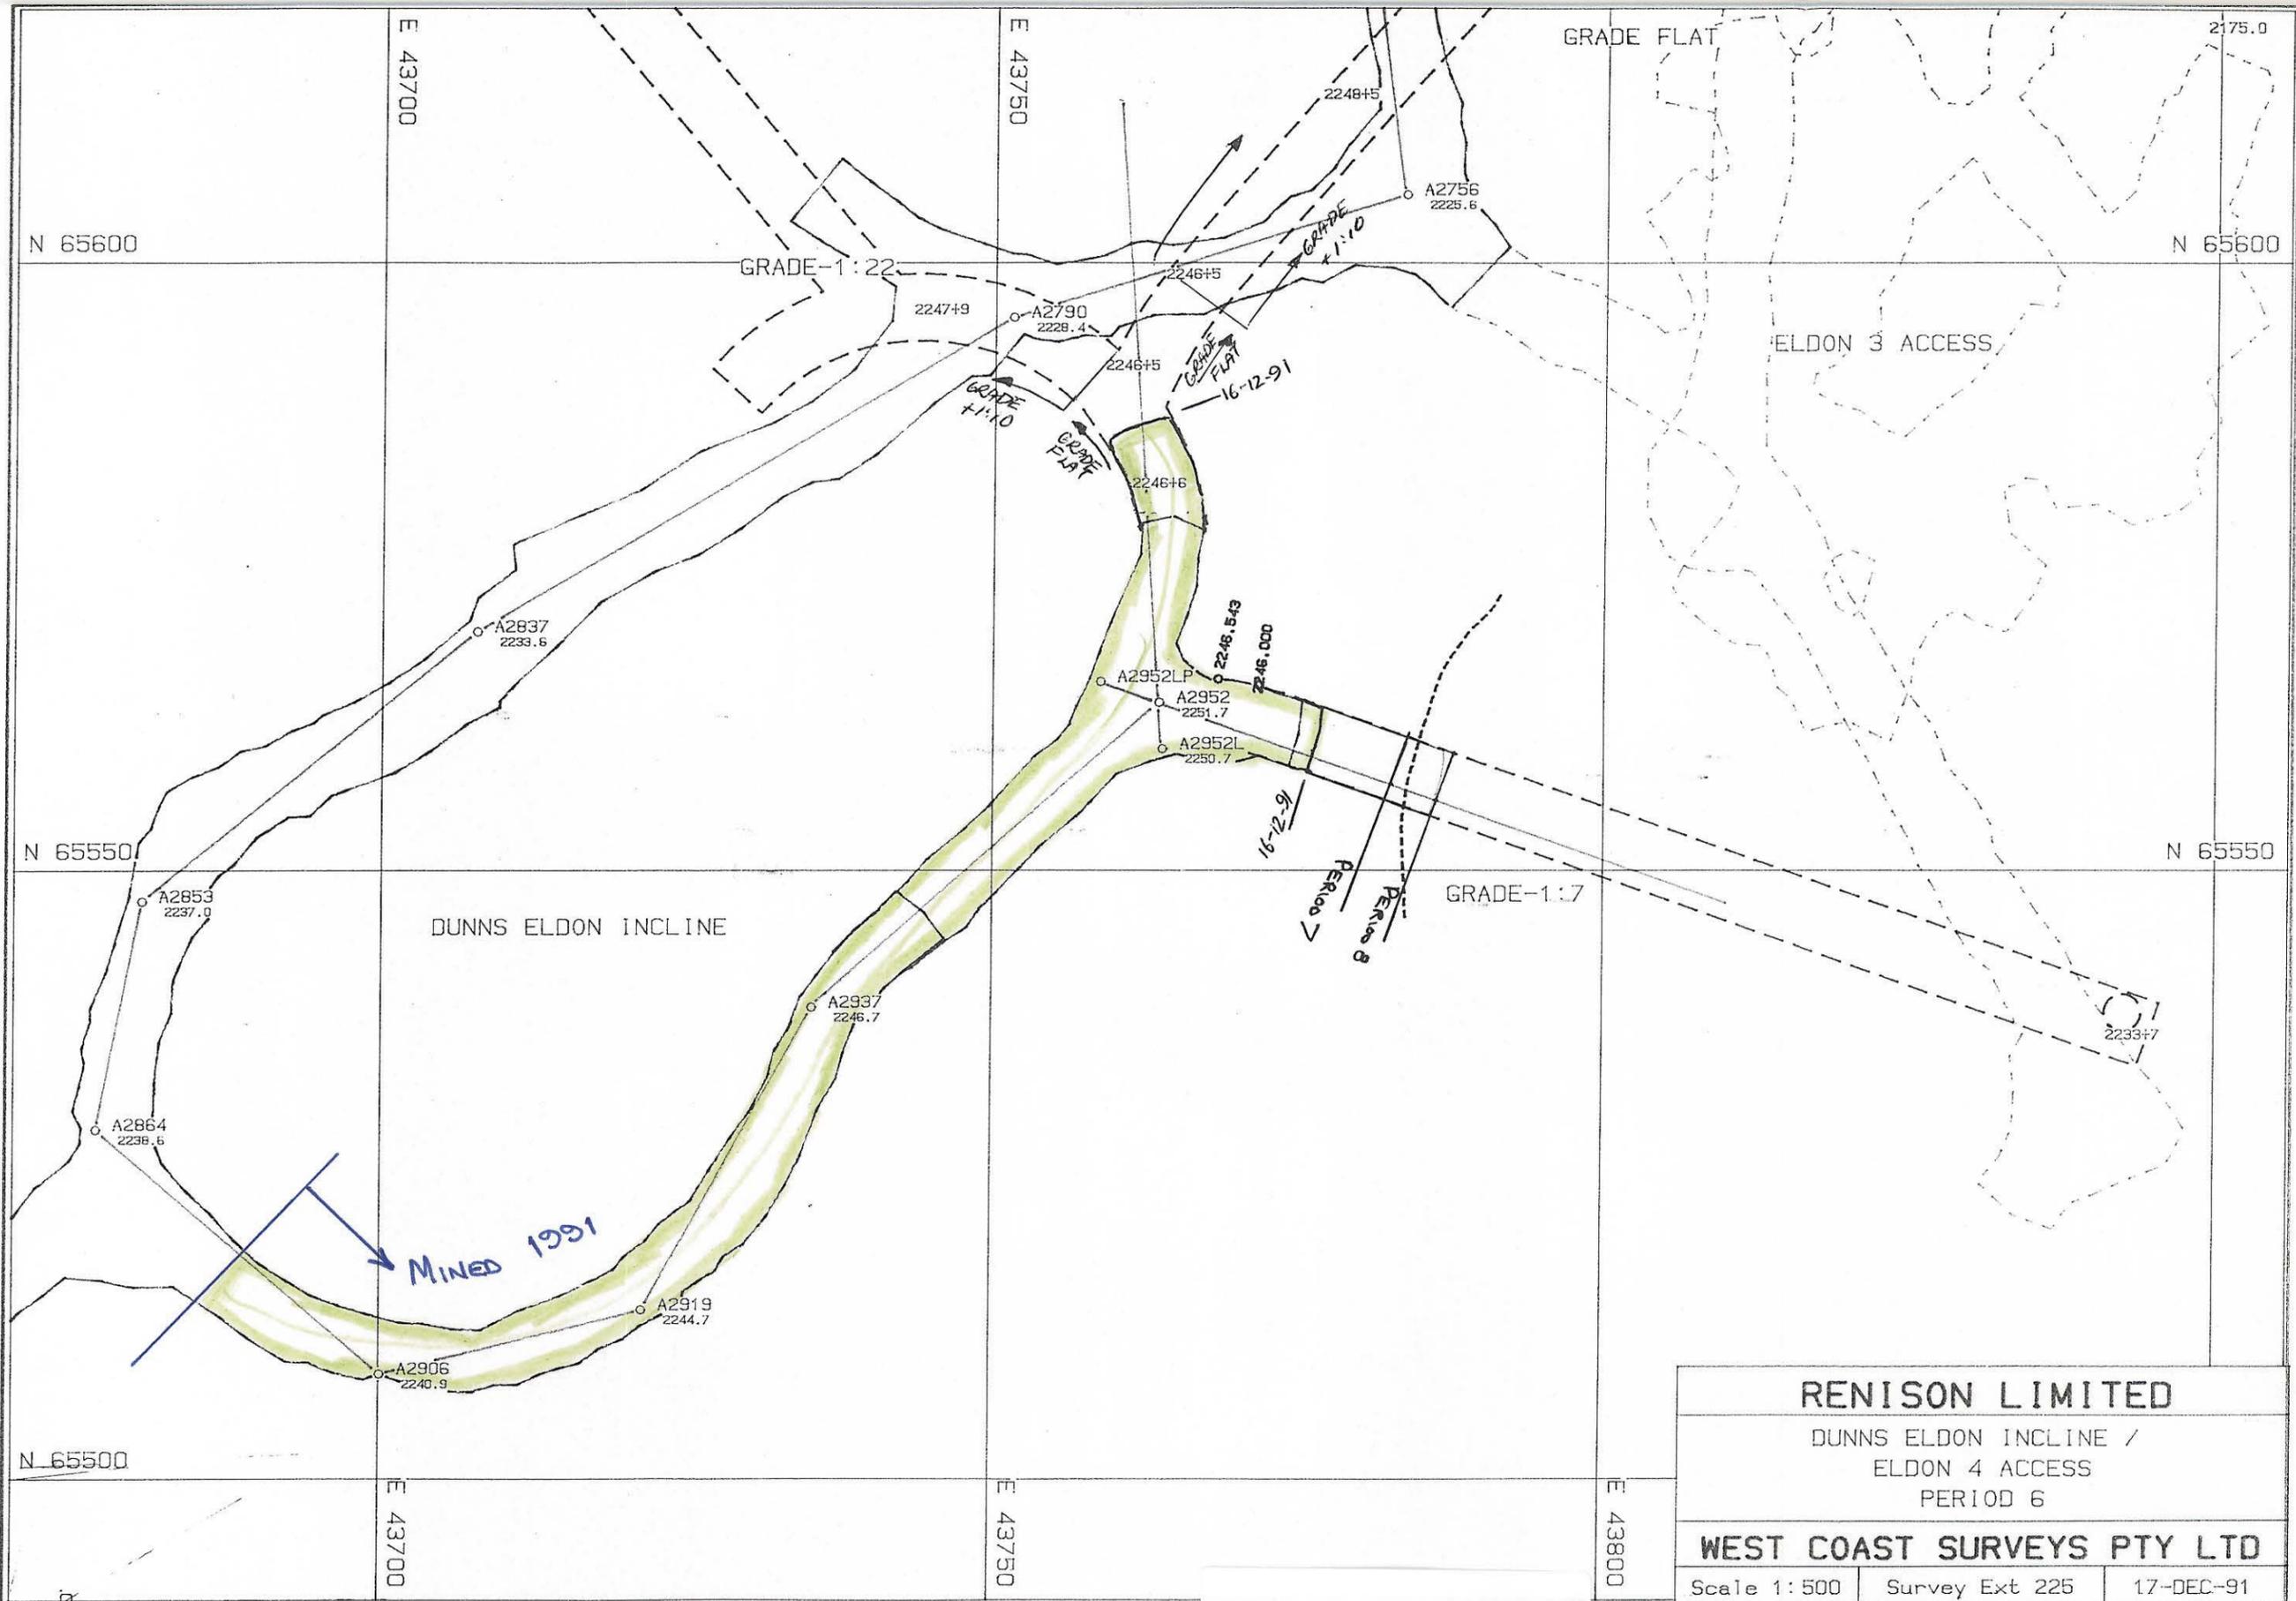

RENISON LIMITED		
DUNNS ELDON INCLINE / ELDON 4 ACCESS PERIOD 6		
WEST COAST SURVEYS PTY LTD		
Scale 1:500	Survey Ext 225	17-DEC-91

