


0376 - 068

8-10-91

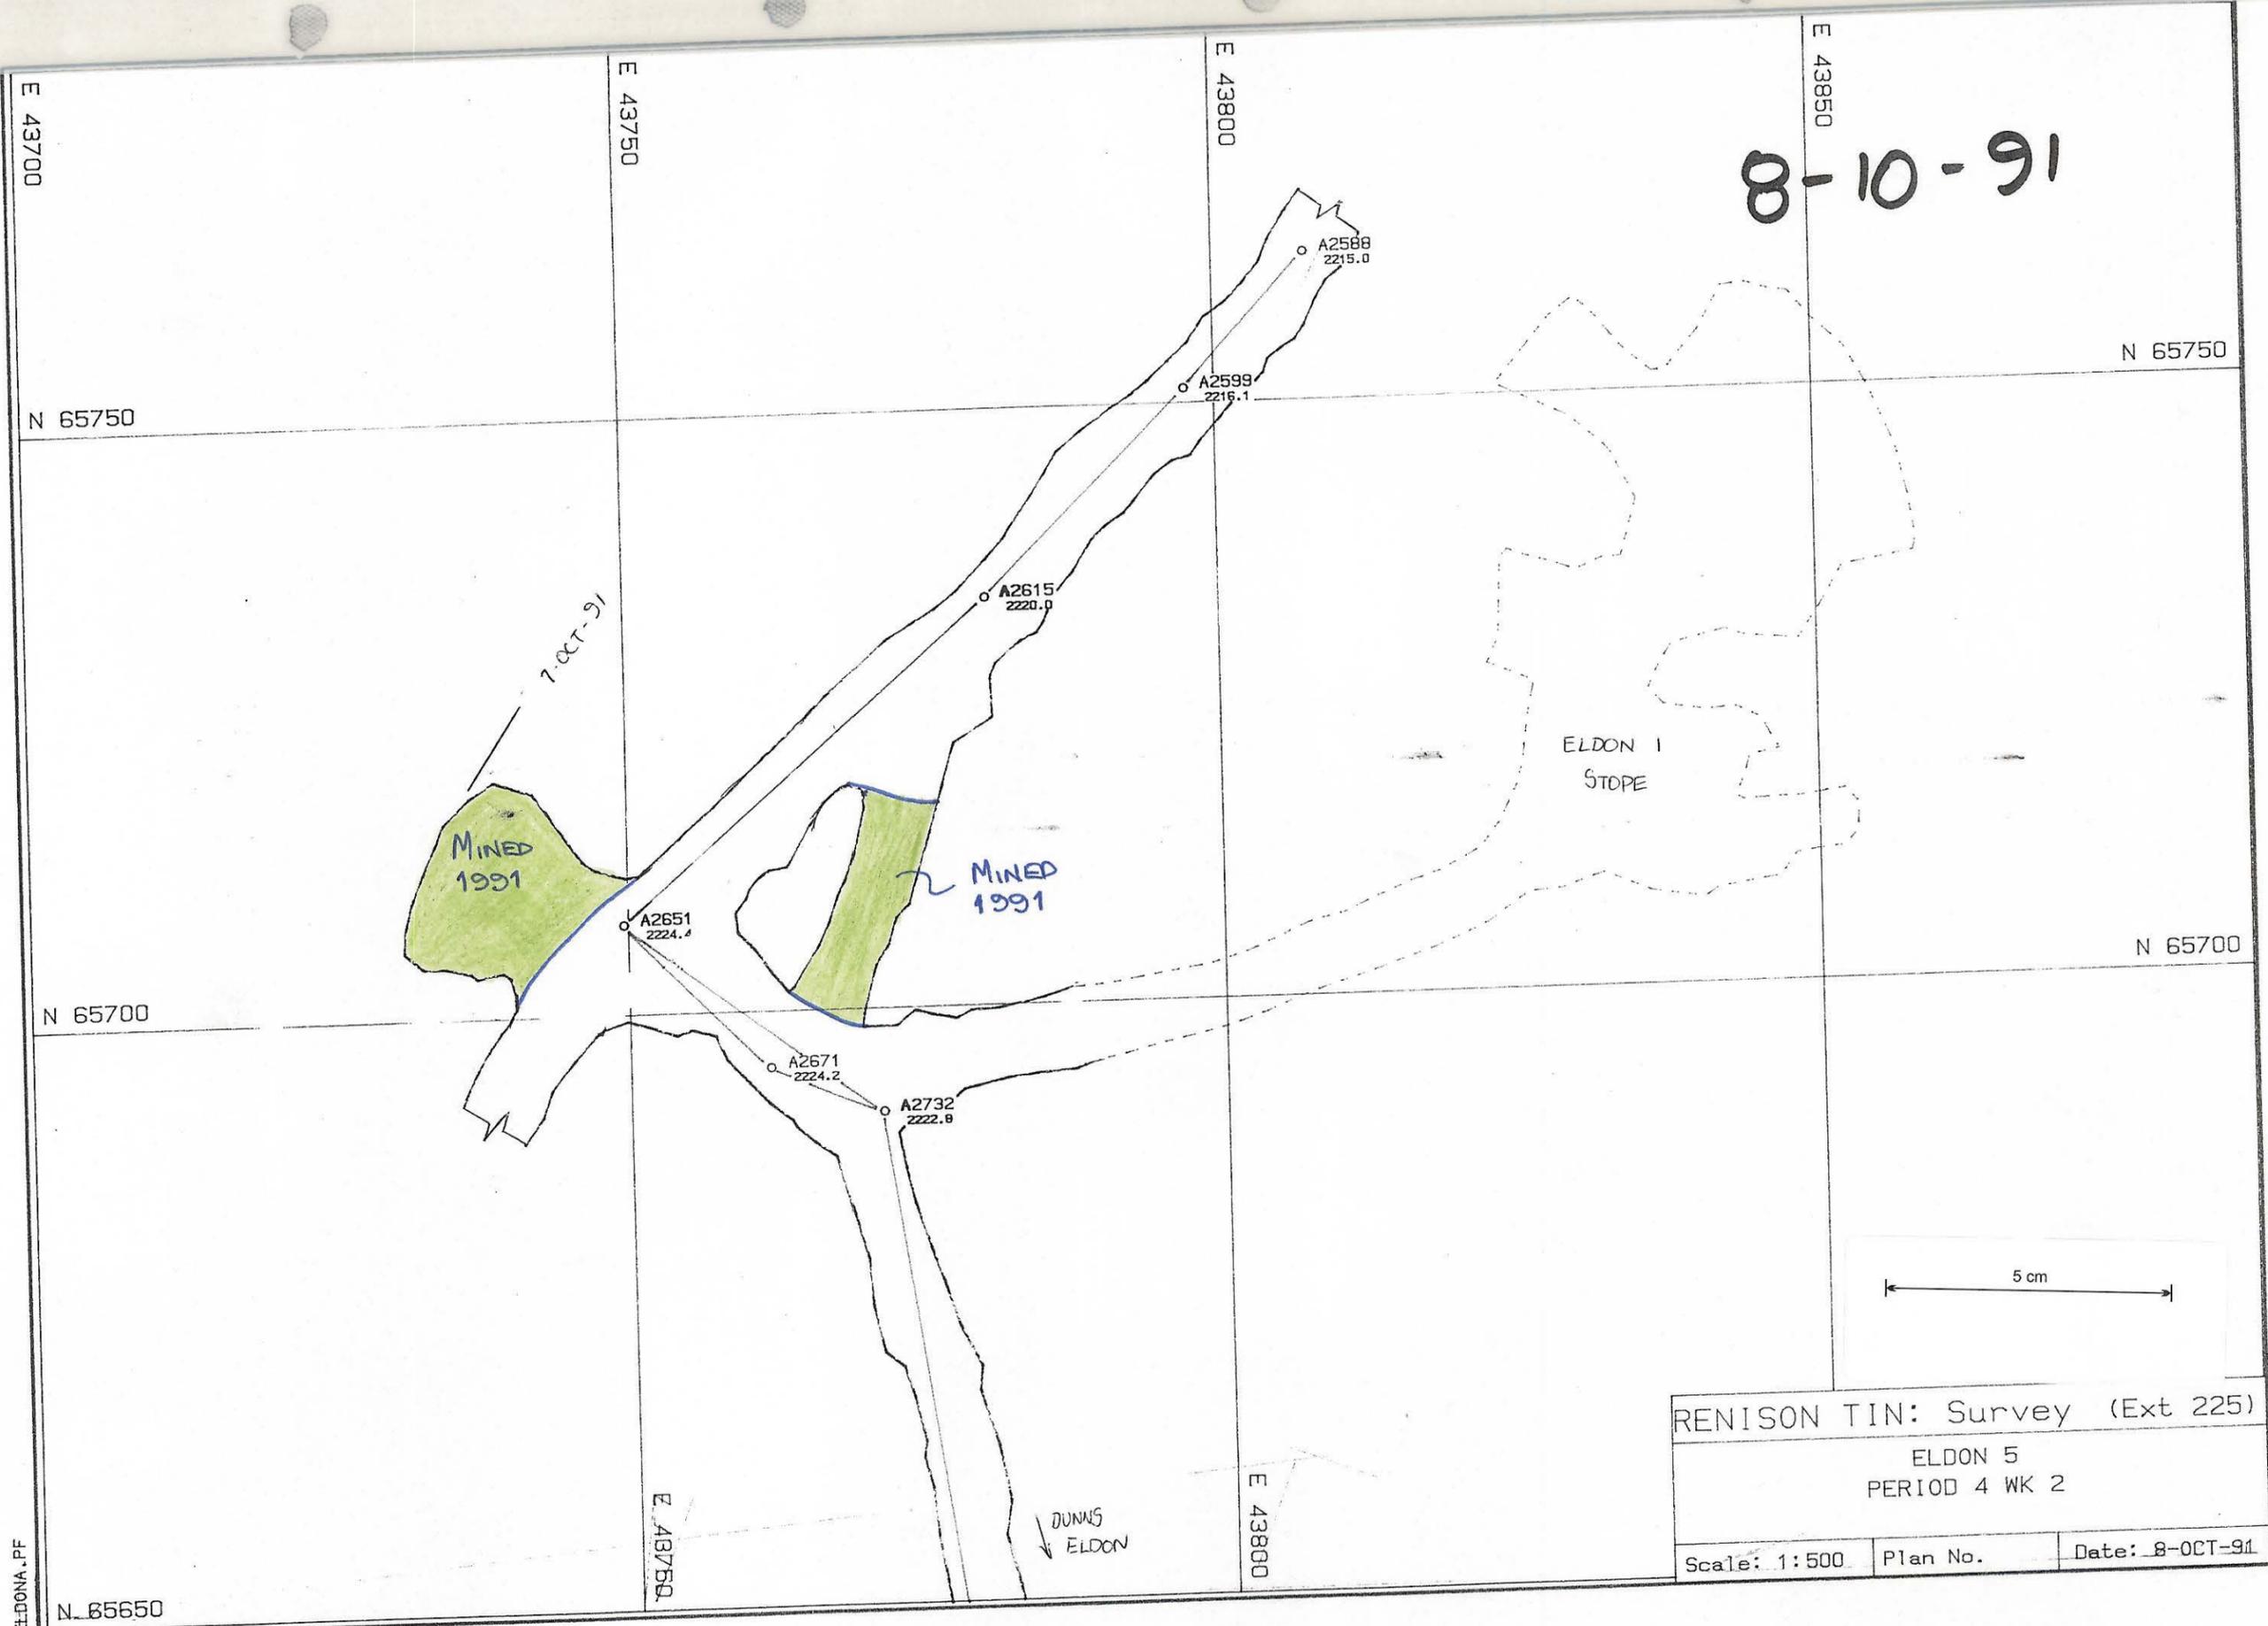

RENISON TIN: Survey (Ext 225)		
ELDON 5		
PERIOD 4 WK 2		
Scale: 1:500	Plan No.	Date: 8-OCT-91