


0376-069

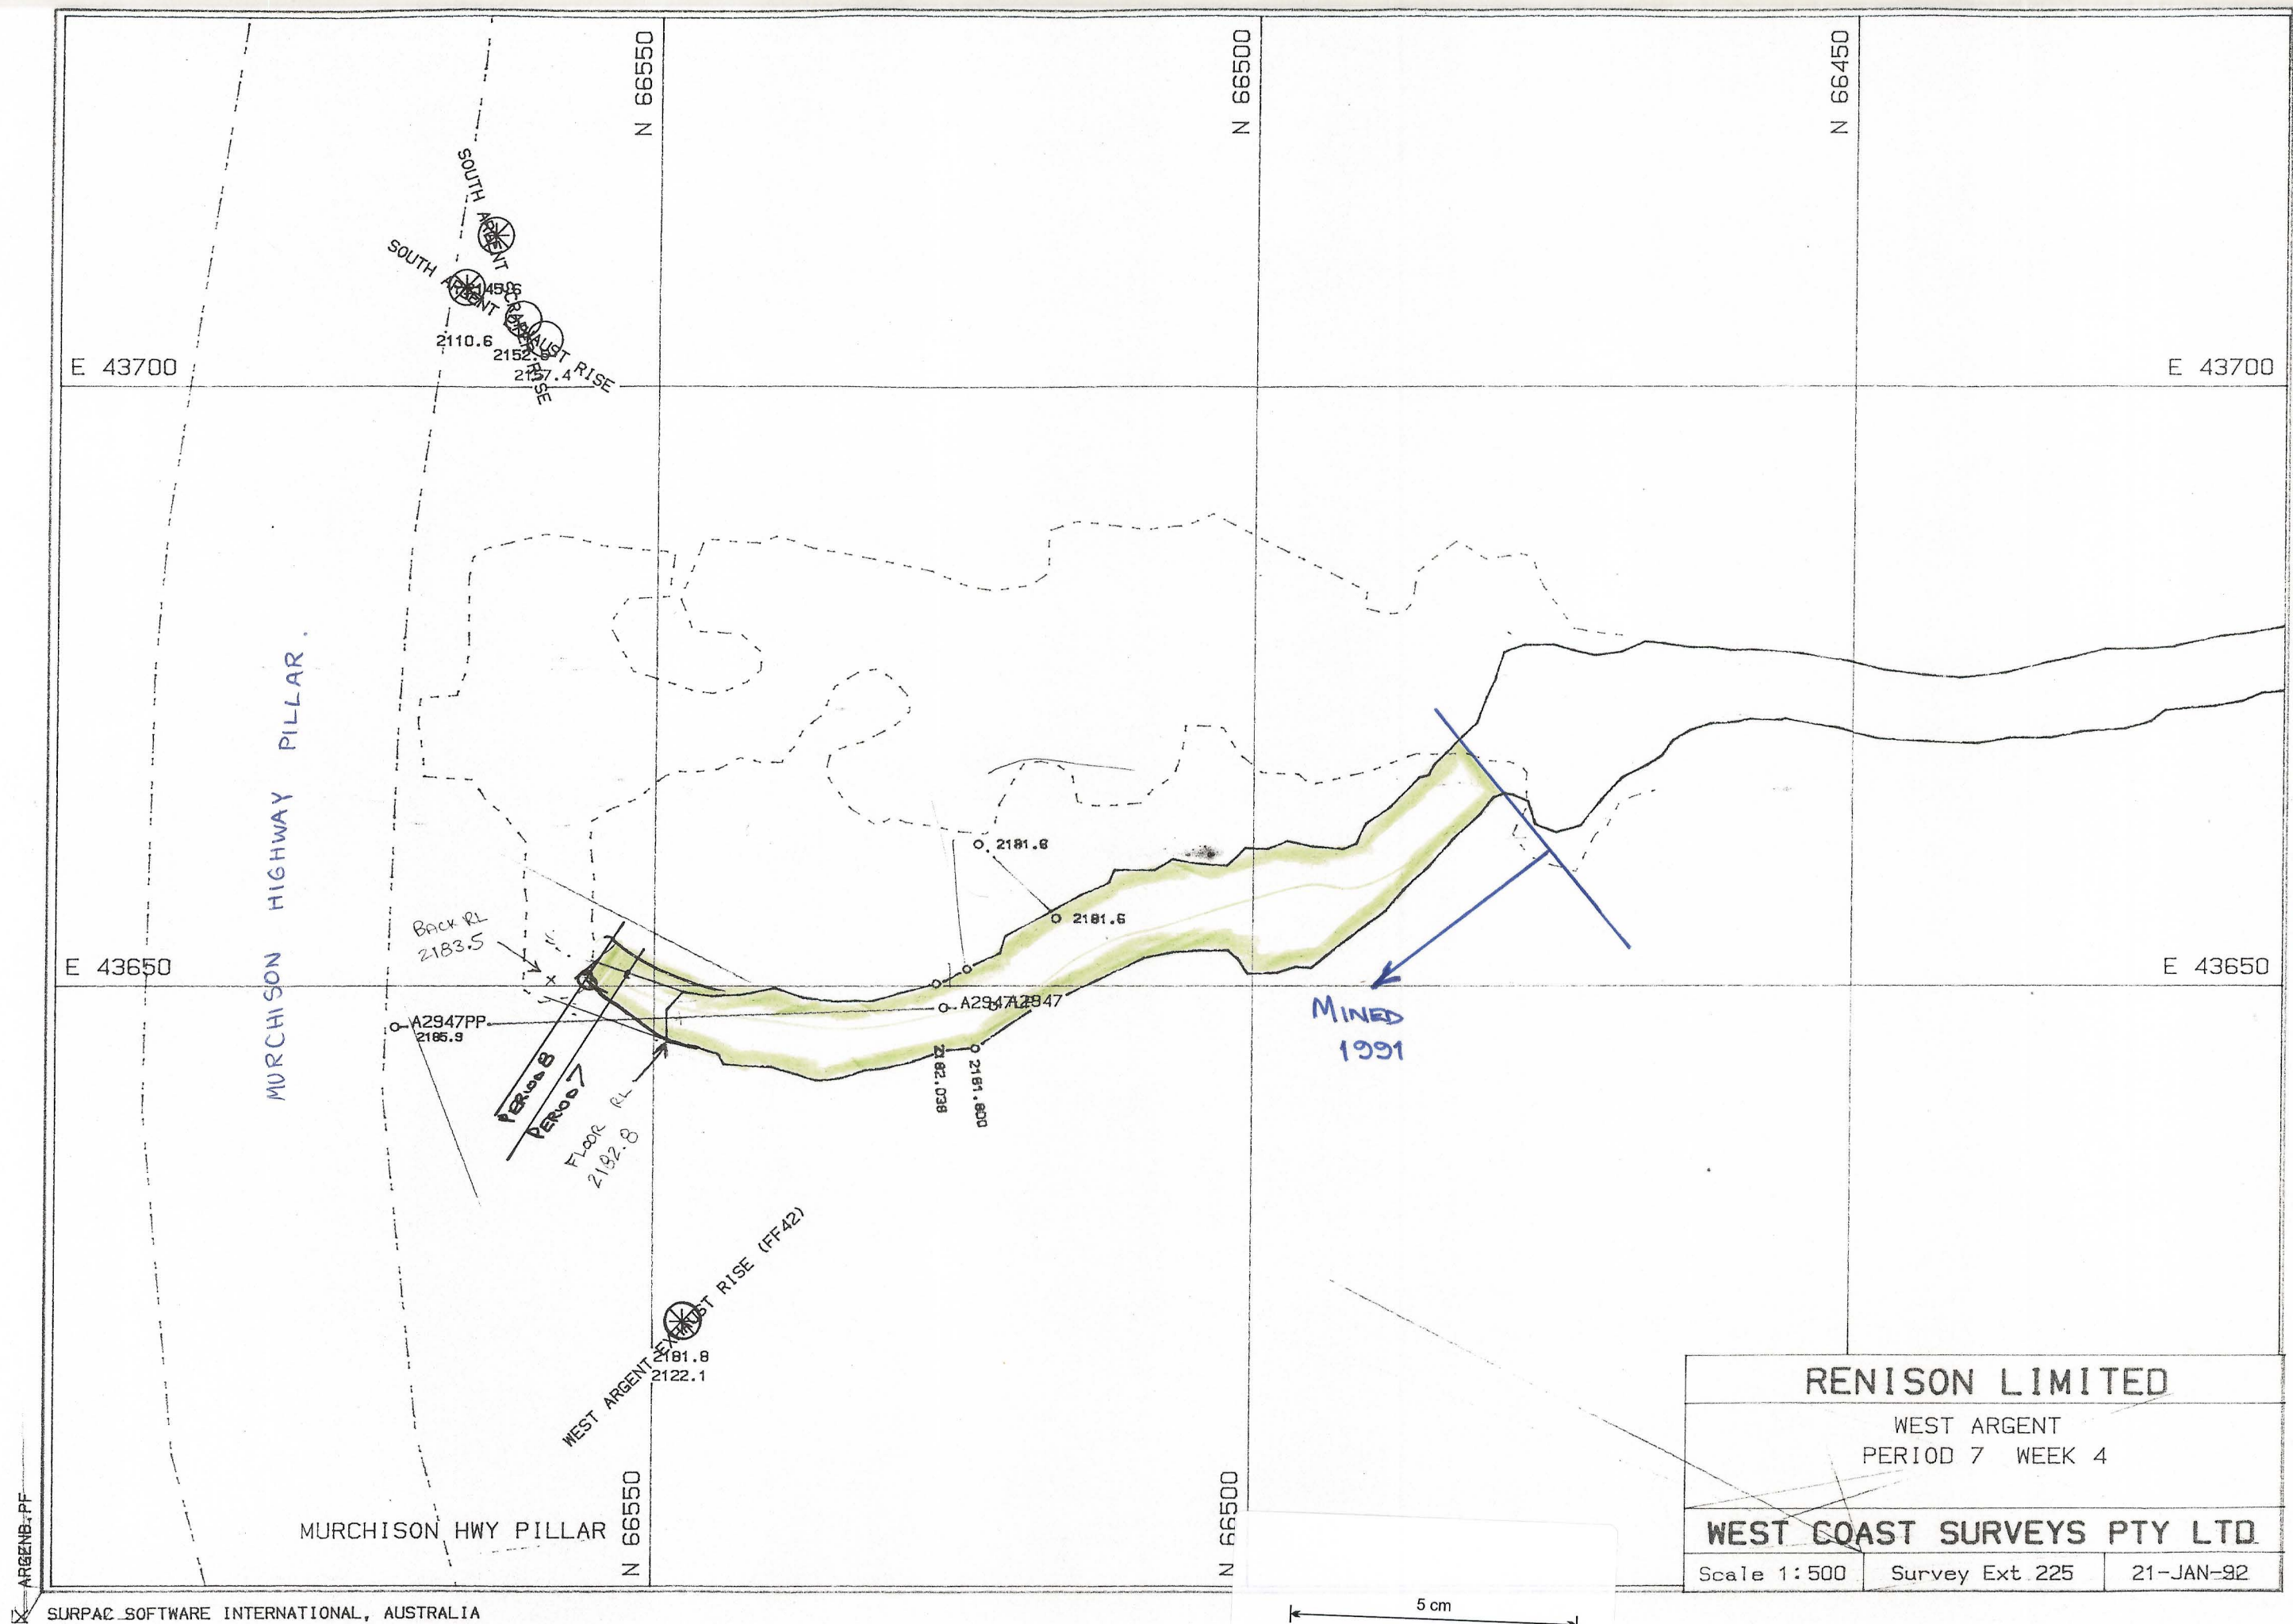

RENISON LIMITED

WEST ARGENT
PERIOD 7 WEEK 4

WEST COAST SURVEYS PTY LTD

Scale 1:500 Survey Ext 225 21-JAN-92

ARGENT PF