


0376-072

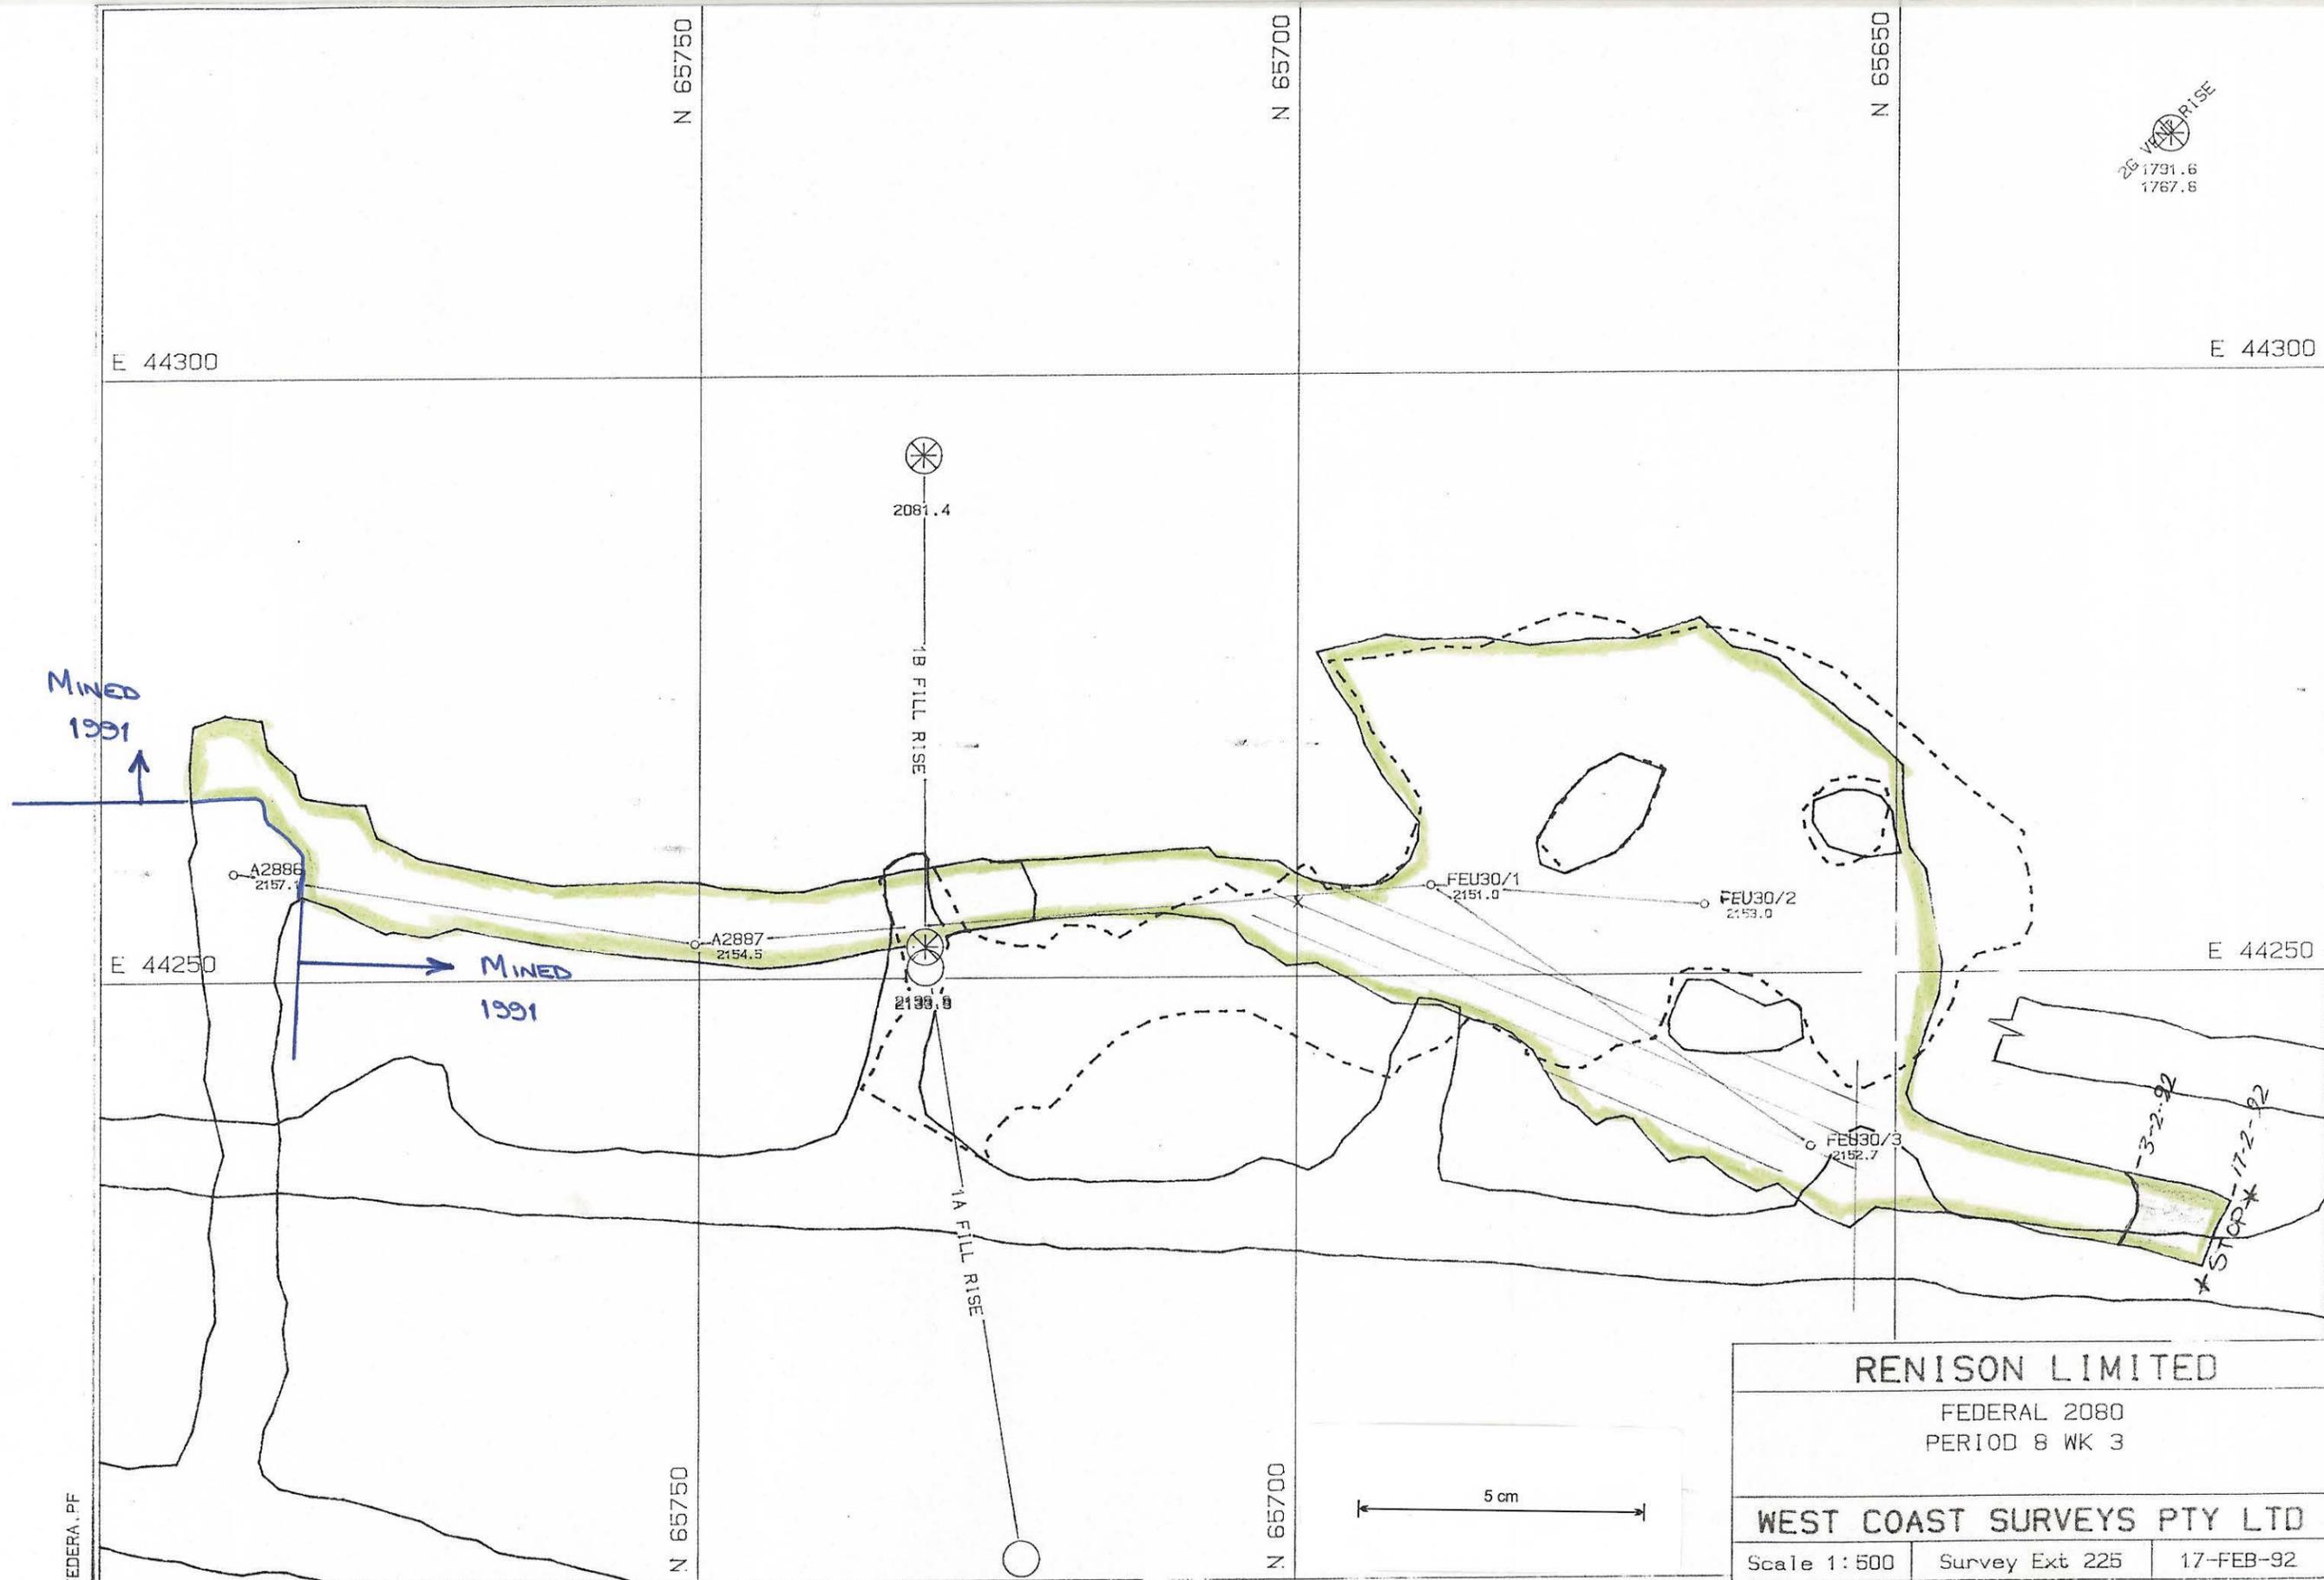

RENISON LIMITED		
FEDERAL 2080		
PERIOD 8 WK 3		
WEST COAST SURVEYS PTY LTD		
Scale 1:500	Survey Ext 225	17-FEB-92

FEDERA.PF