


0376-073

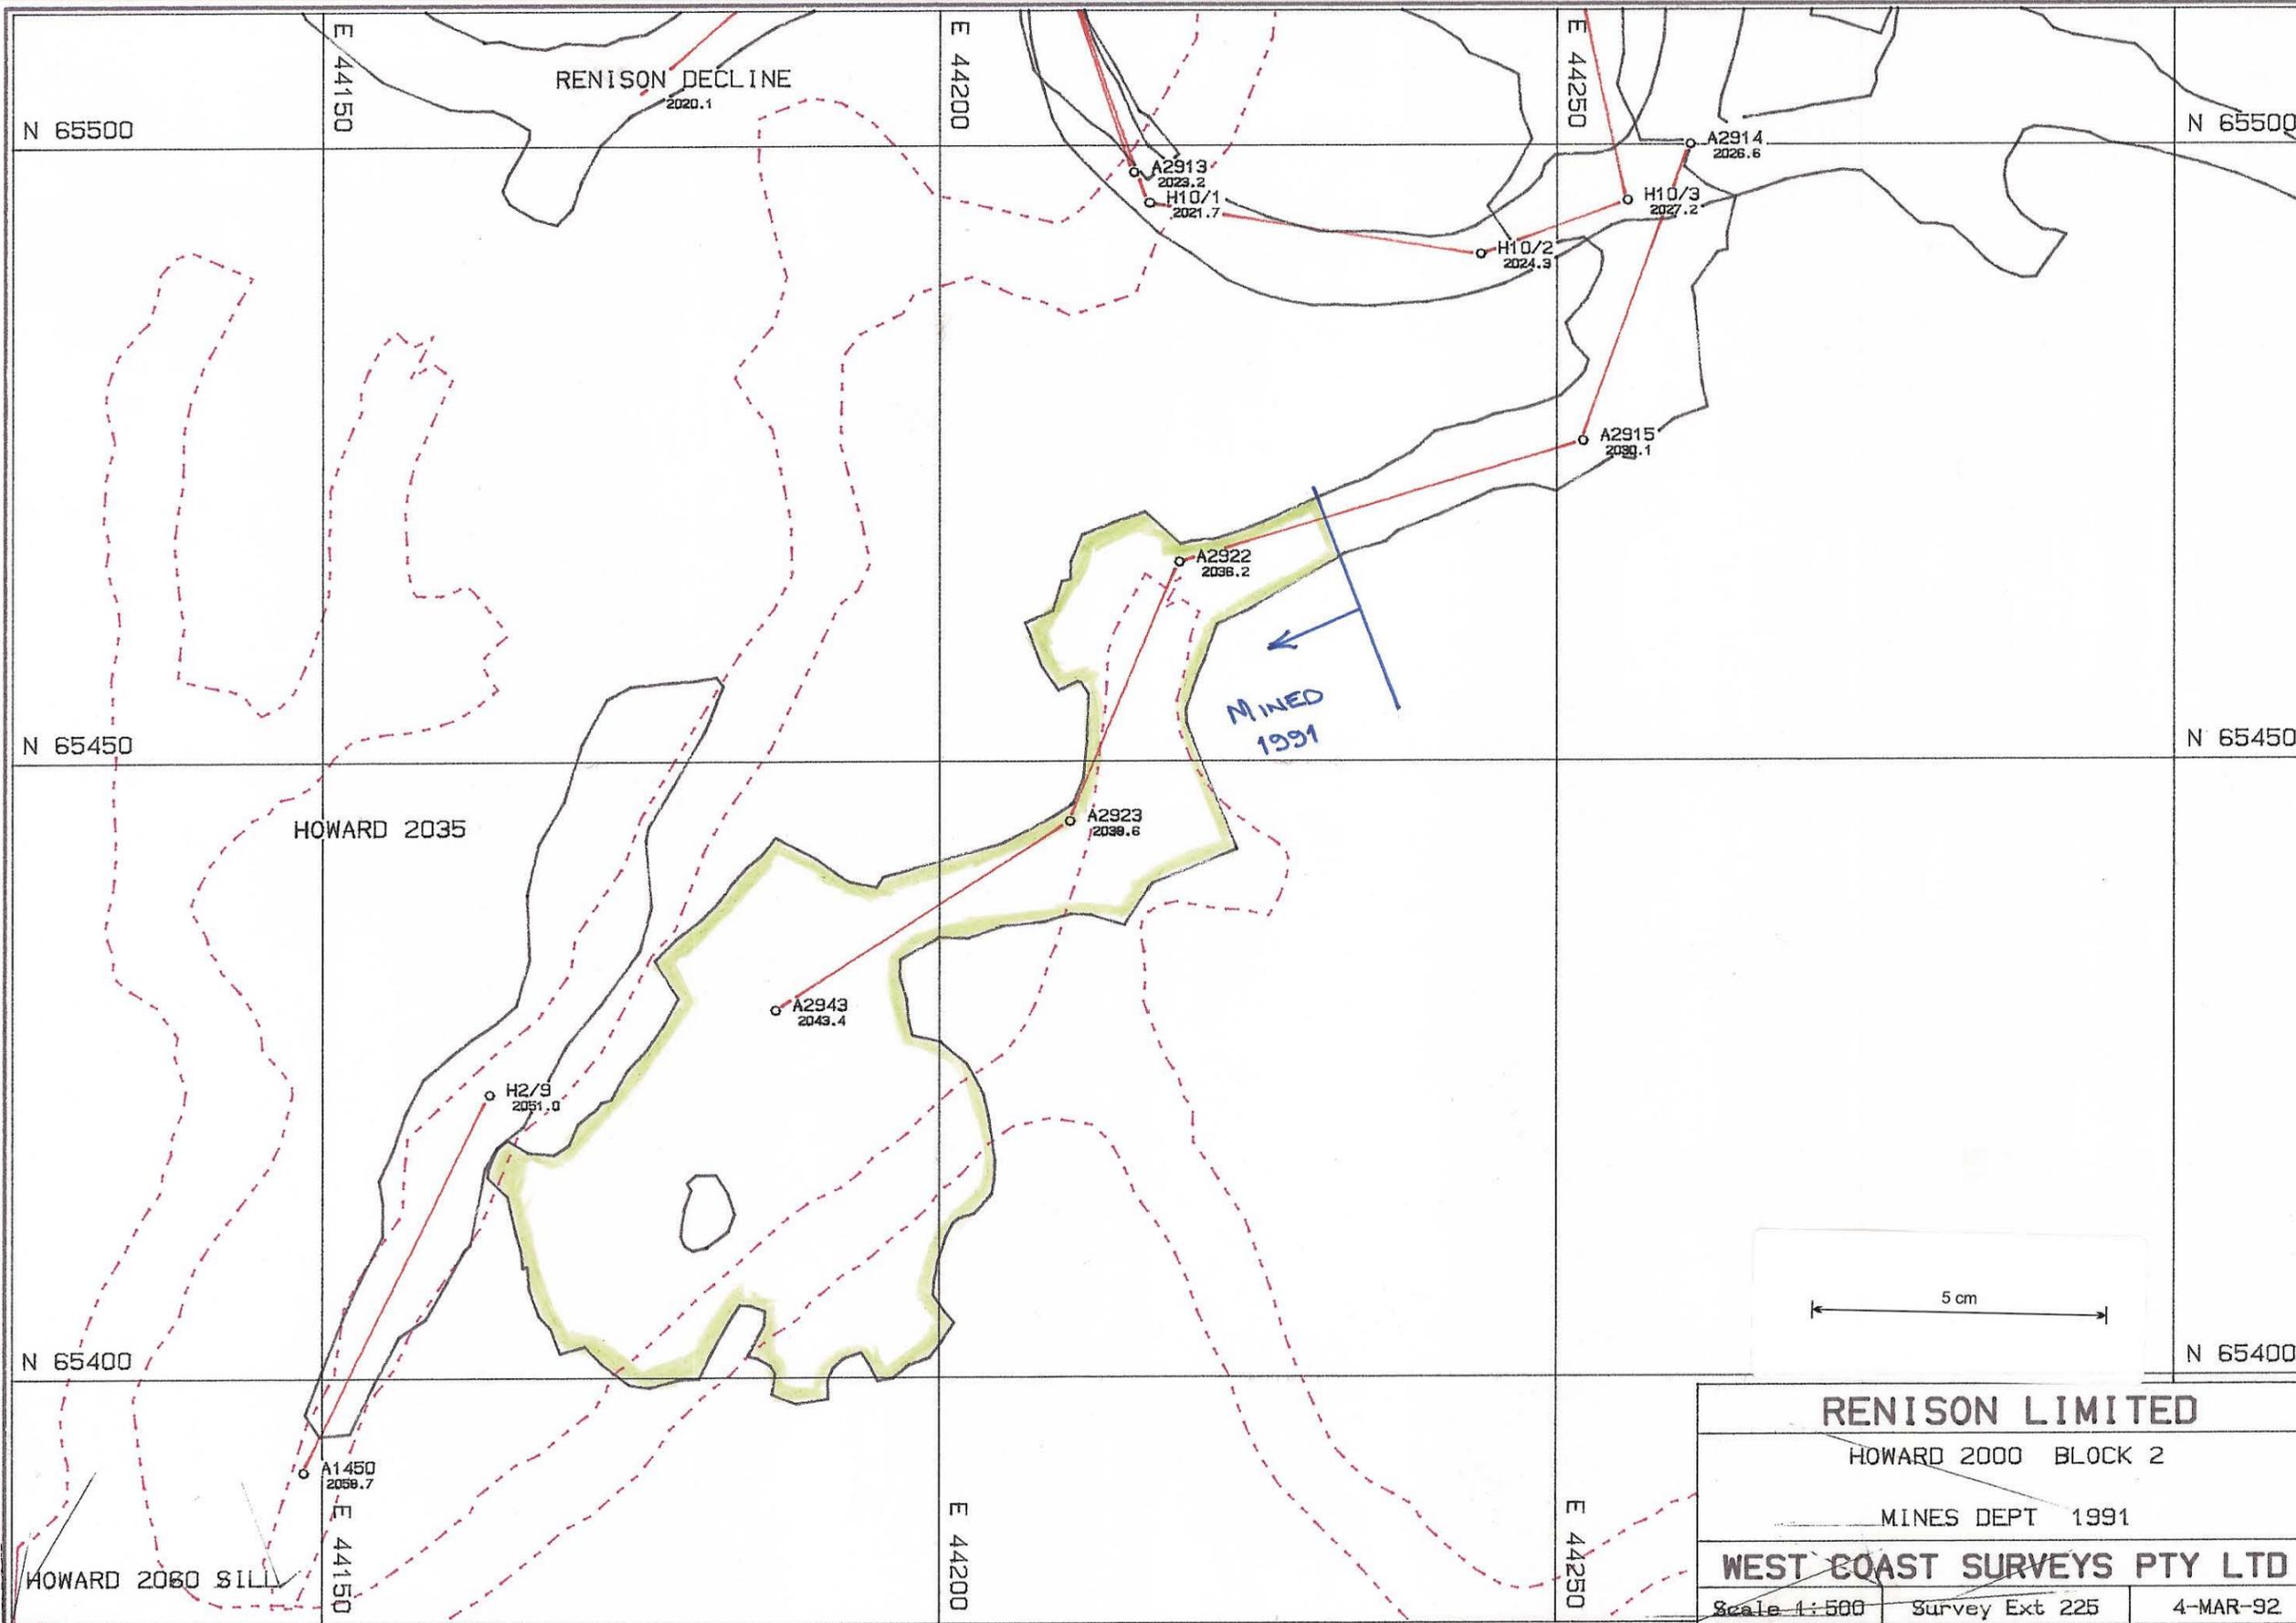

RENISON LIMITED		
HOWARD 2000 BLOCK 2		
MINES DEPT 1991		
WEST COAST SURVEYS PTY LTD		
Scale 1:500	Survey Ext 225	4-MAR-92

HOWARD-PE