



0376-074

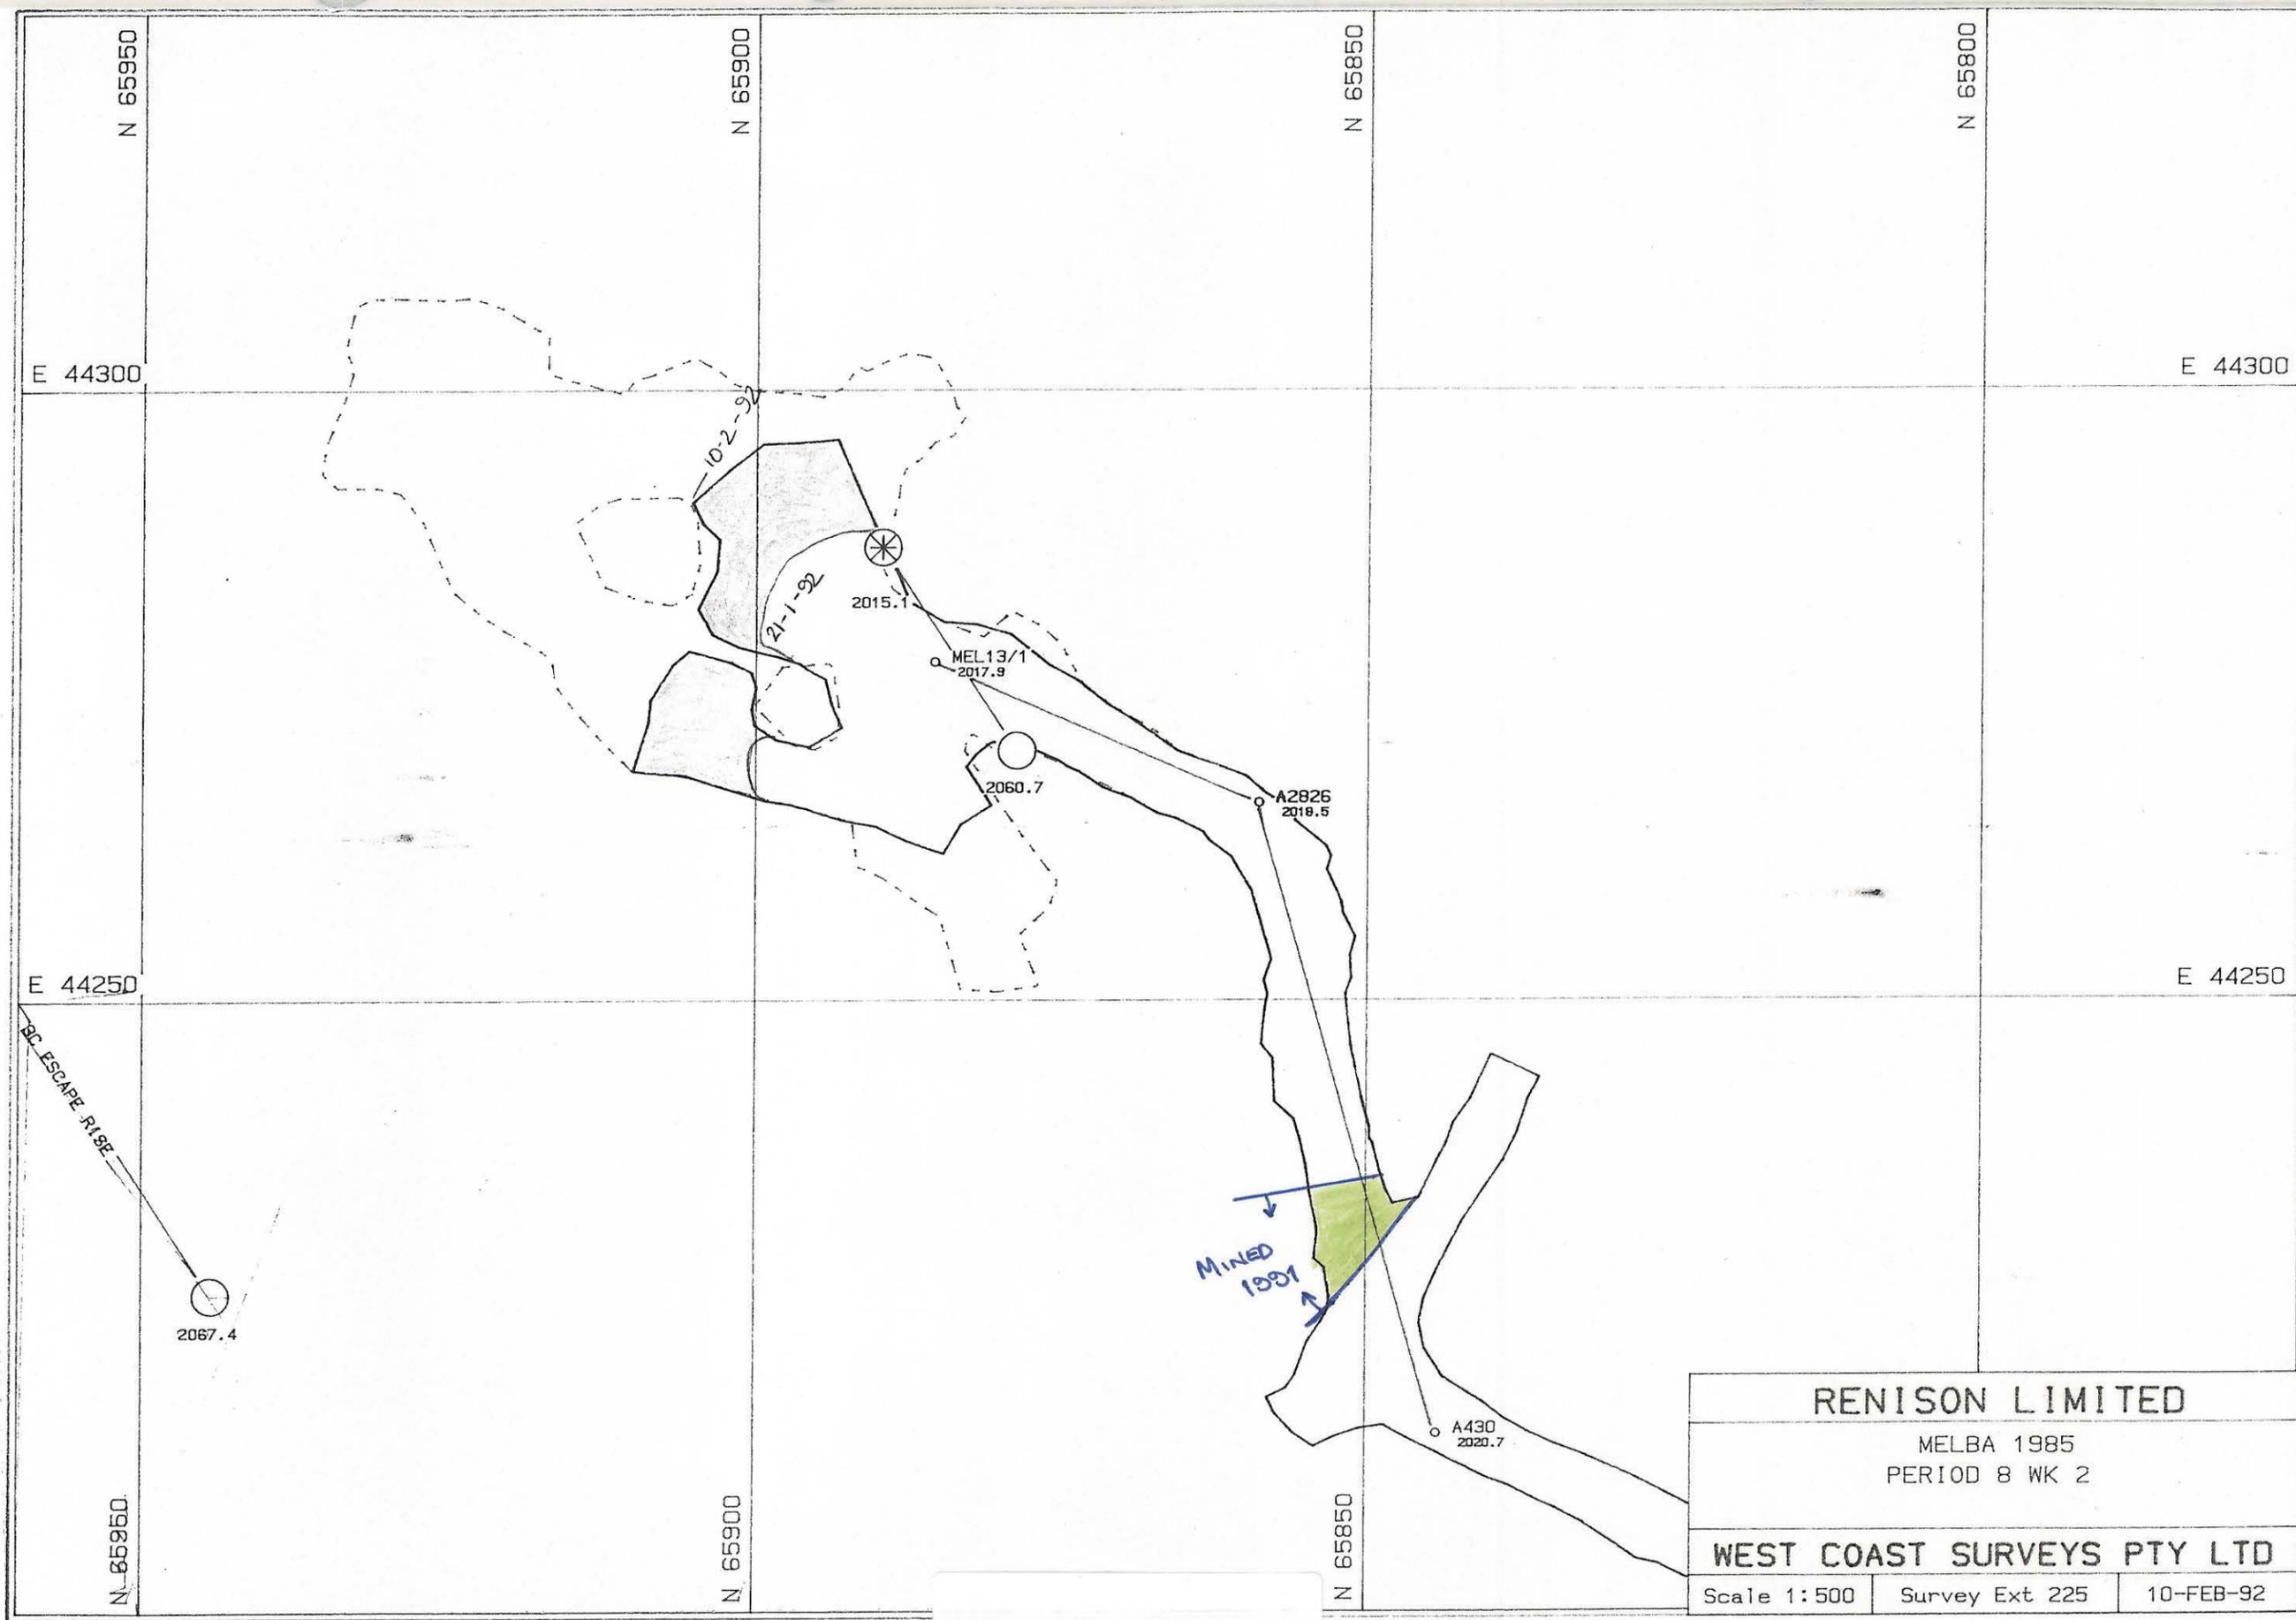

RENISON LIMITED		
MELBA 1985 PERIOD 8 WK 2		
WEST COAST SURVEYS PTY LTD		
Scale 1:500	Survey Ext 225	10-FEB-92

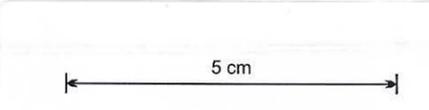

MELBAP.PF