


0376-075

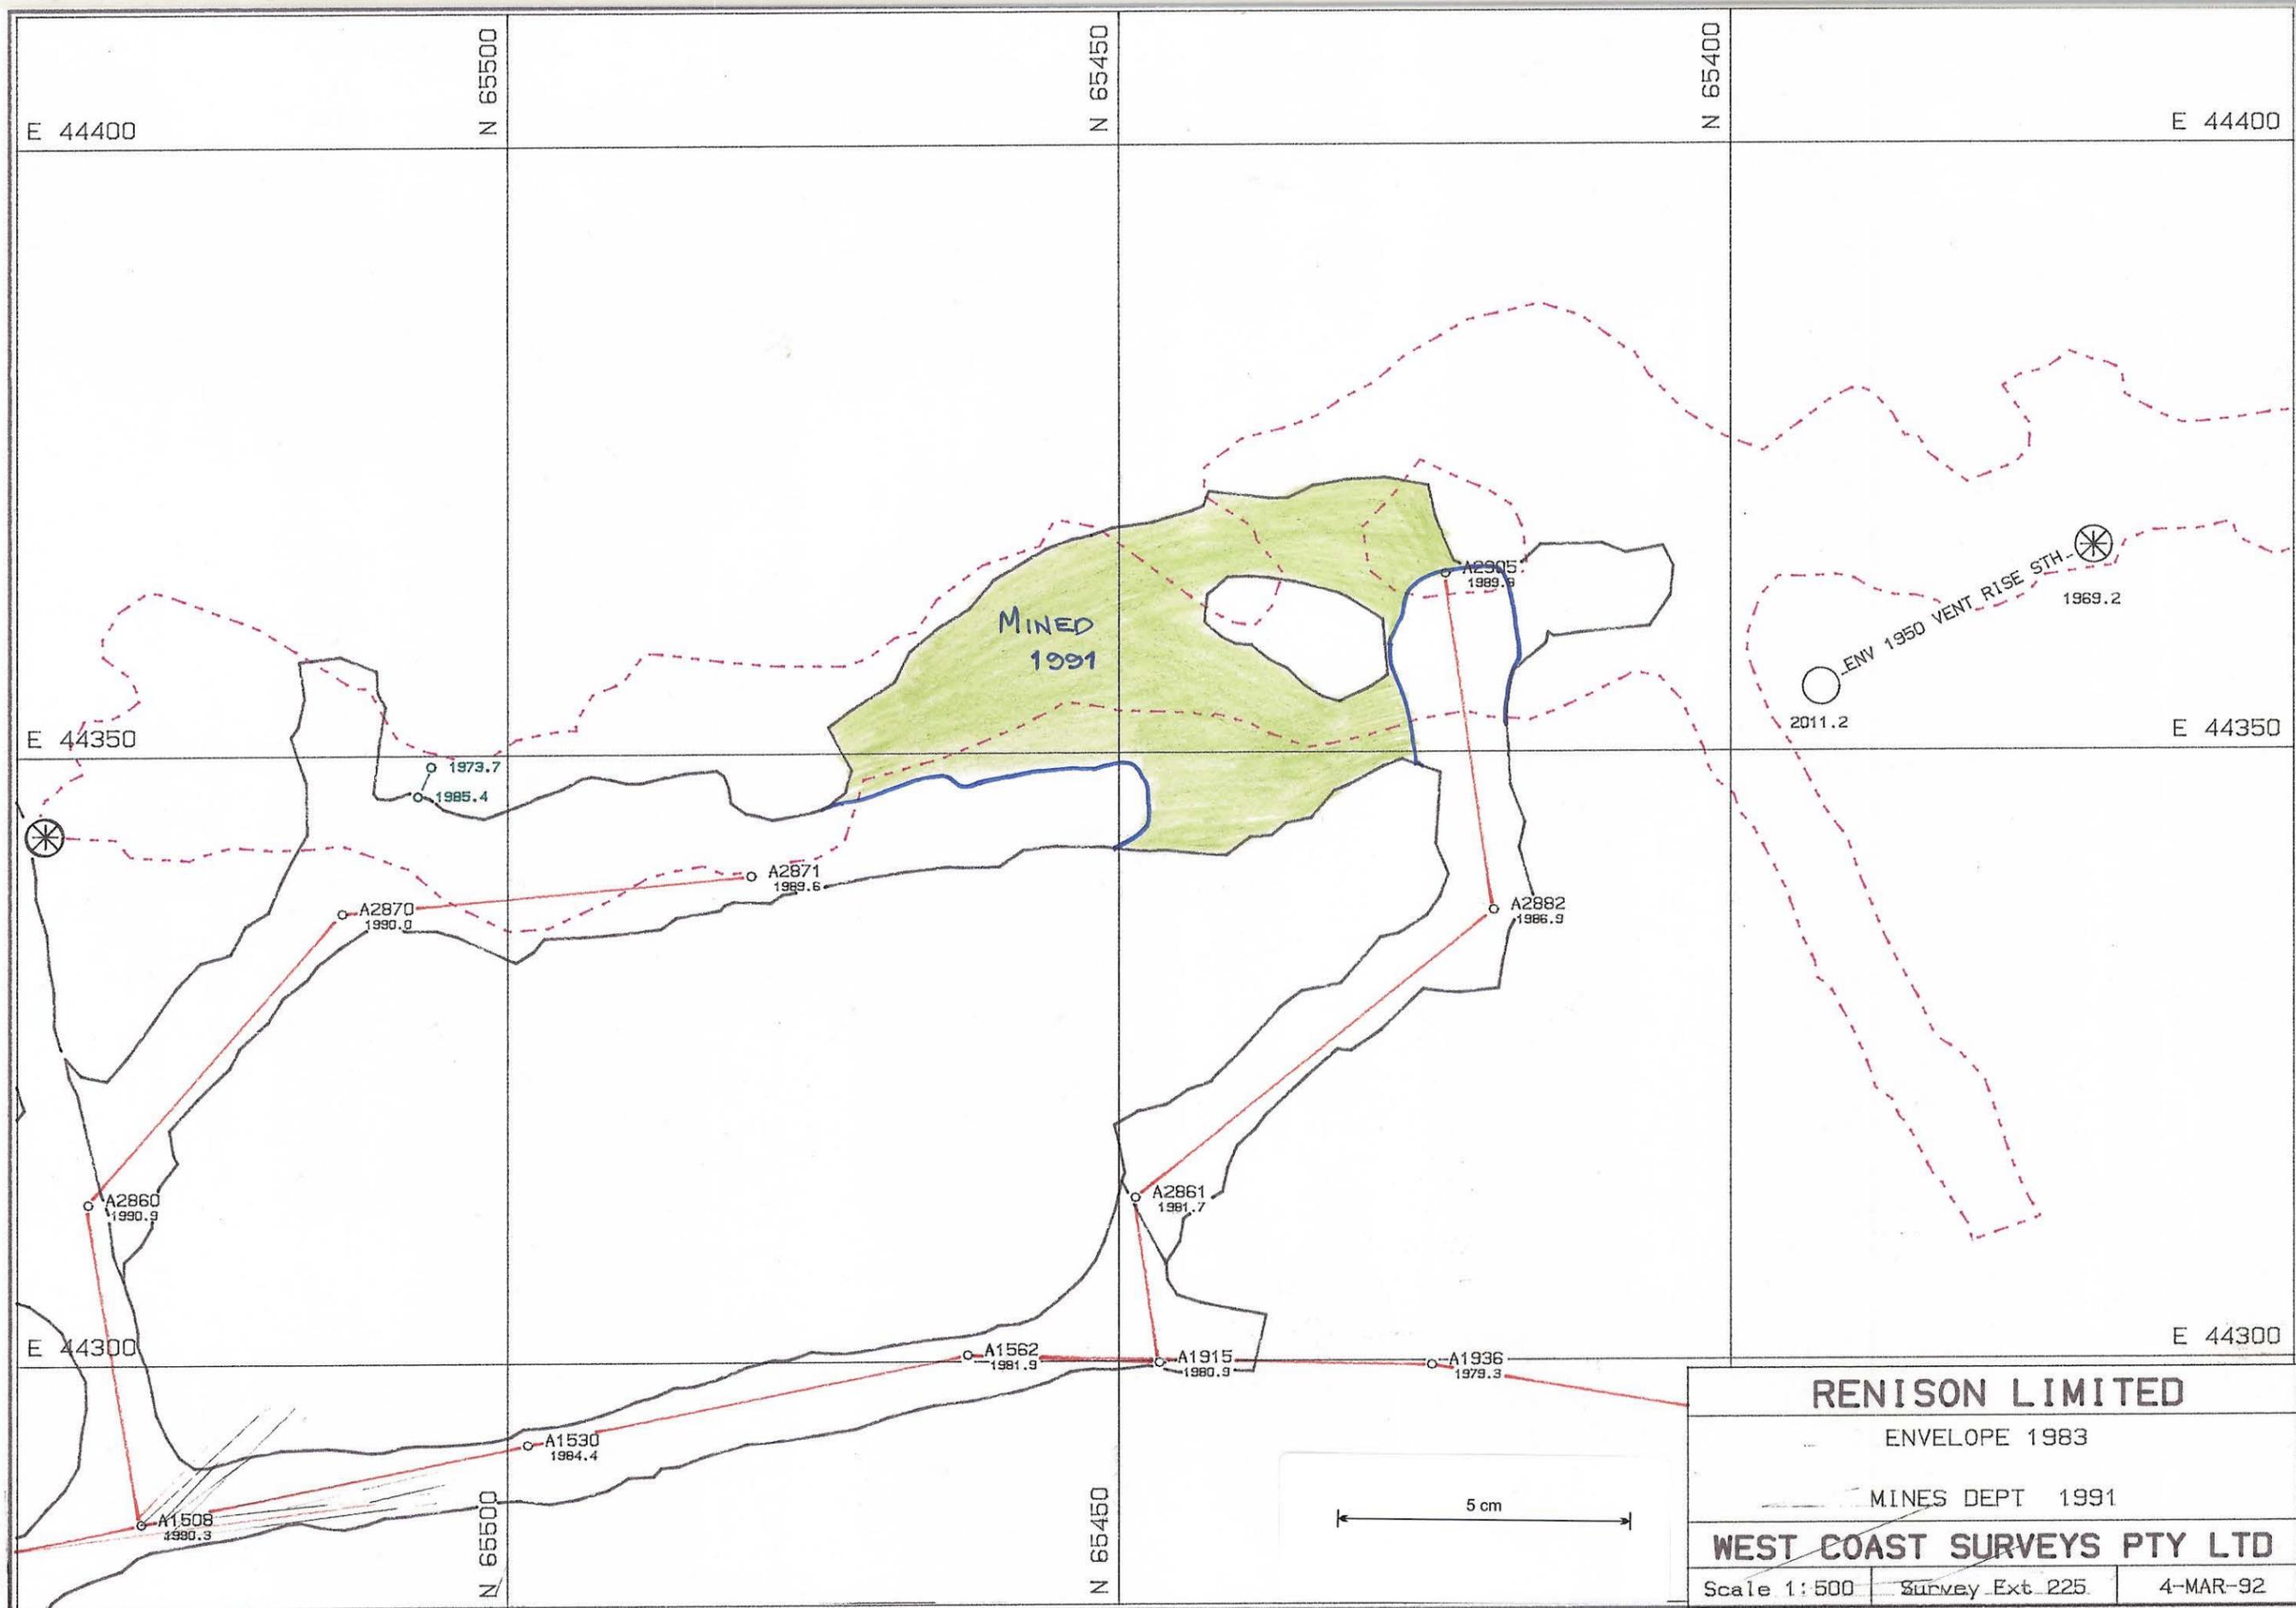

RENISON LIMITED		
— ENVELOPE 1983		
— MINES DEPT 1991		
WEST COAST SURVEYS PTY LTD		
Scale 1:500	Survey Ext 225	4-MAR-92

ENVEL.B.PF