


0376 - 076

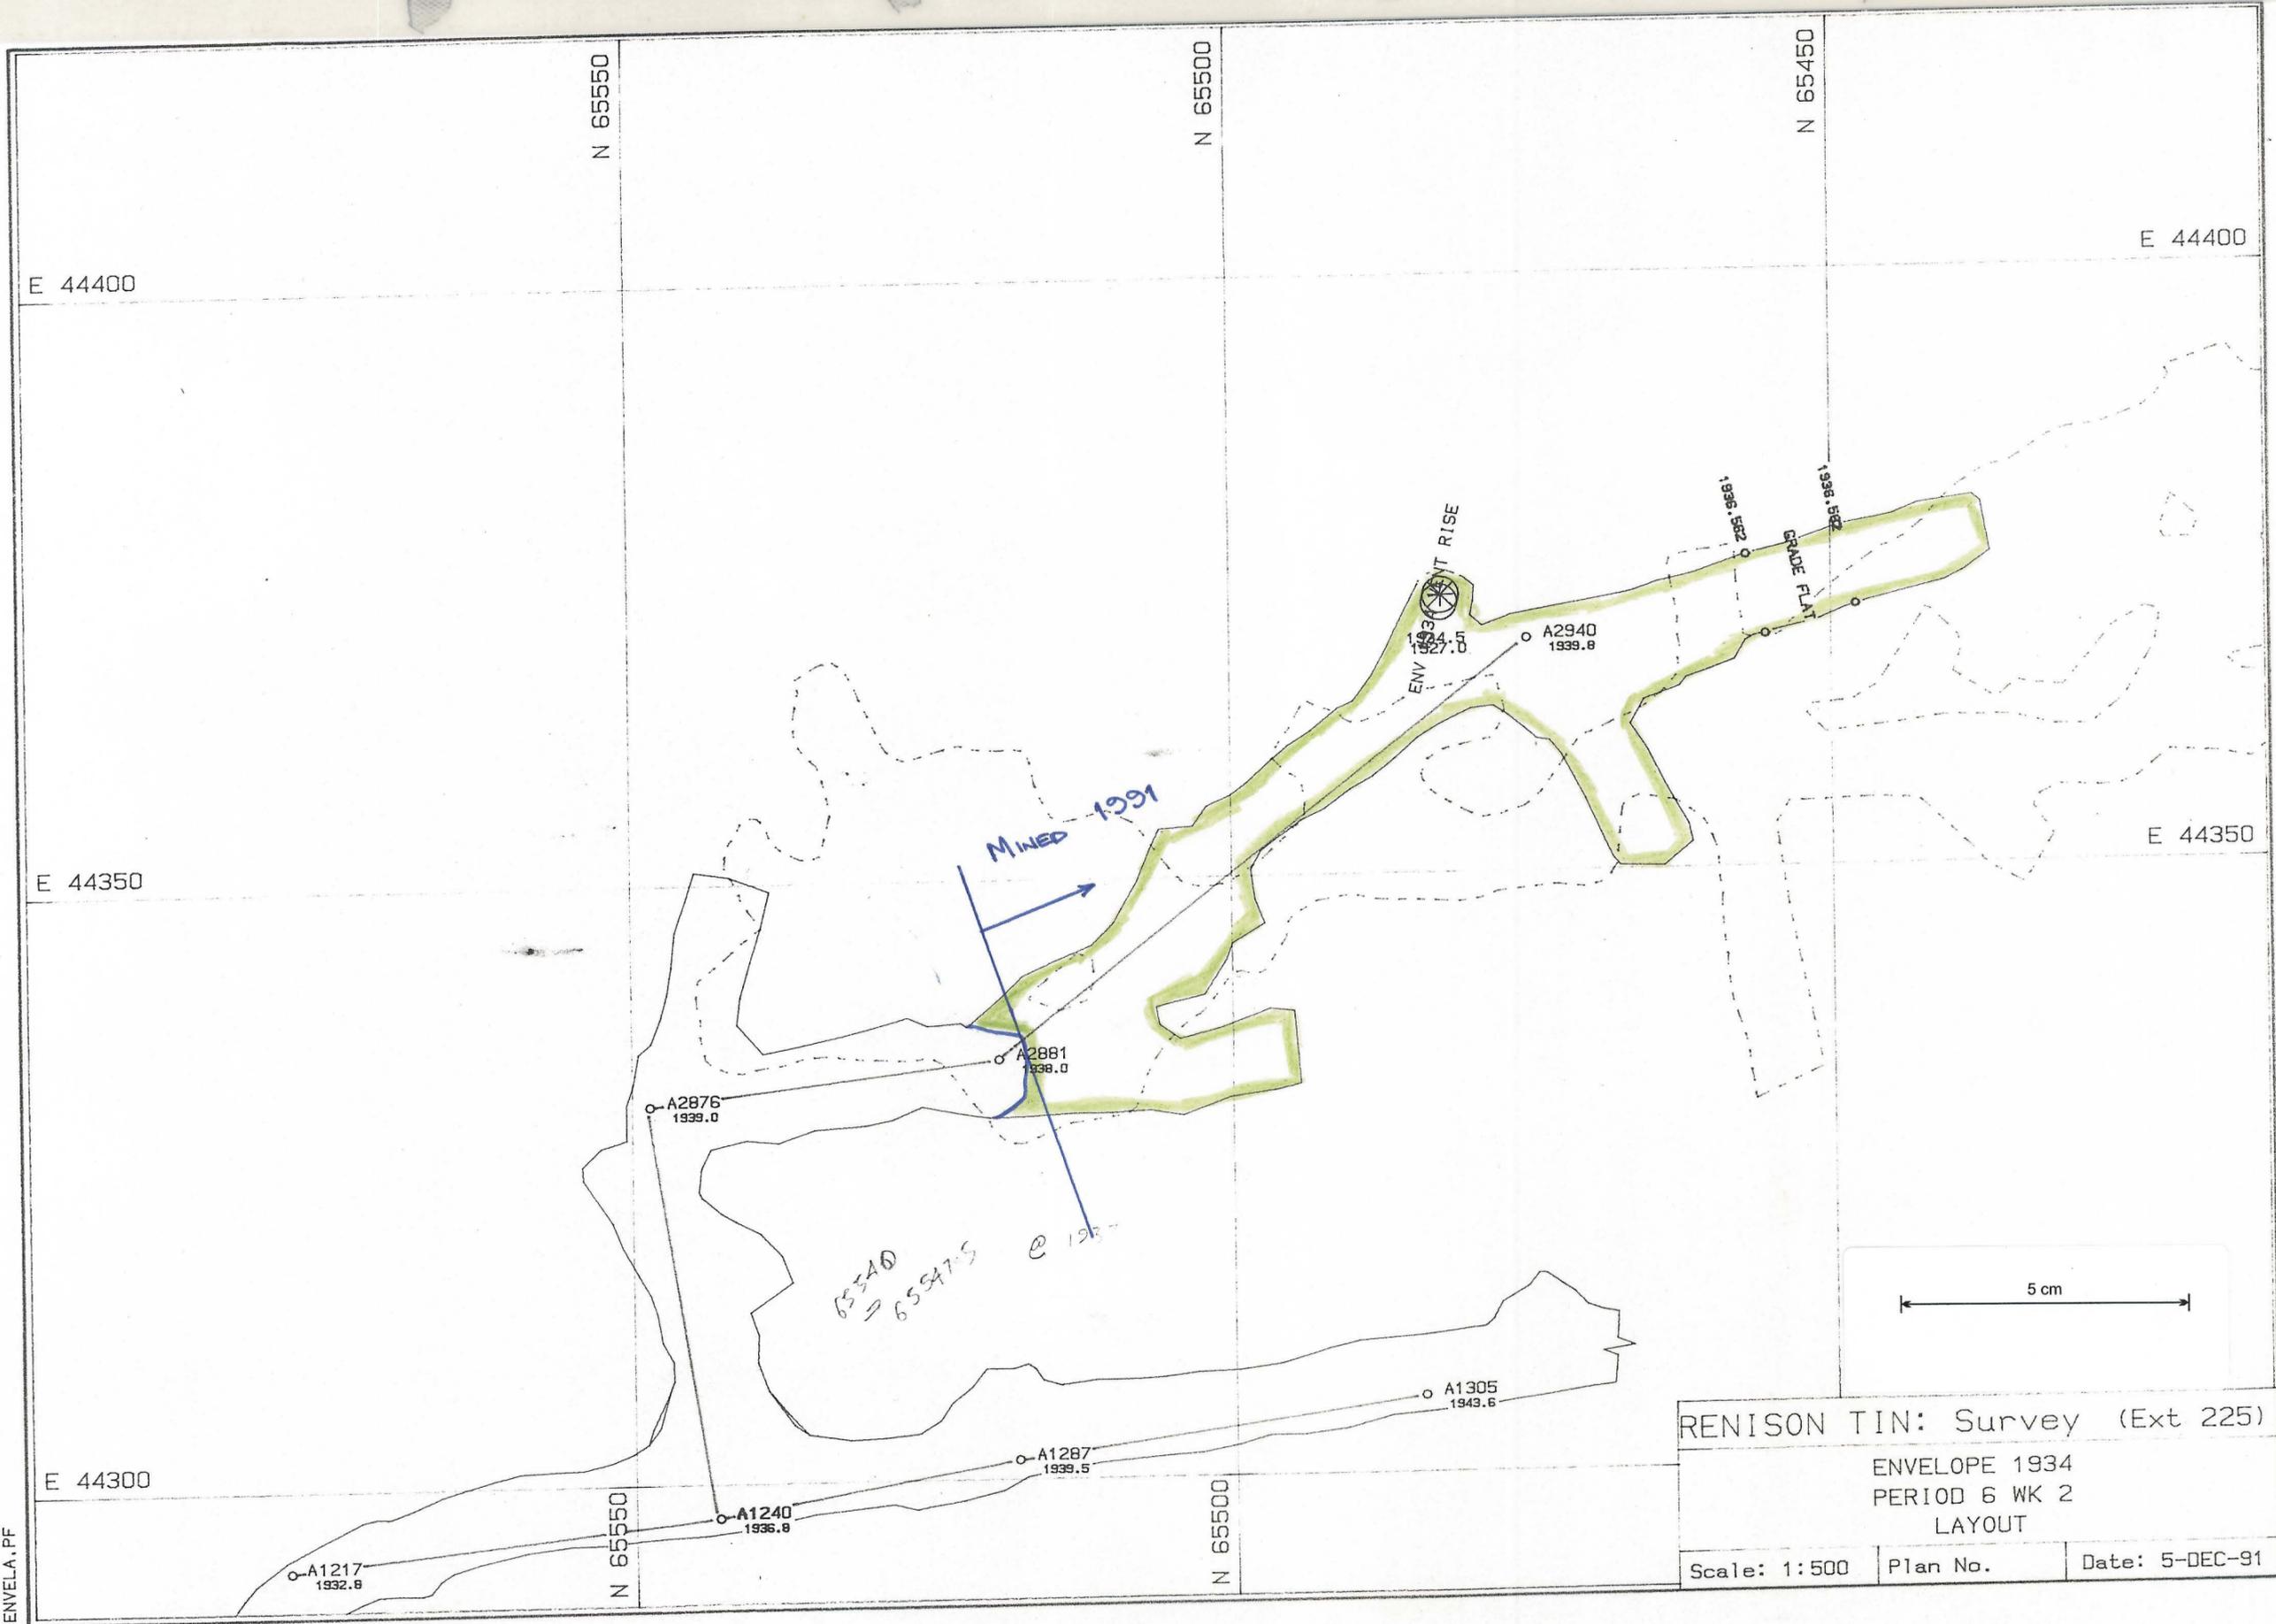

RENISON TIN: Survey (Ext 225)		
ENVELOPE 1934		
PERIOD 6 WK 2		
LAYOUT		
Scale: 1:500	Plan No.	Date: 5-DEC-91

ENVELA.PF