


0376-077

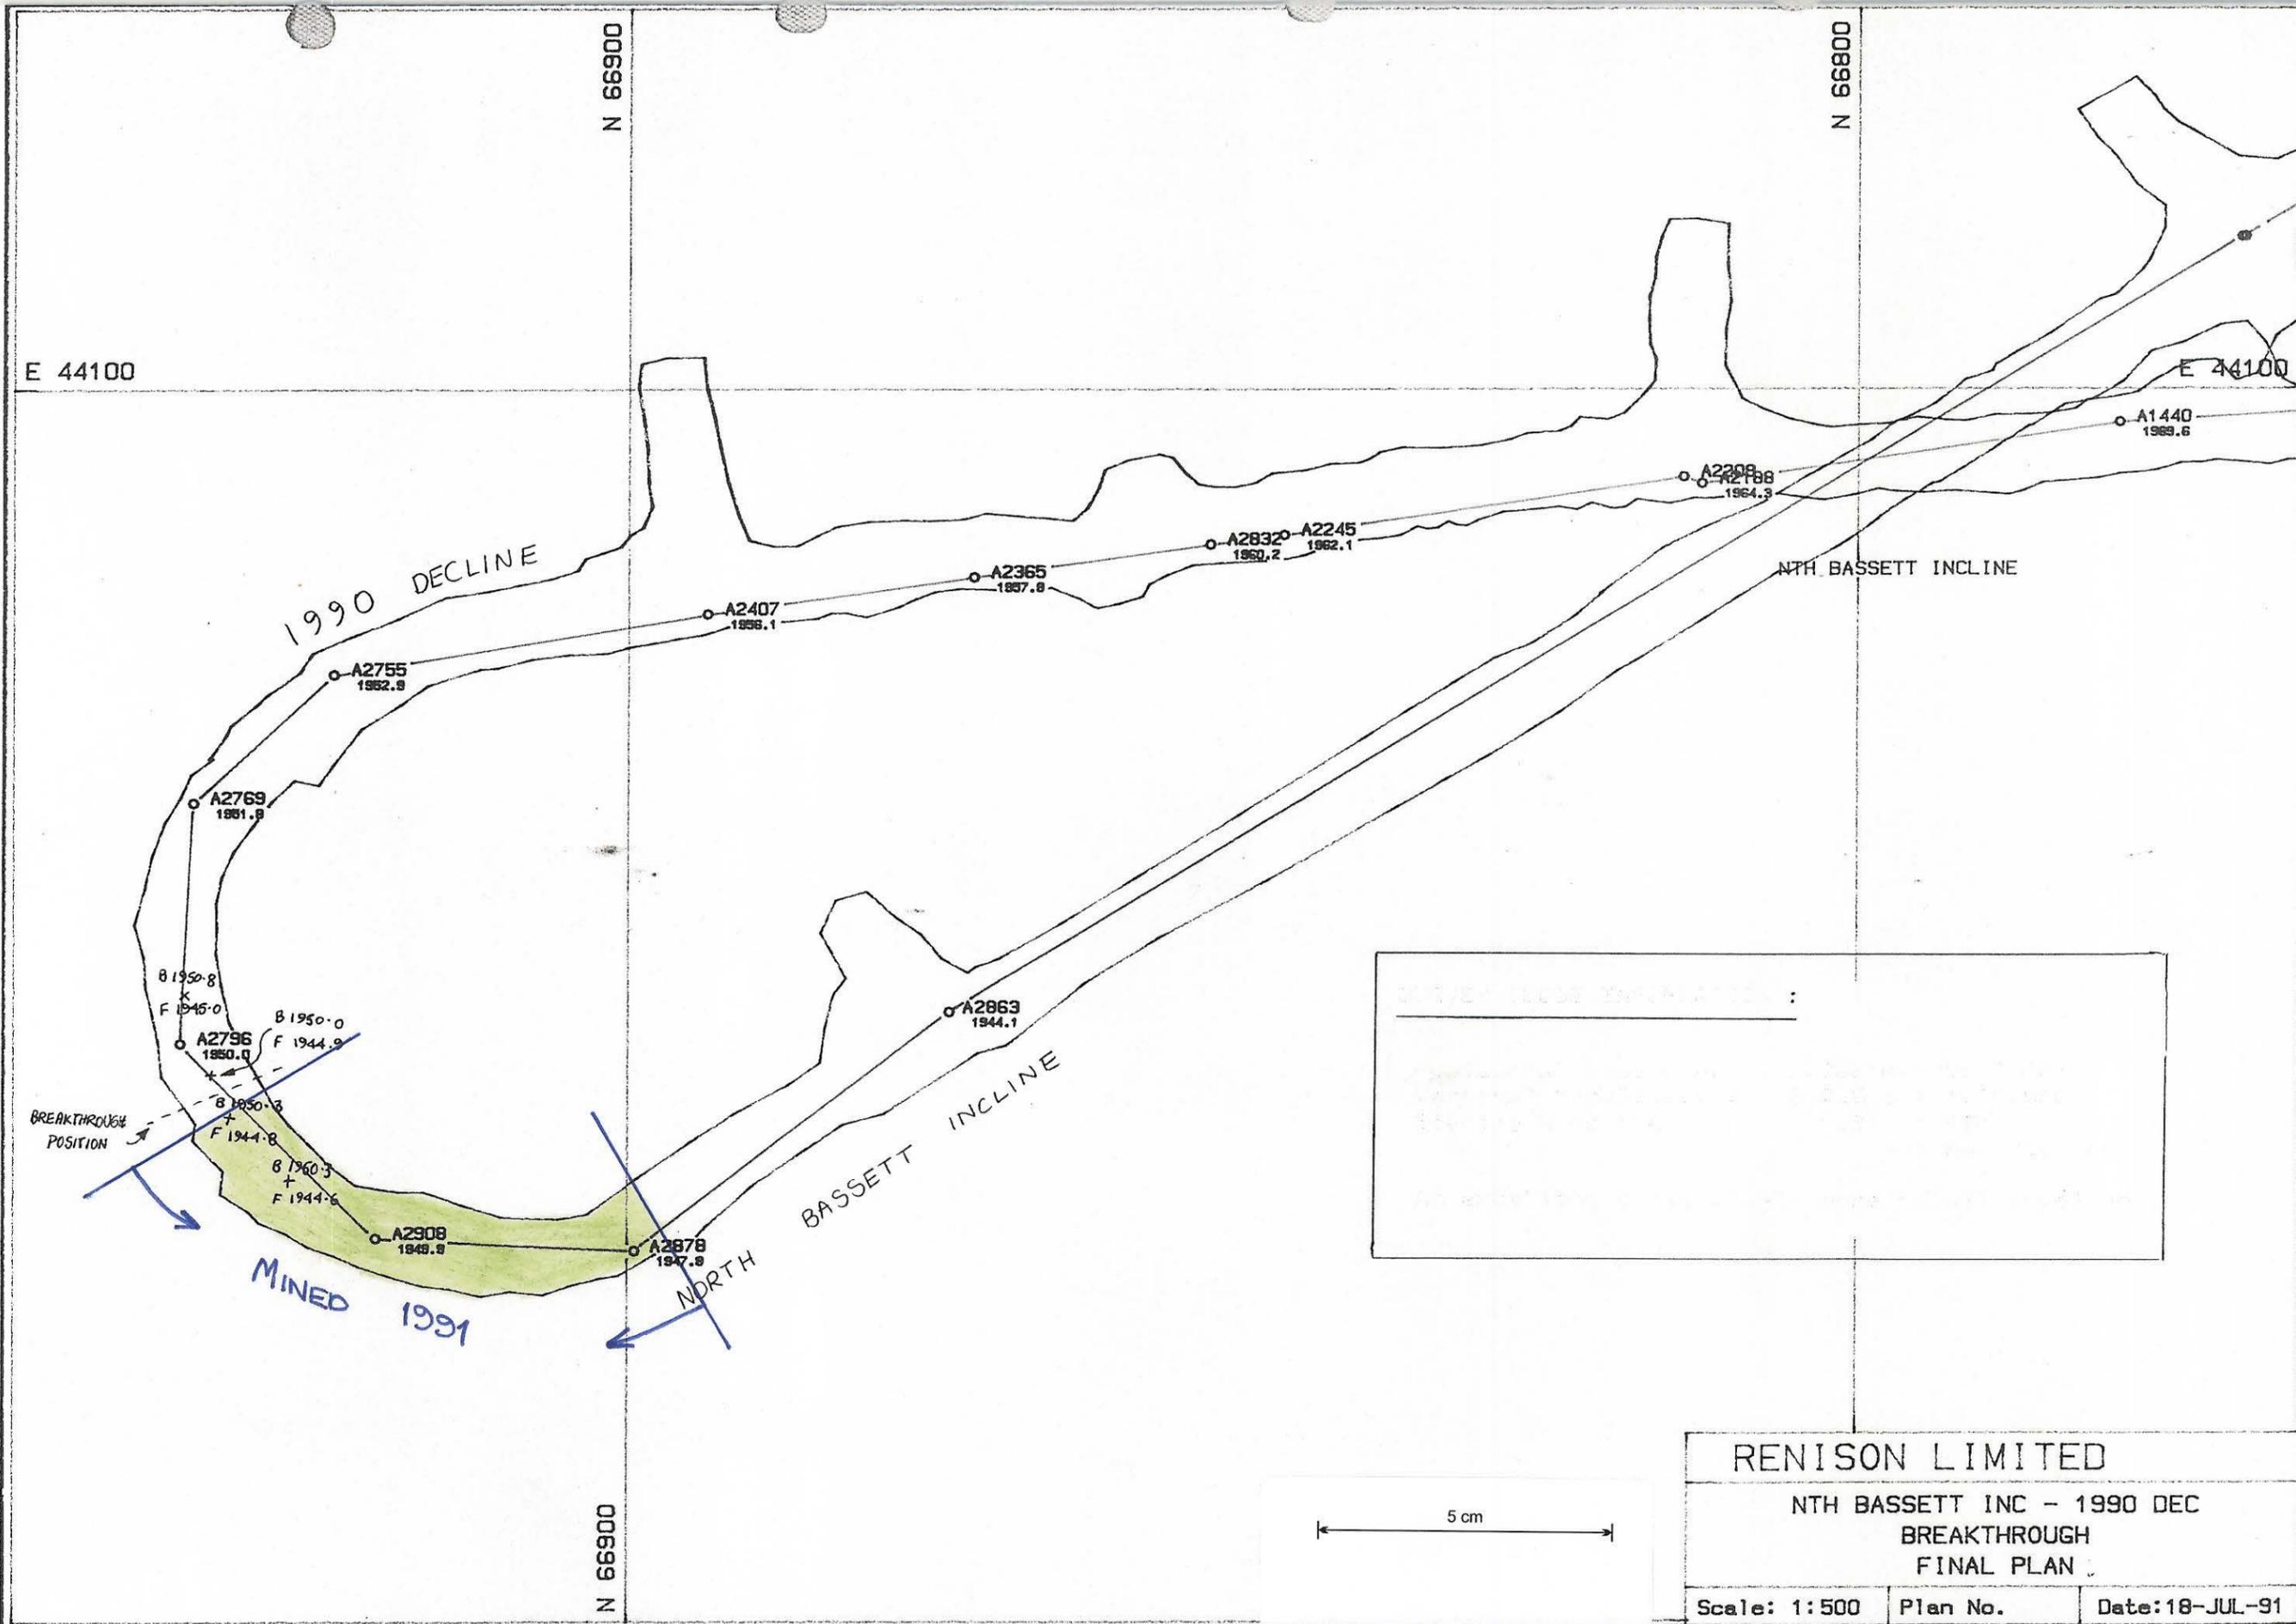

DATE OF THIS INFORMATION :

\_\_\_\_\_

\_\_\_\_\_

\_\_\_\_\_

\_\_\_\_\_

5 cm

RENISON LIMITED		
NTH BASSETT INC - 1990 DEC BREAKTHROUGH FINAL PLAN		
Scale: 1:500	Plan No.	Date: 18-JUL-91

BTHRUB.PF