
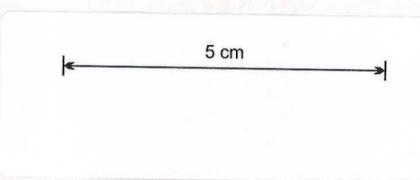


0376 - 078

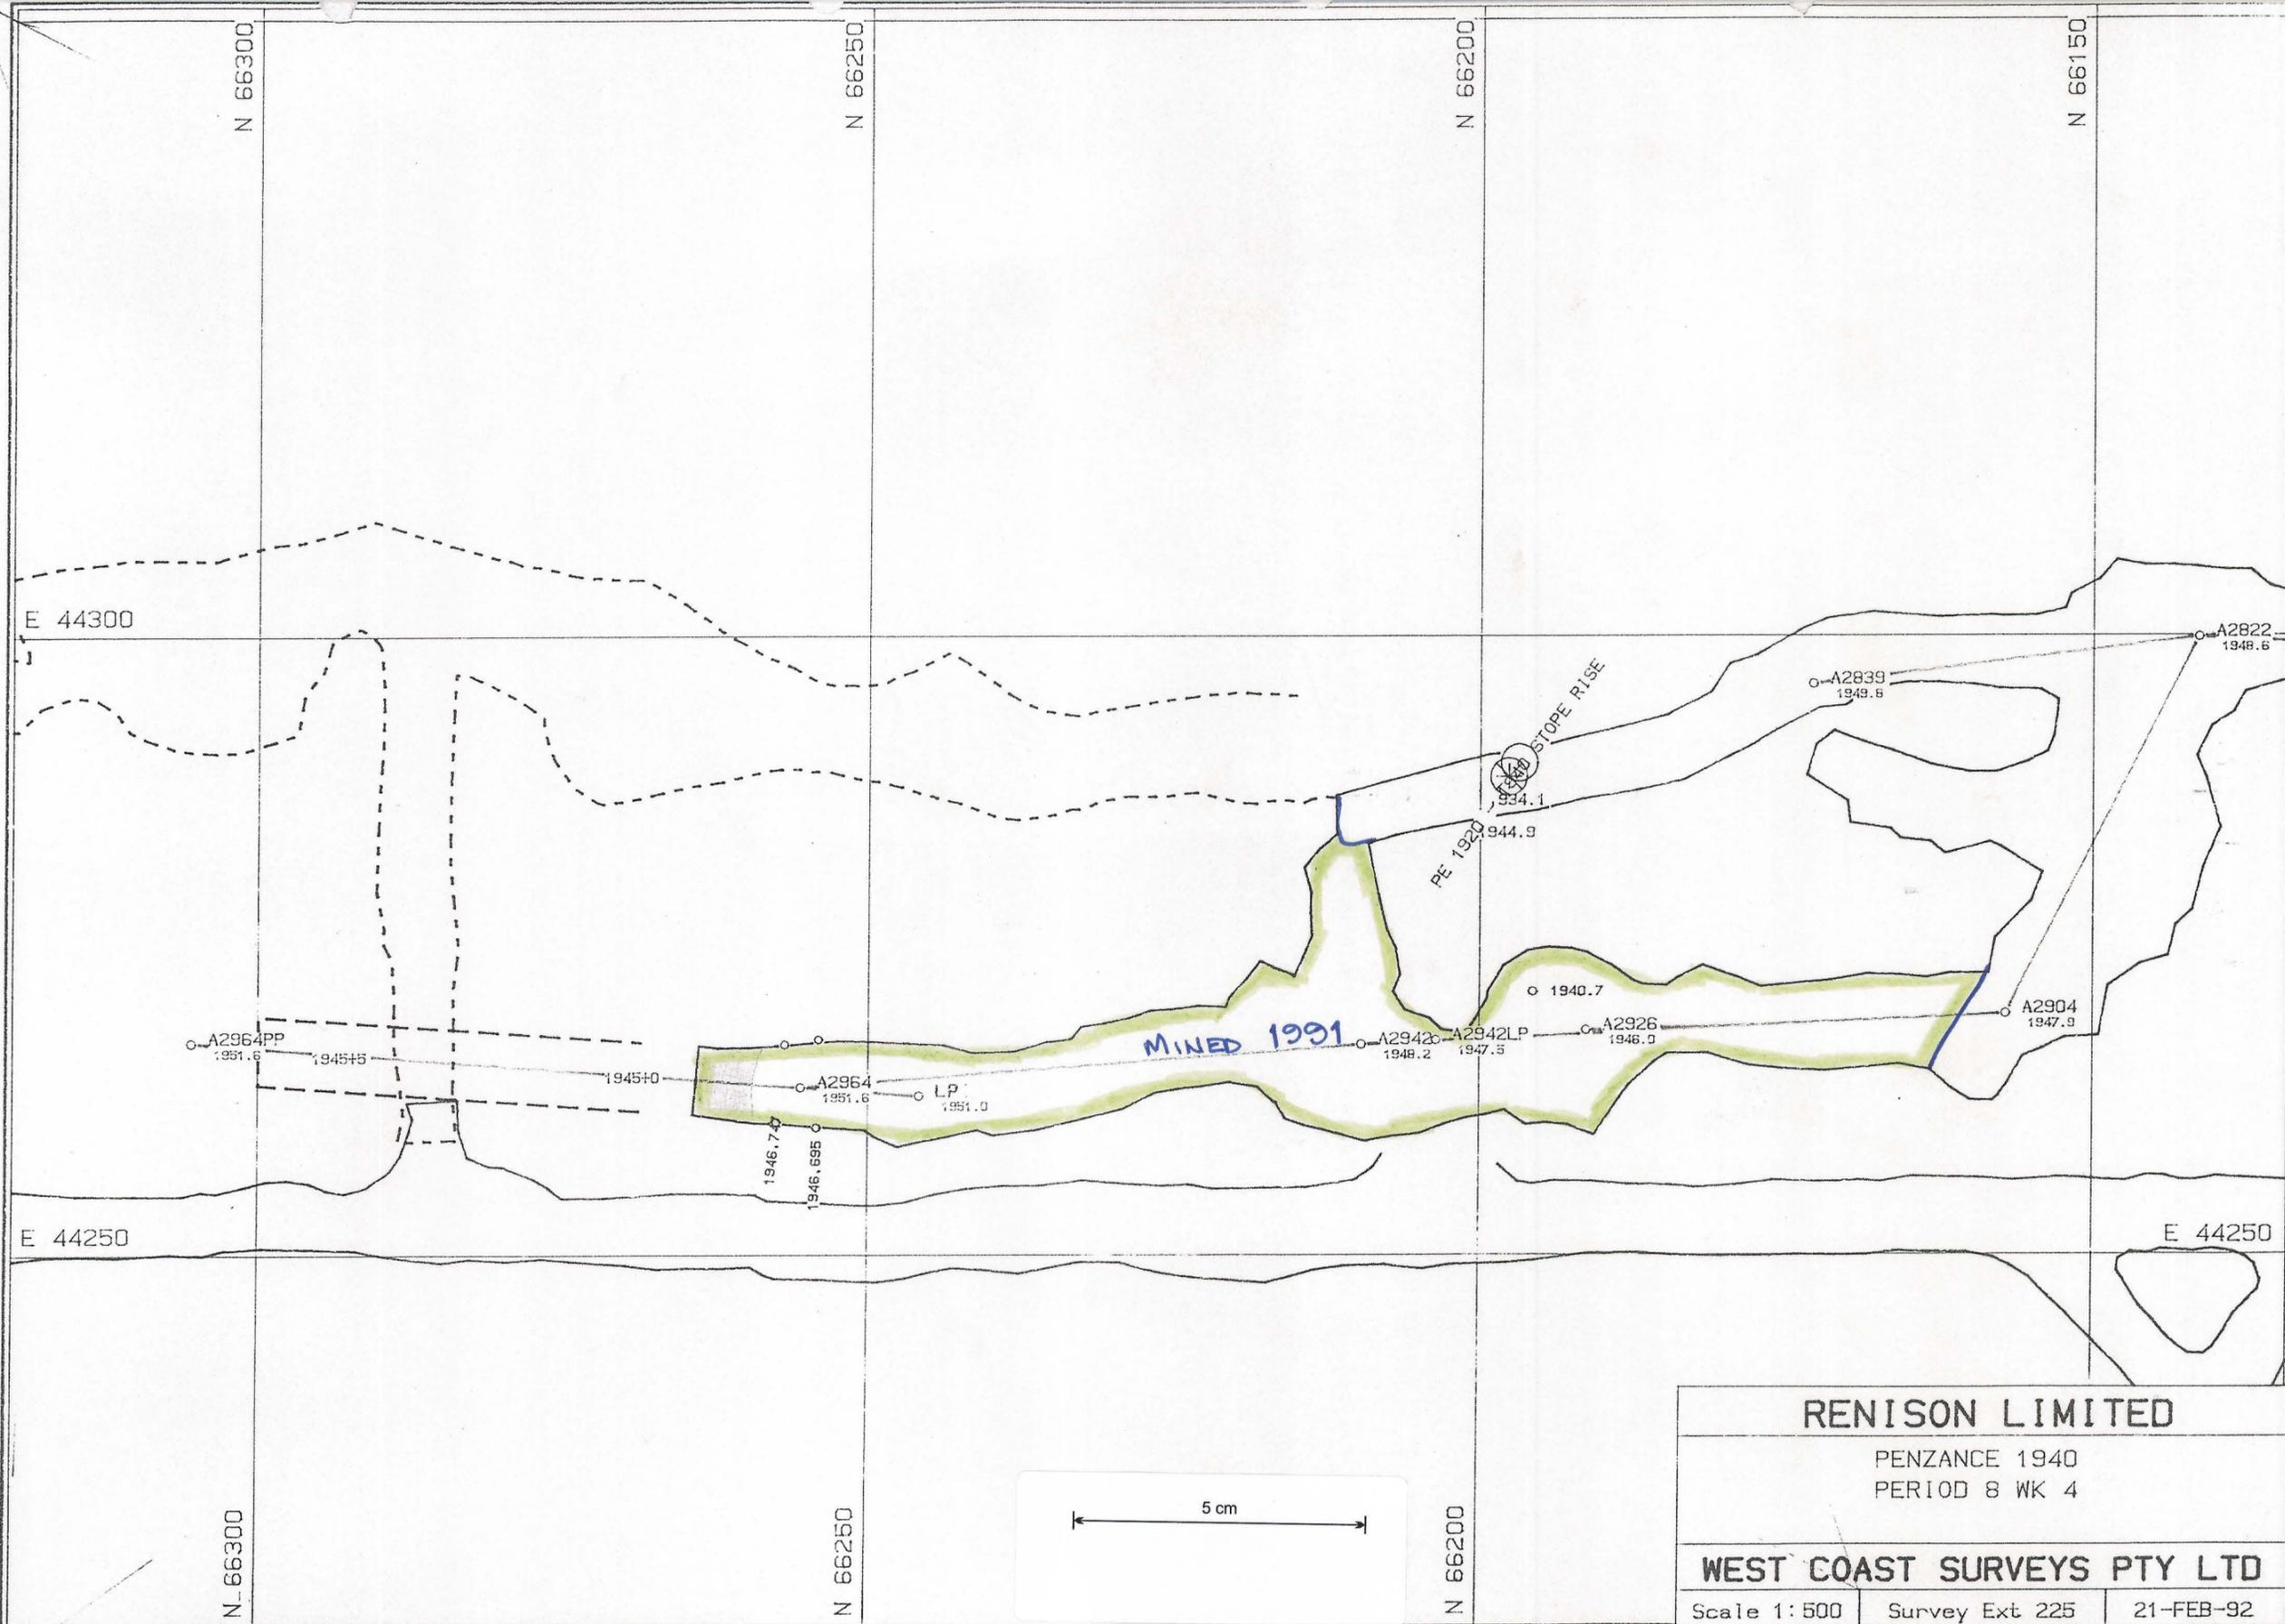

RENISON LIMITED		
PENZANCE 1940 PERIOD 8 WK 4		
WEST COAST SURVEYS PTY LTD		
Scale 1:500	Survey Ext 225	21-FEB-92