


0376-079

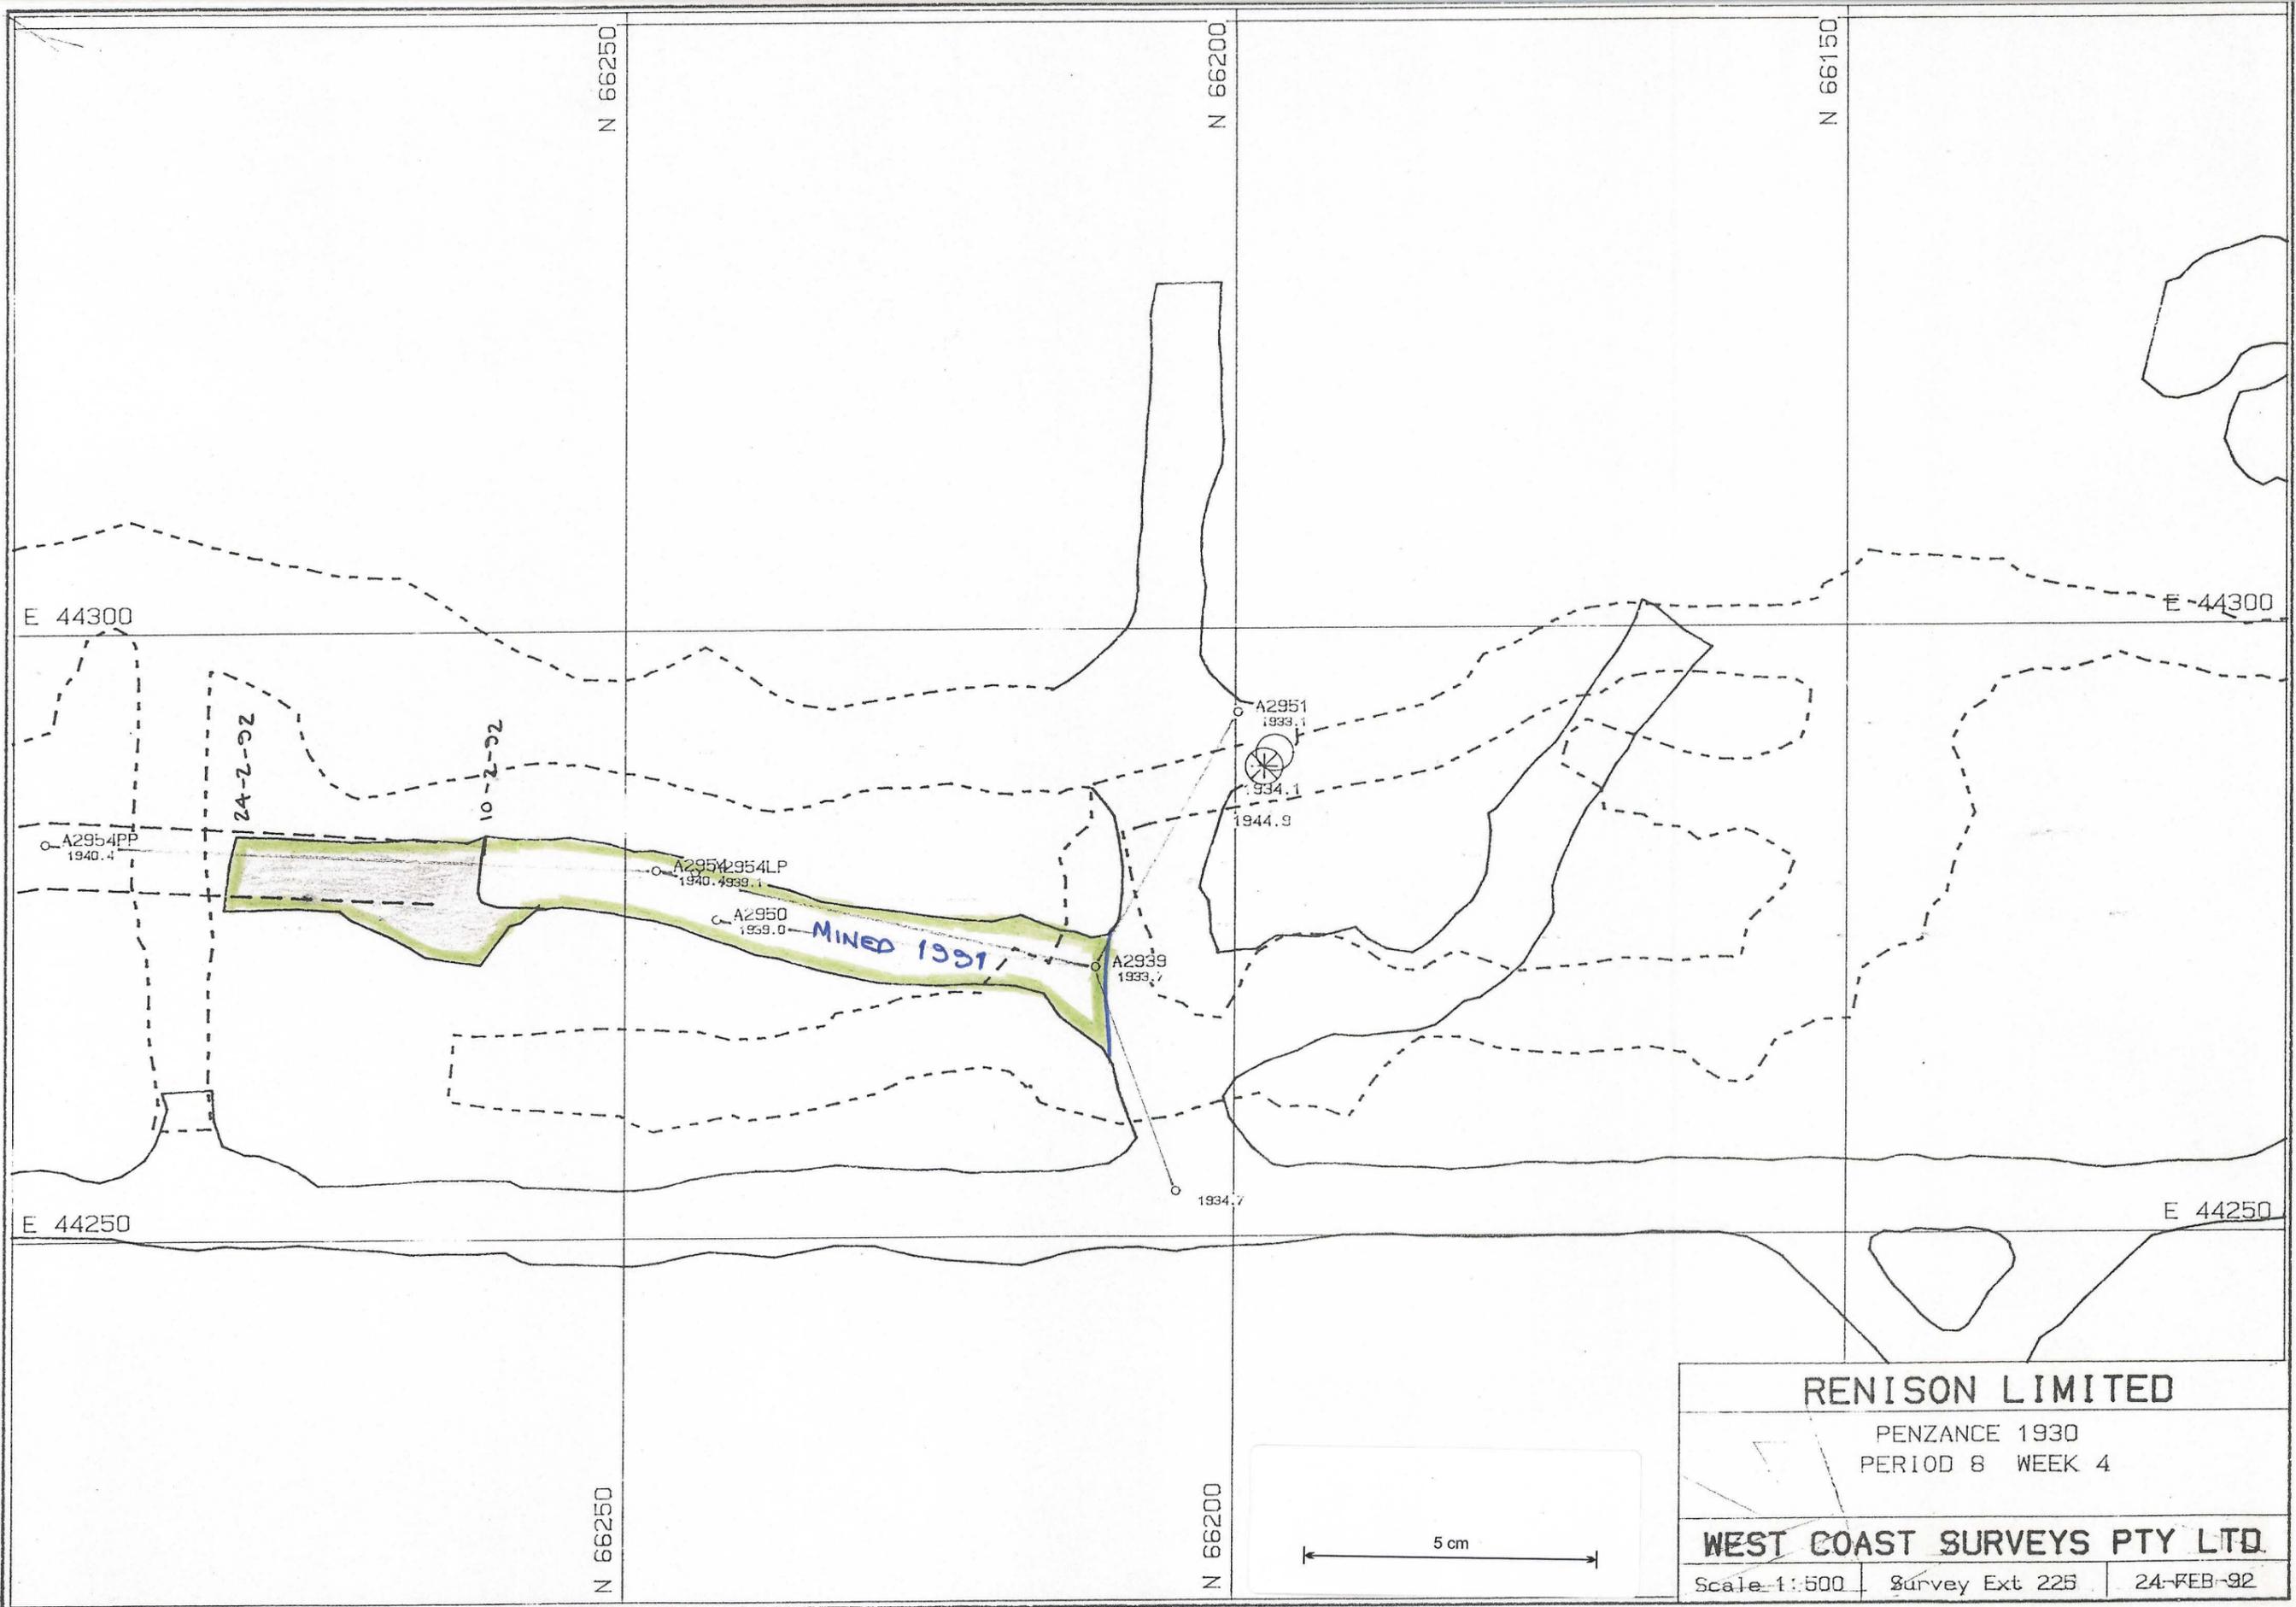

RENISON LIMITED

PENZANCE 1930
PERIOD 8 WEEK 4

WEST COAST SURVEYS PTY LTD

Scale 1:500 | Survey Ext 225 | 24-FEB-92

5 cm

PENZAB.PF