


0376 - 080

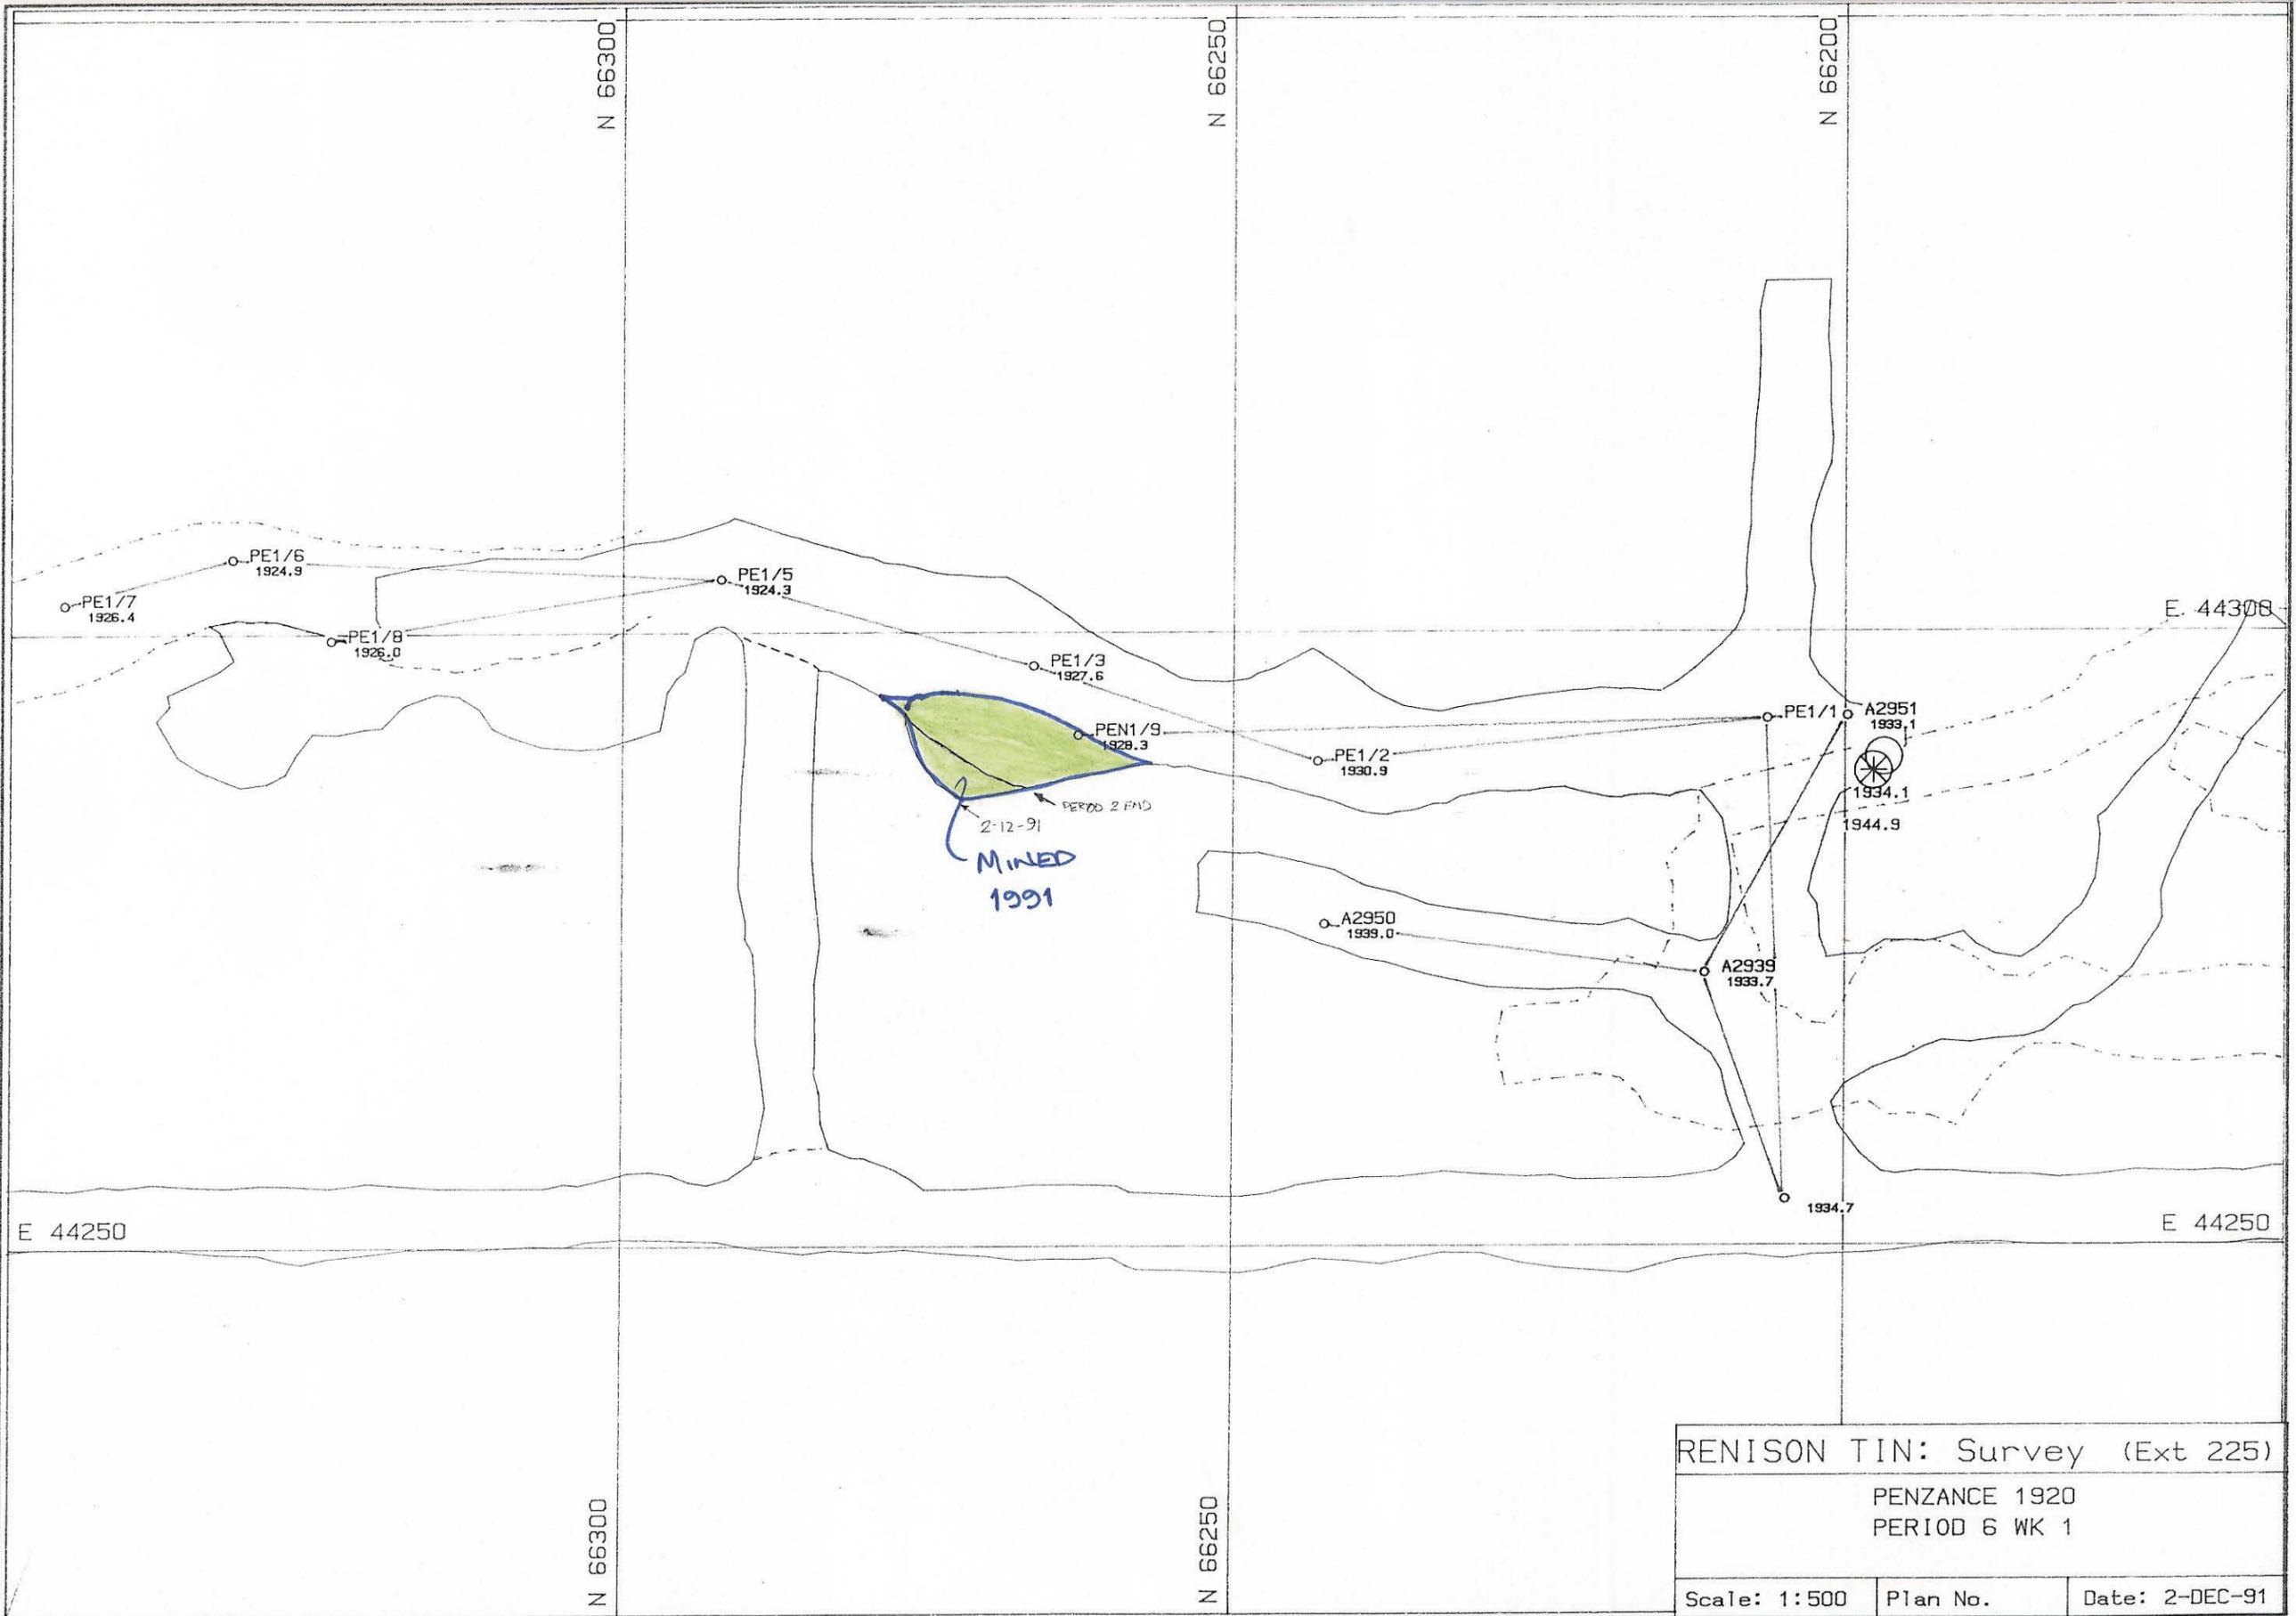

RENISON TIN: Survey (Ext 225)		
PENANCE 1920		
PERIOD 6 WK 1		
Scale: 1:500	Plan No.	Date: 2-DEC-91

K-PENZAB.PF