


0376 - 081

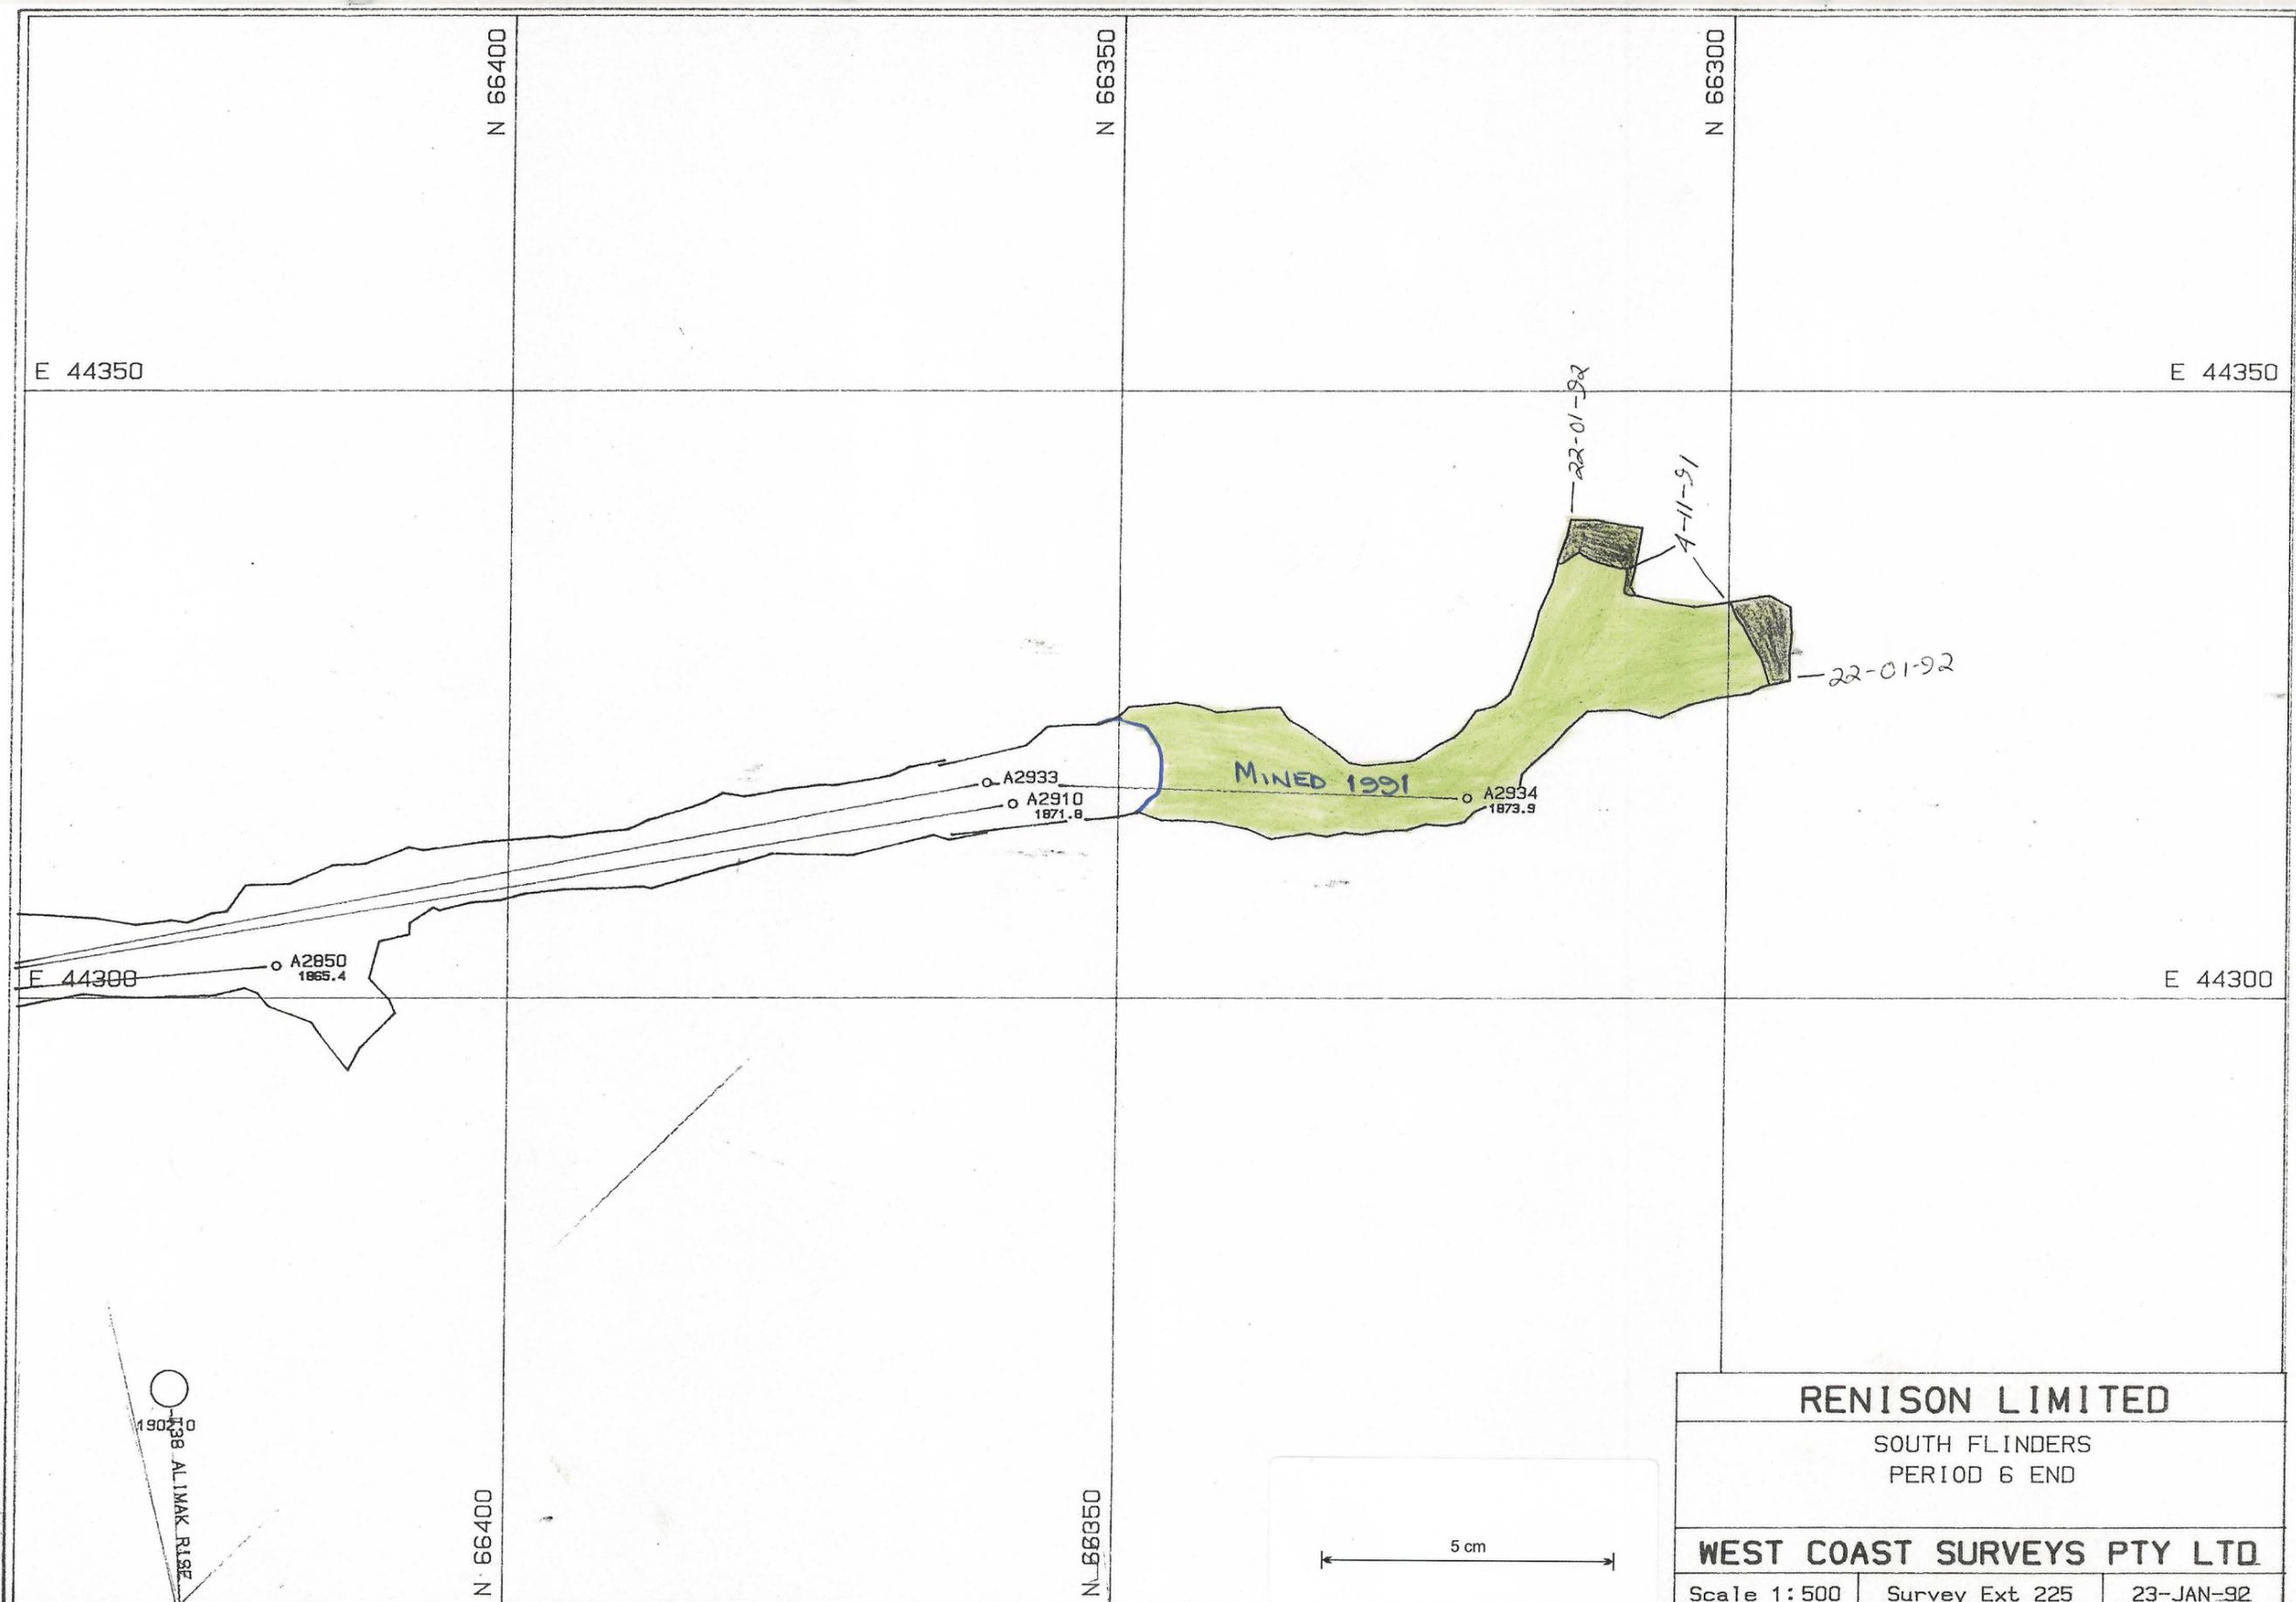

| | | |
|-----------------------------------|----------------|-----------|
| RENISON LIMITED | | |
| SOUTH FLINDERS PERIOD 6 END | | |
| WEST COAST SURVEYS PTY LTD | | |
| Scale 1:500 | Survey Ext 225 | 23-JAN-92 |