


0376-082

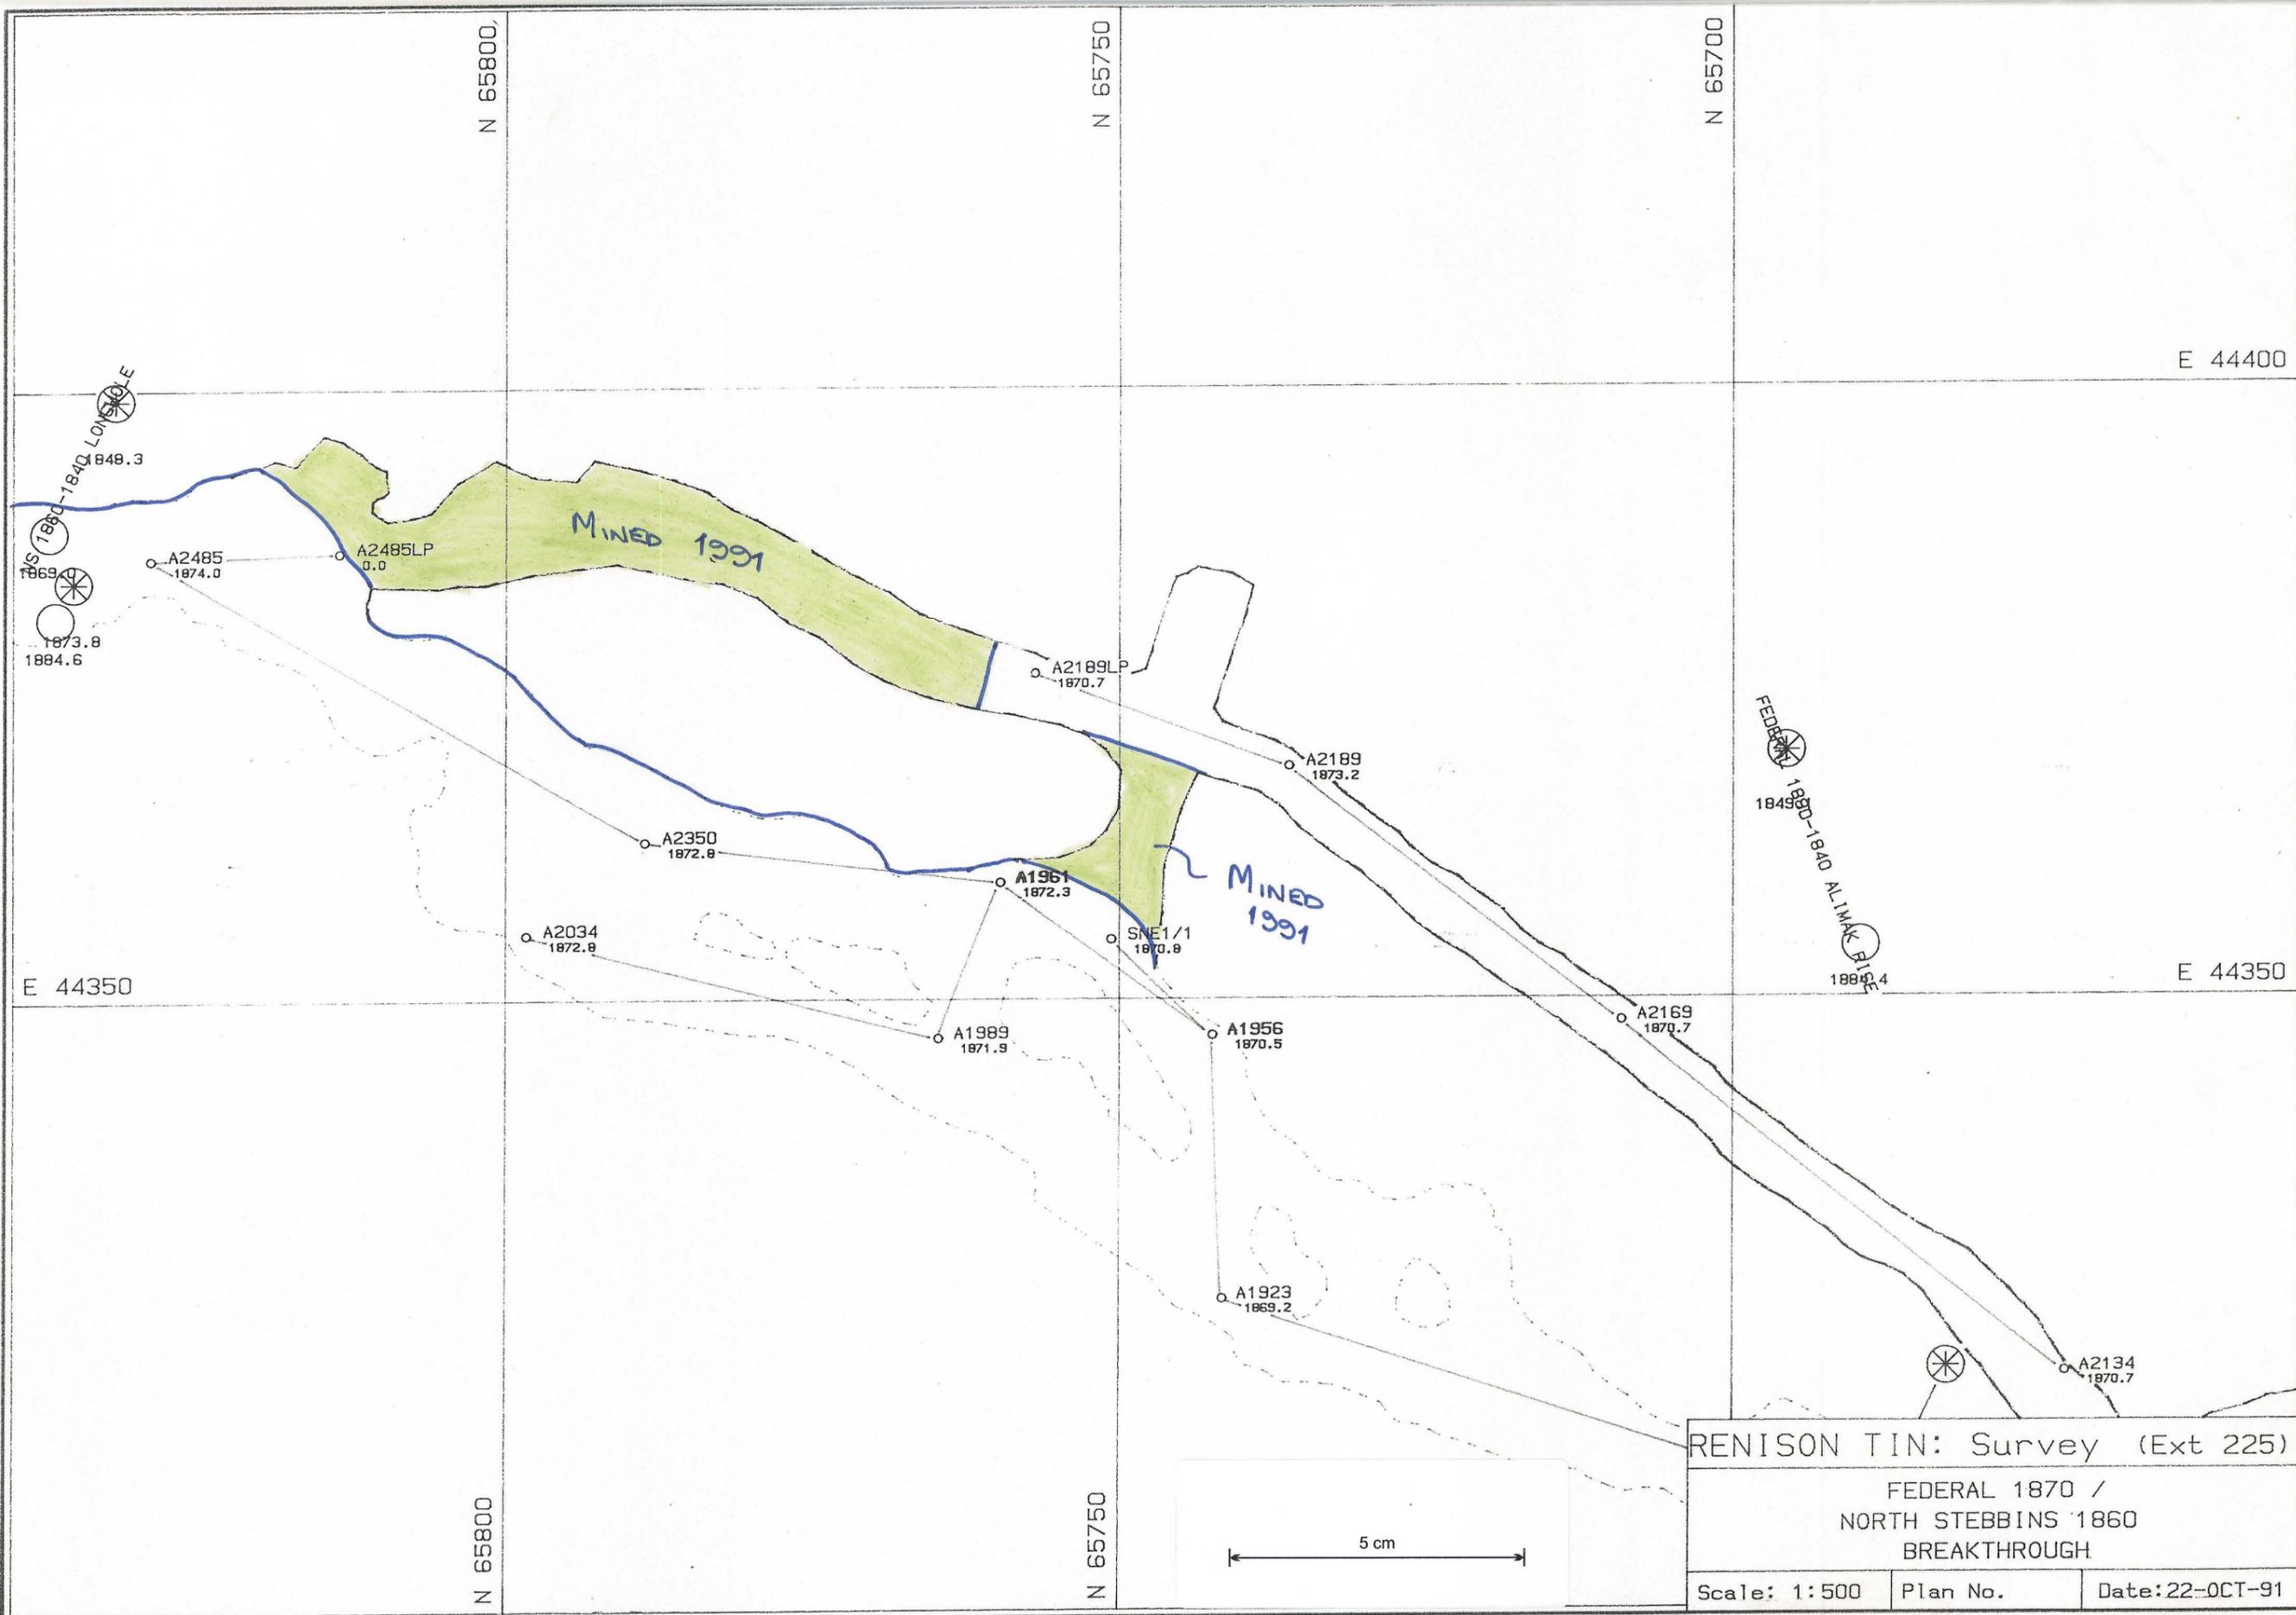

RENISON TIN: Survey (Ext 225)

FEDERAL 1870 /  
NORTH STEBBINS 1860  
BREAKTHROUGH

Scale: 1:500	Plan No.	Date: 22-OCT-91
--------------	----------	-----------------

FEDERC.PF