


0376-083

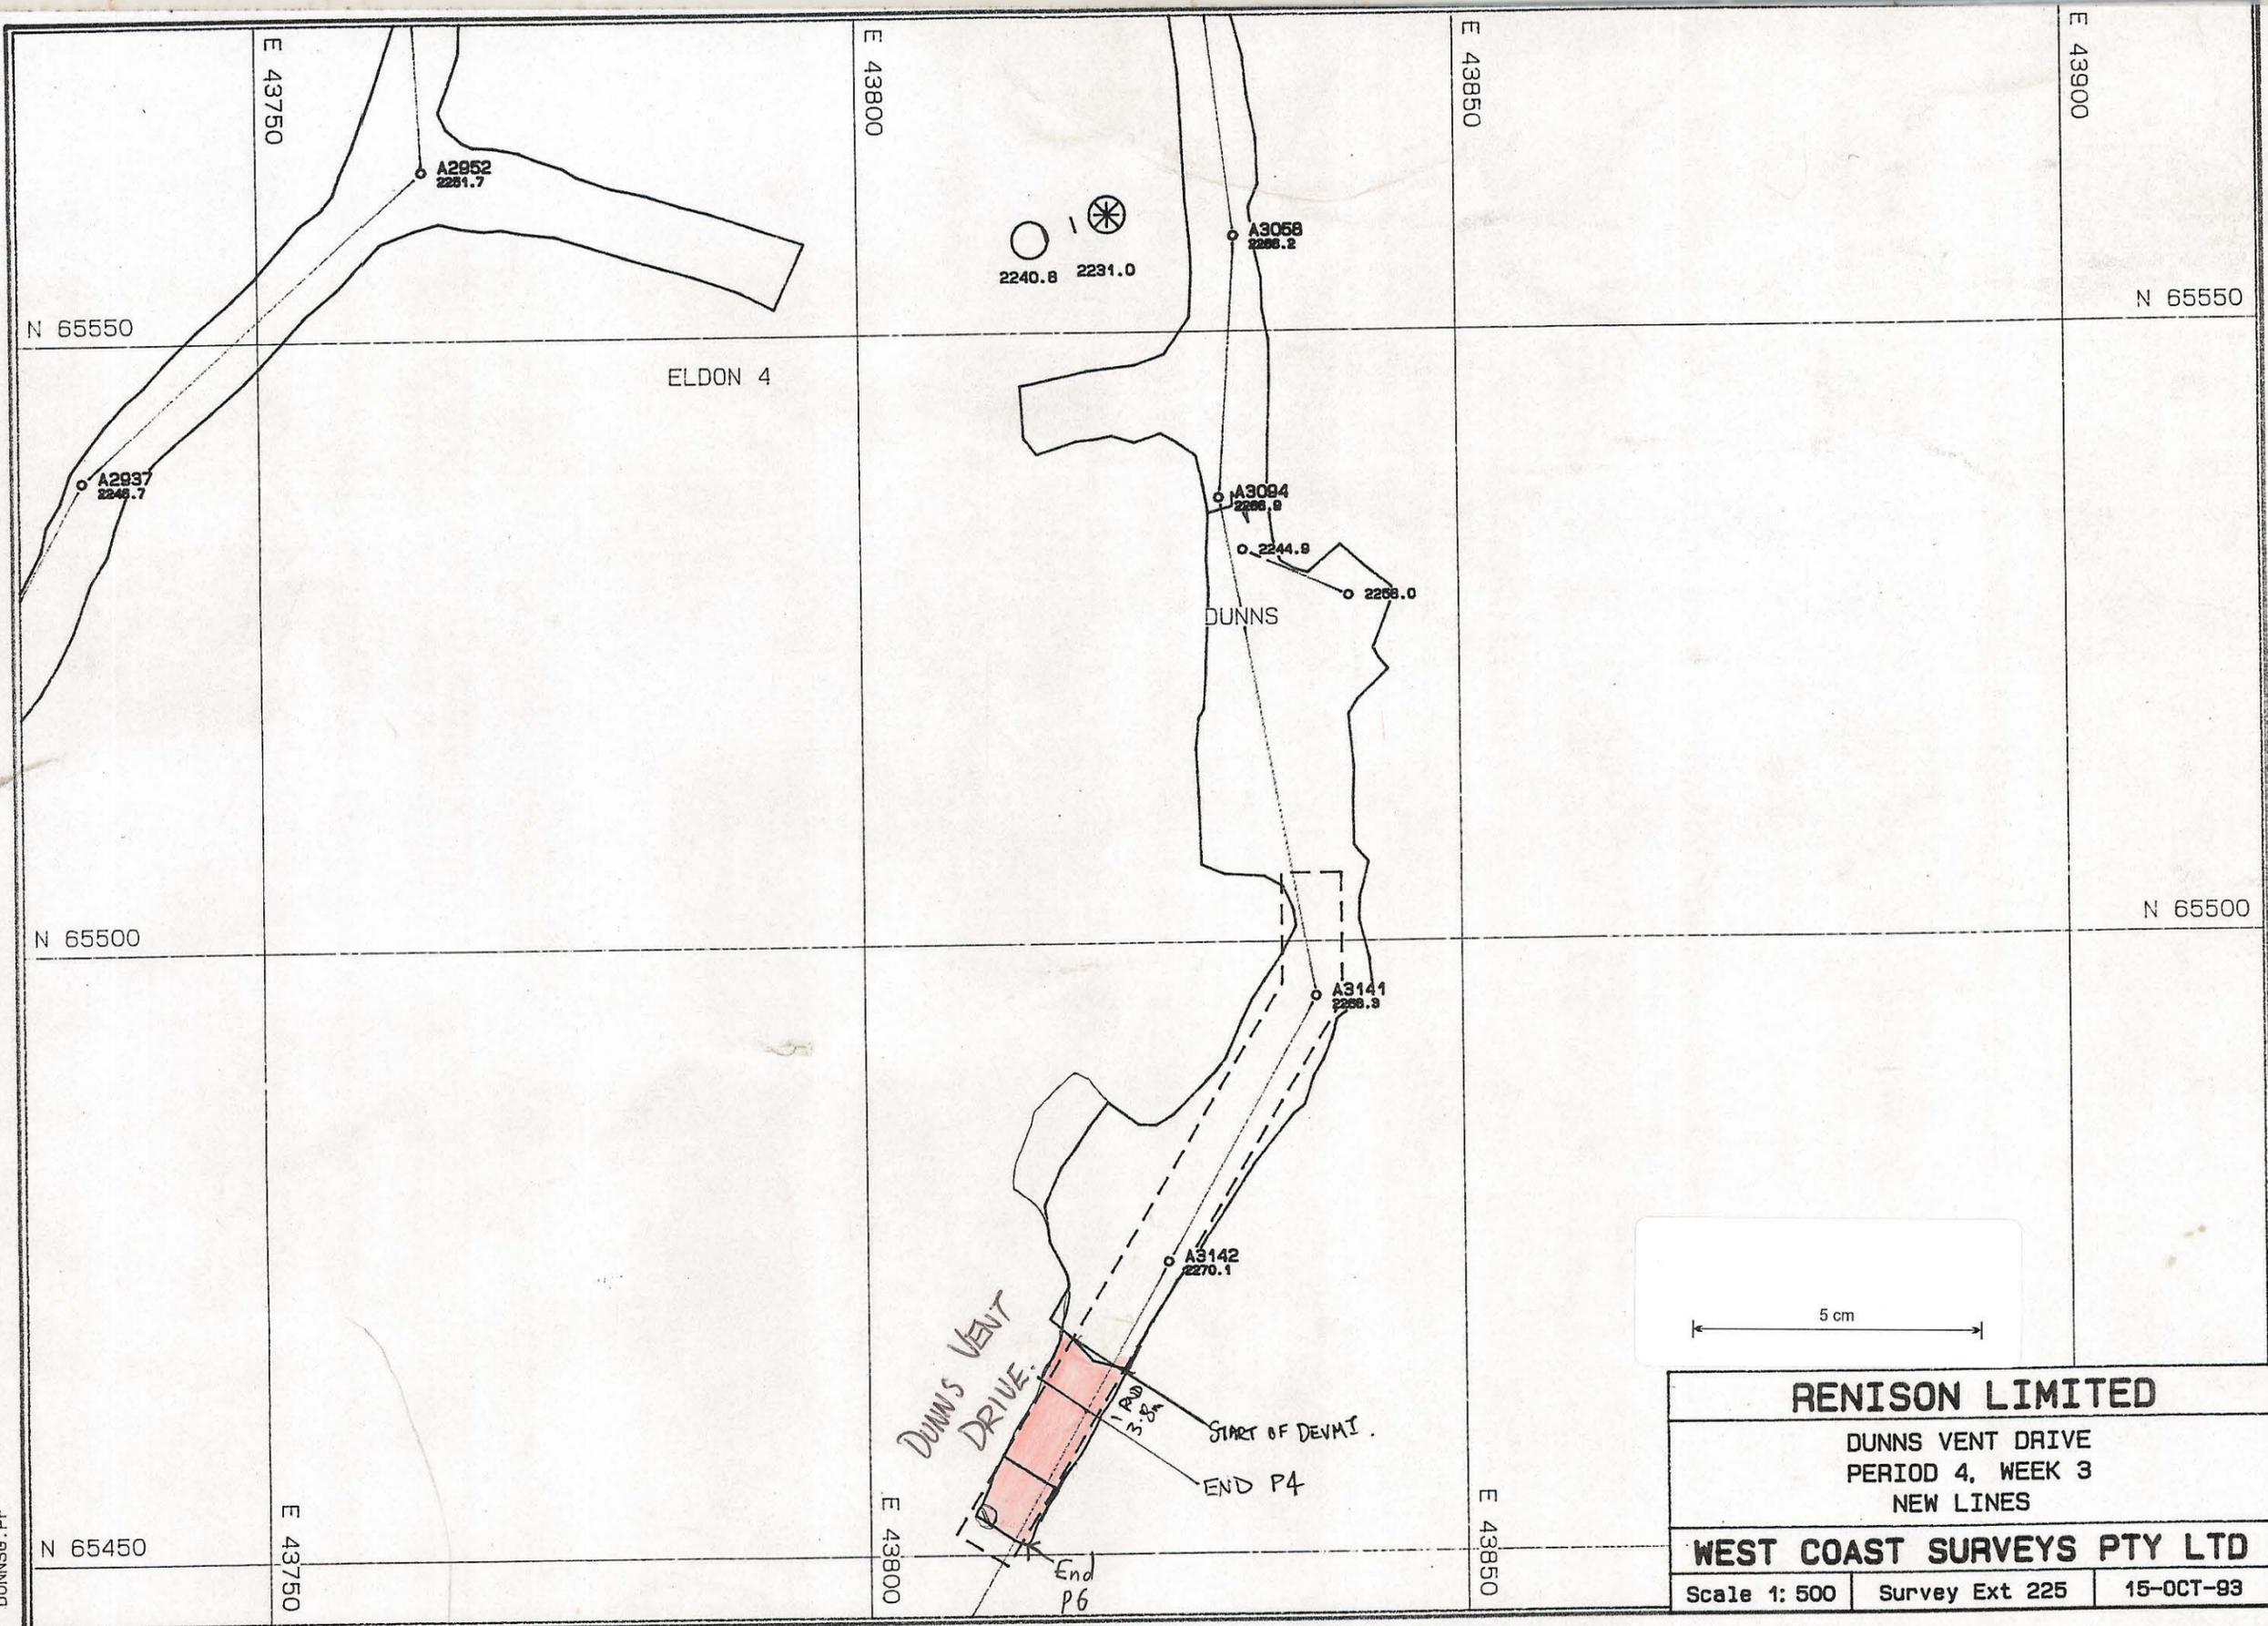

DUNNSG.PF

K